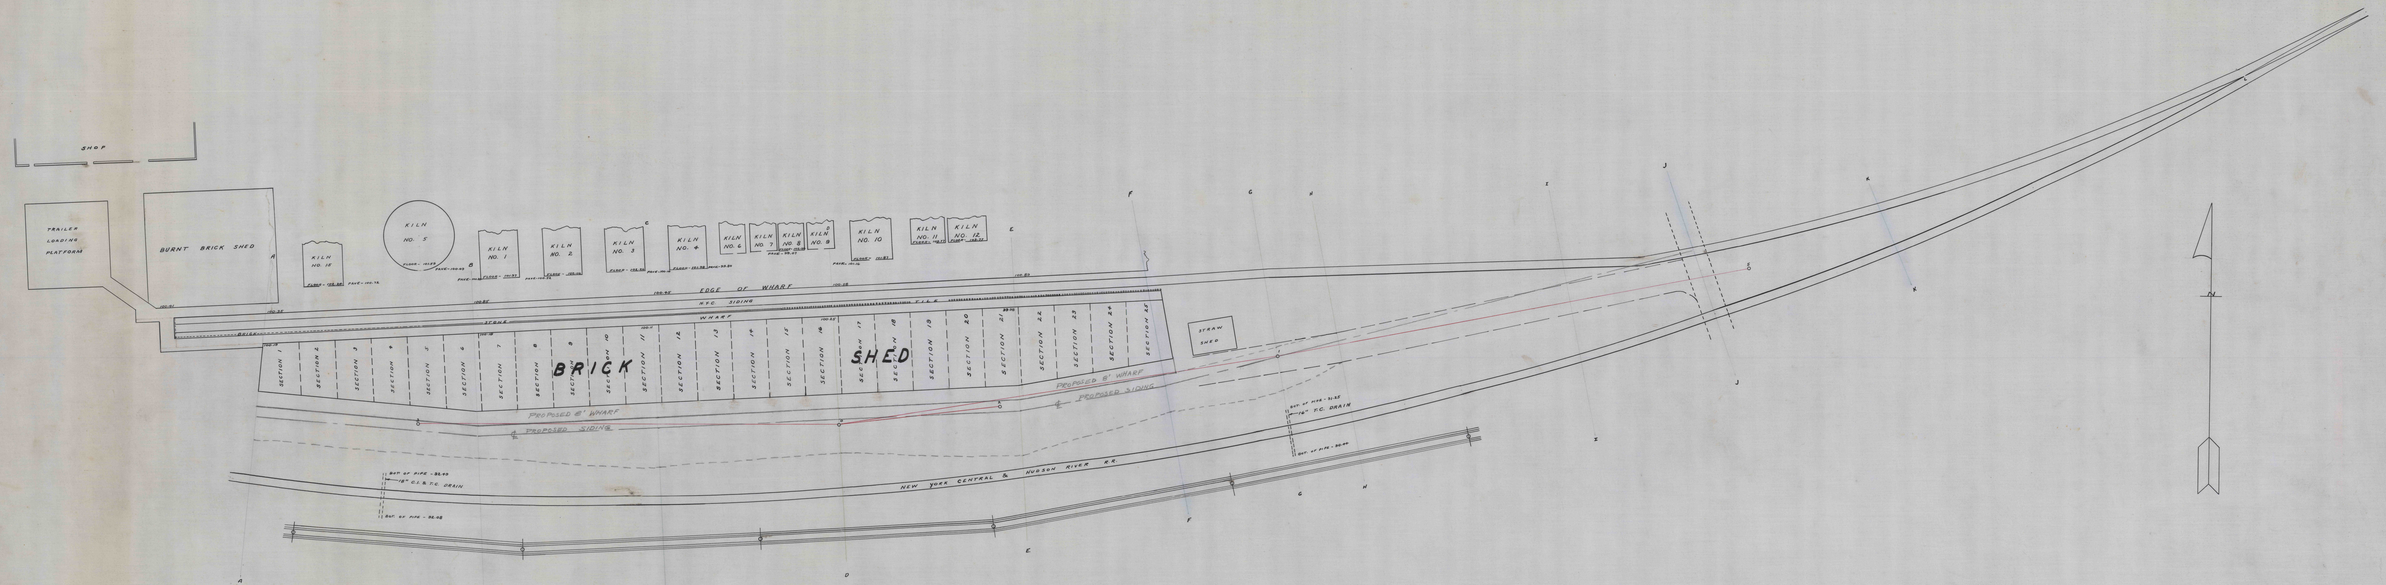

NORTH AMERICAN REFRACTORIES CO.
1013 National City Bank Building
Cleveland, Ohio

PLAN OF KILNS, R.R. AND BRICK SHED
LUMBER CITY

Drawn J.R.M.Jr.	Scale 1" = 20'
Approved	Date 9-2-21
Reference Survey Traced by J.R.M.Jr.	55-1-504