SCALES: PLAN - 1" = 30 FT.
PROFILE - HORIZ. 1" = 30 FT.
VERT. 1" = 3 FT.

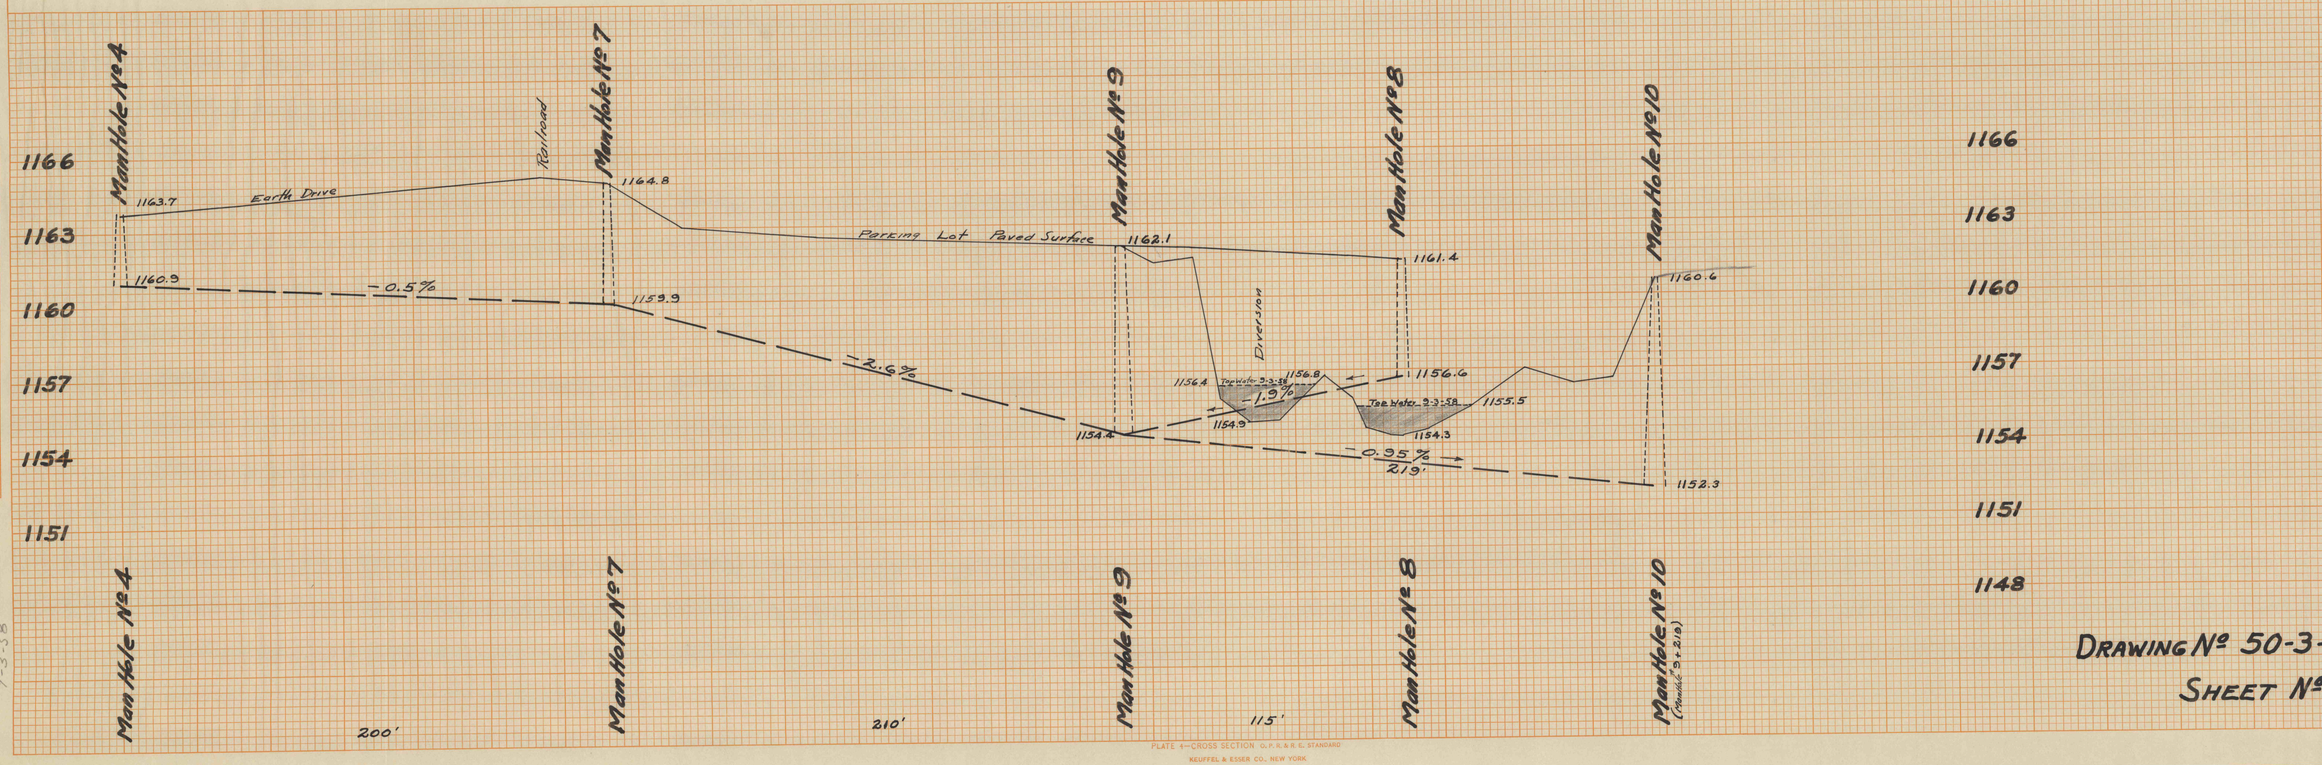


DRAWING No 50-3-1422
SHEET No 3

PLATE 4—CROSS SECTION O. P. R. & R. C. STANDARD
KEUFFEL & ESSER CO., NEW YORK

K & E CO. NO. 345-4 MADE IN U.S.A. 41721