
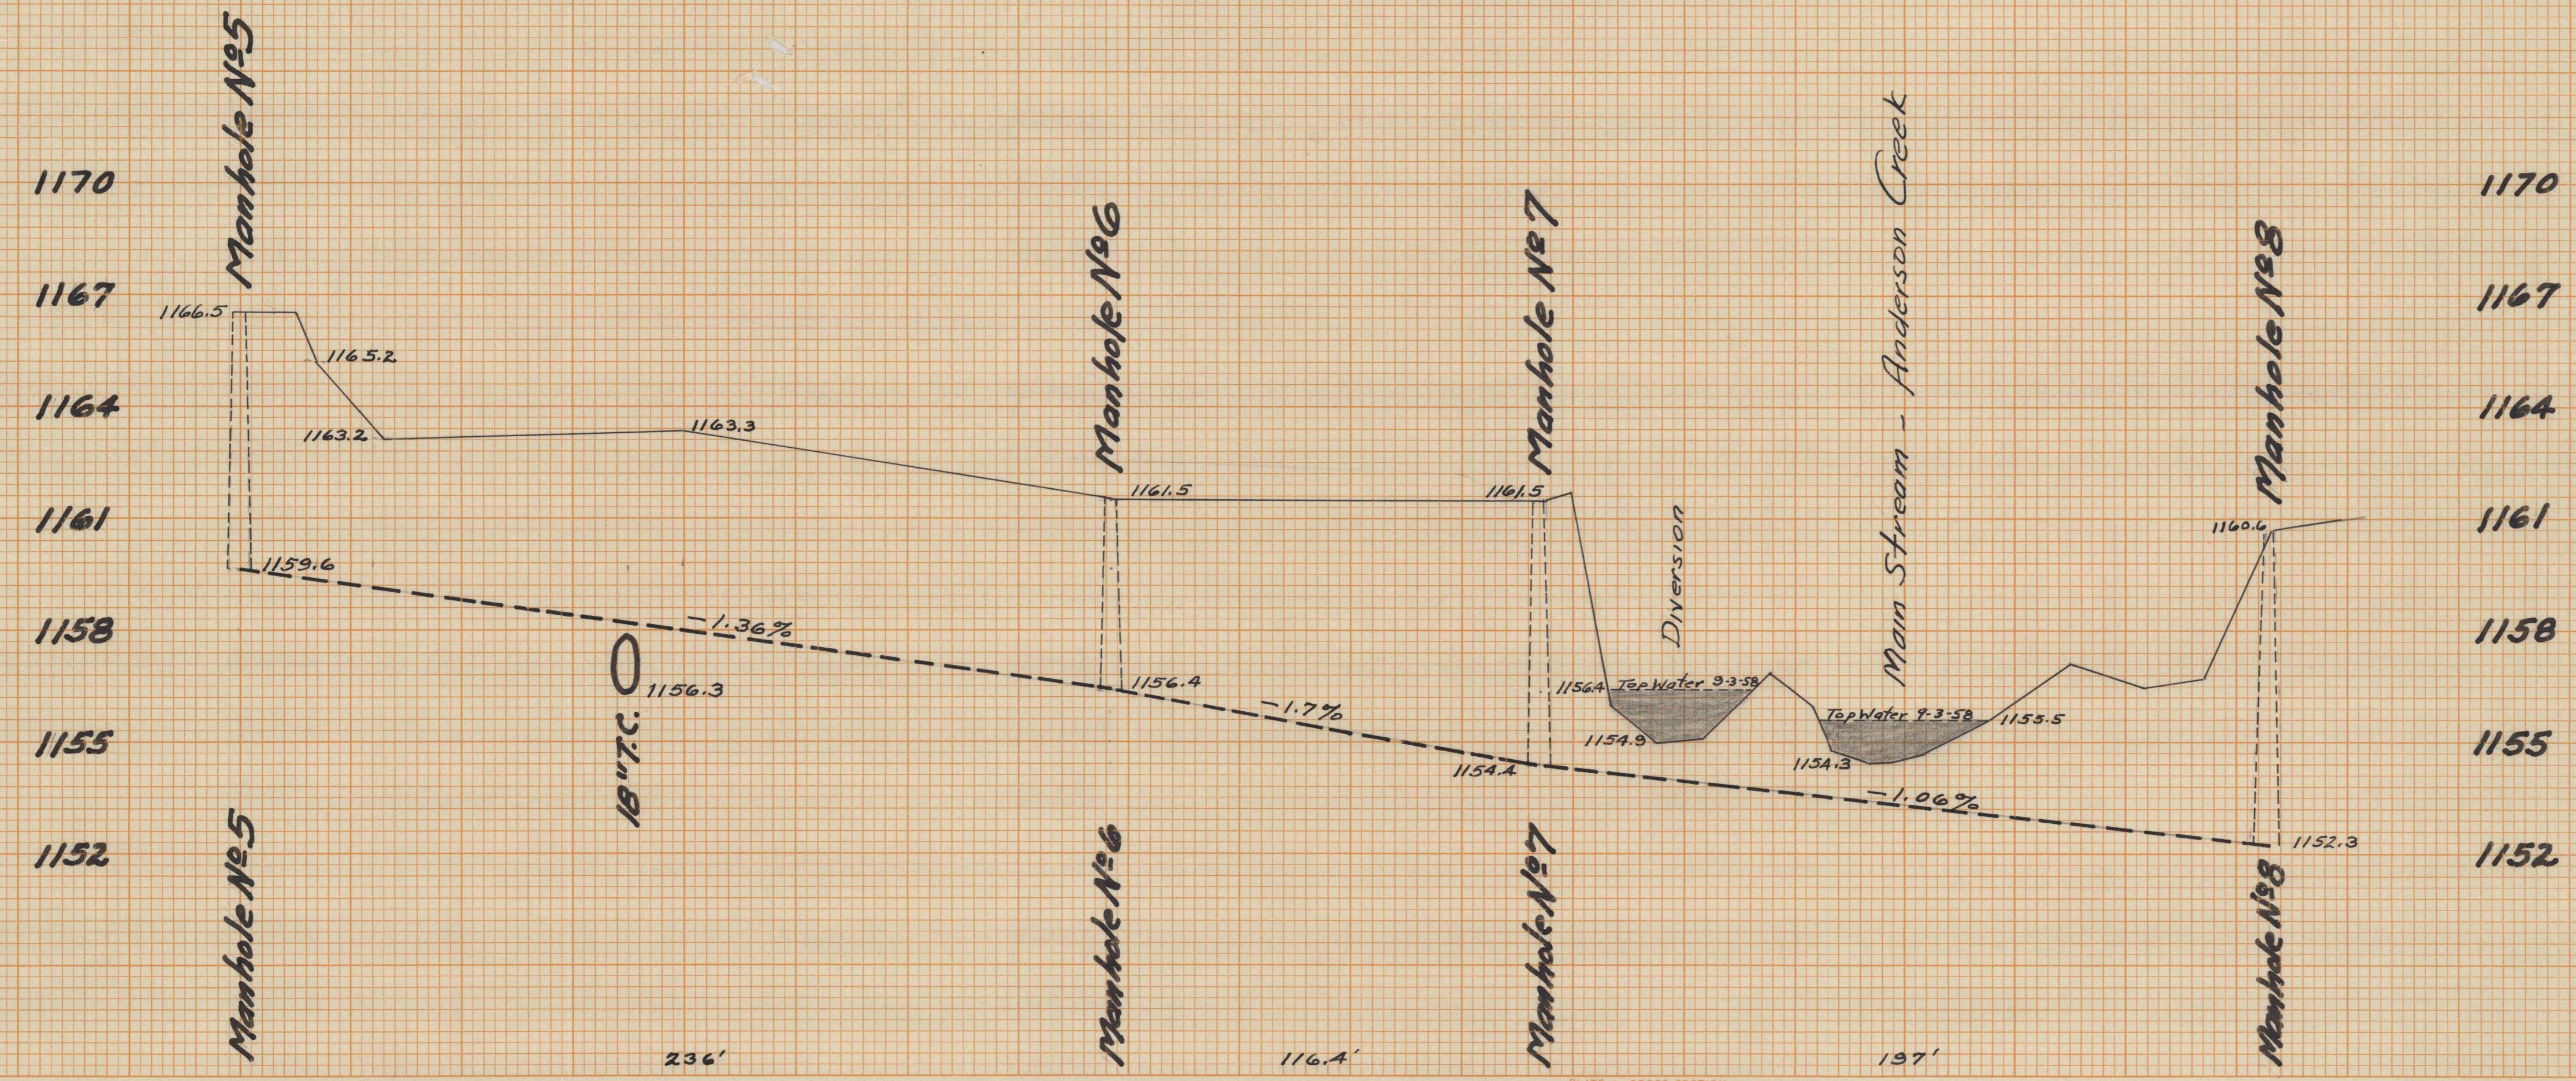


FINAL SURVEY
 SURVEY PLOTTED
 NOTE BOOK
 AREAS CHECKED

ORIGINAL SURVEY
 SURVEY PLOTTED
 NOTE BOOK
 AREAS CHECKED

SCALES: PLAN - 1" = 30 FT.
 PROFILE - HORIZ. 1" = 30 FT.
 VERT. 1" = 3 FT.

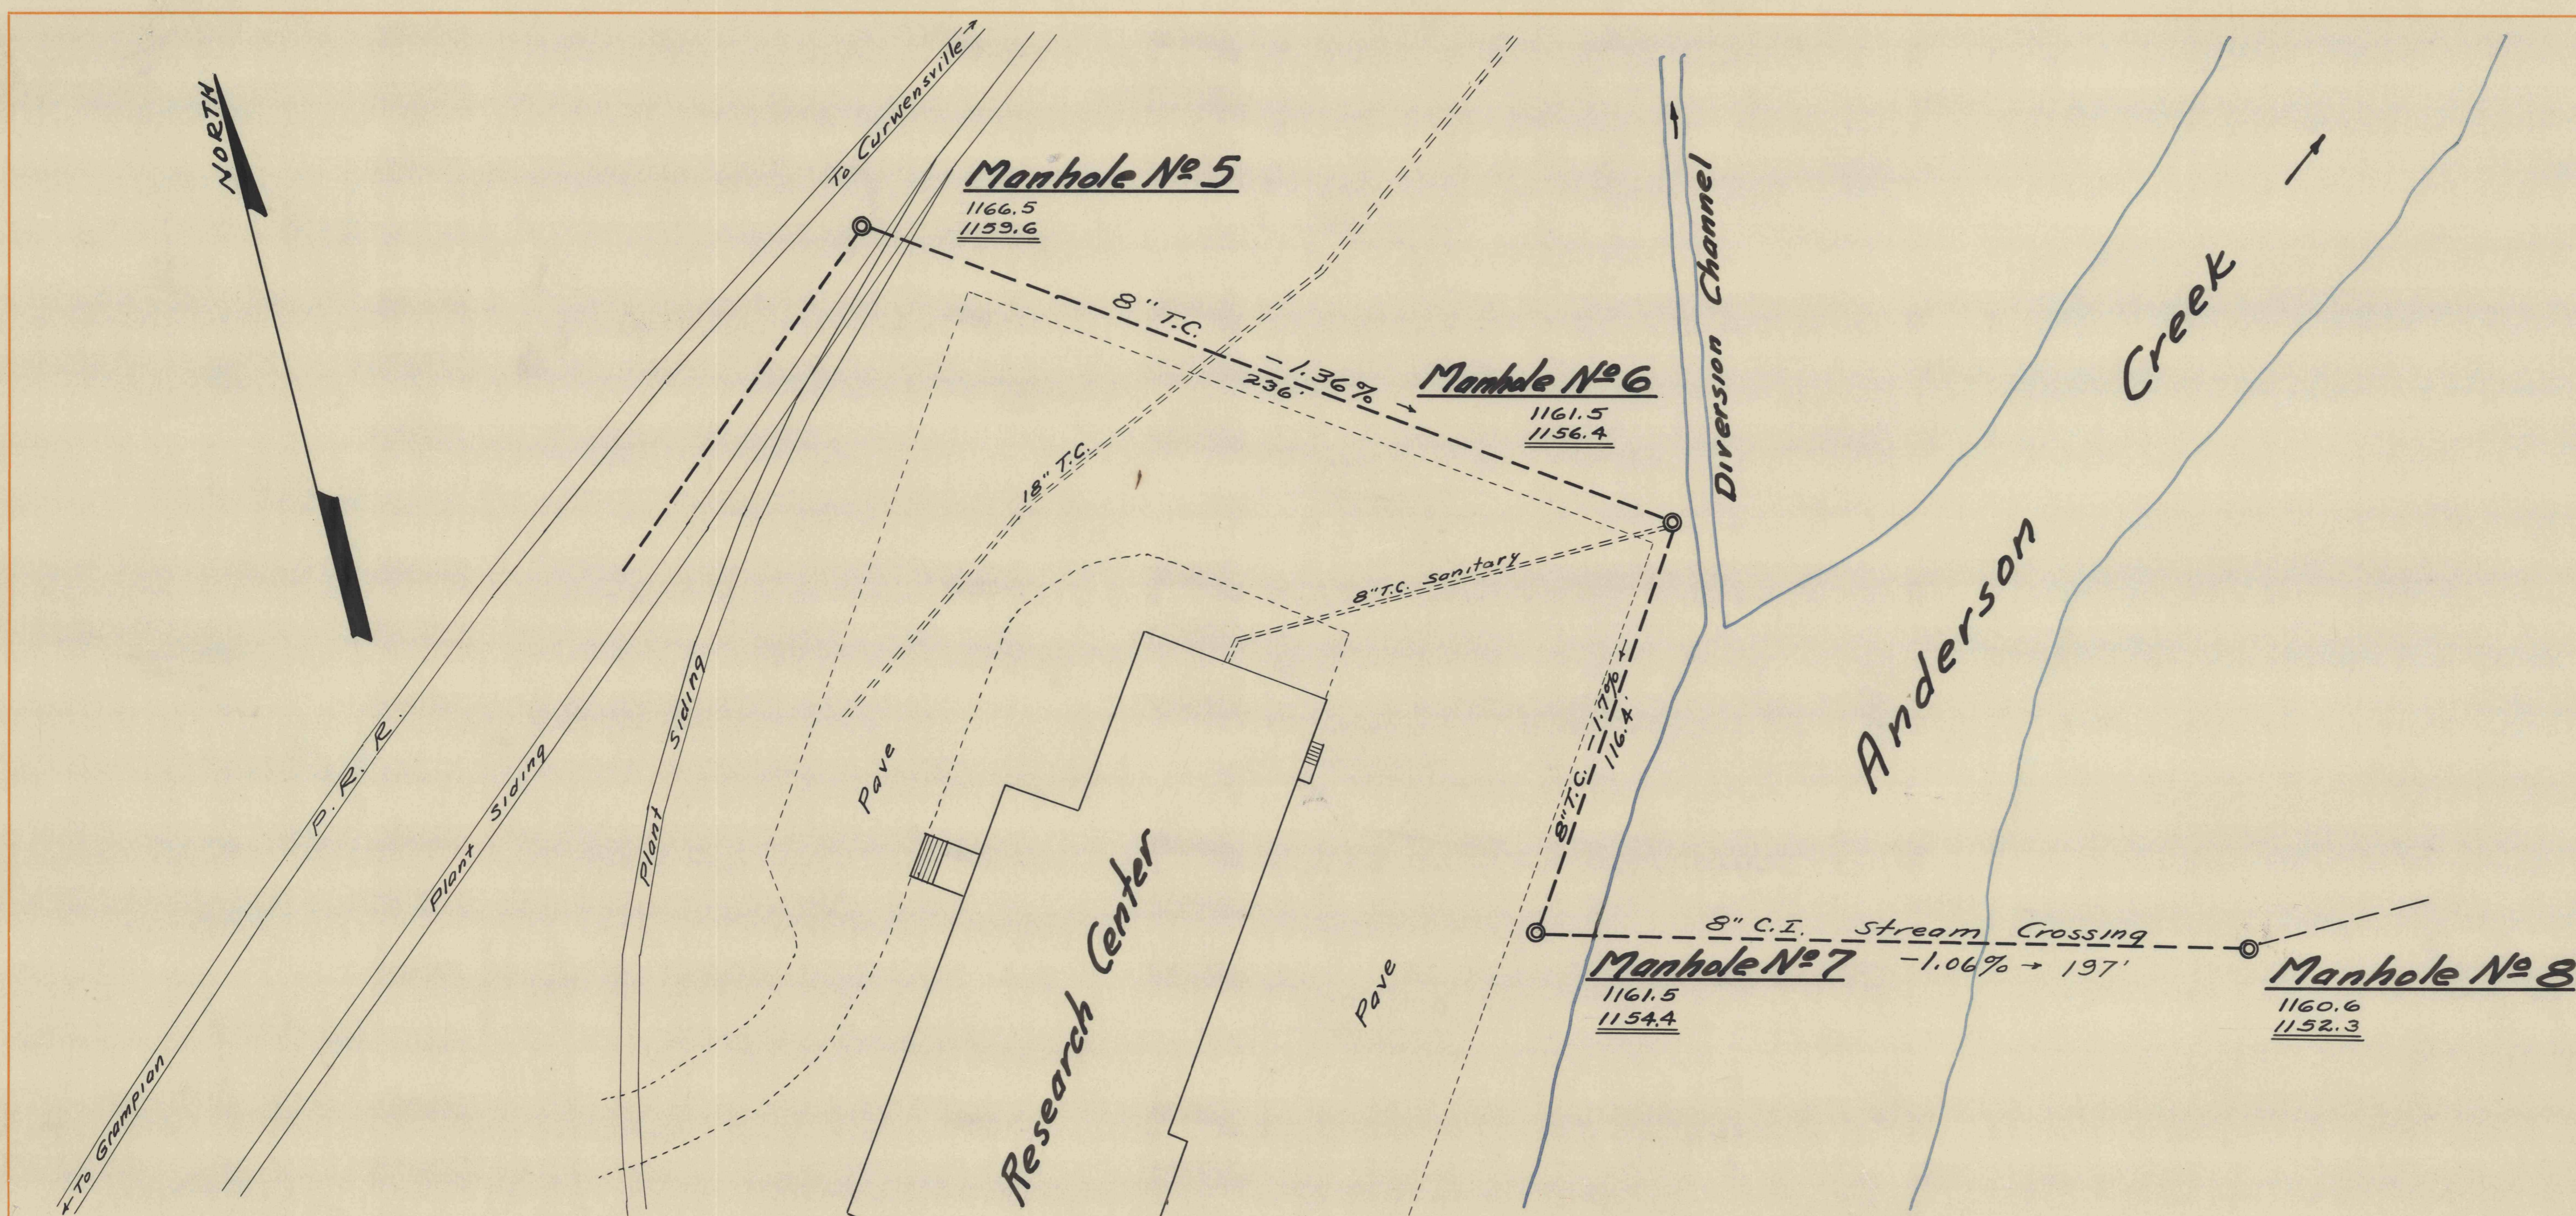

DRAWING No. 50-3-1426
 Sheet No. 2