



DATE _____
 BY _____
 SURVEYED _____
 ORIGINAL SURVEY _____
 NOTE BOOK _____
 AREAS CHECKED _____

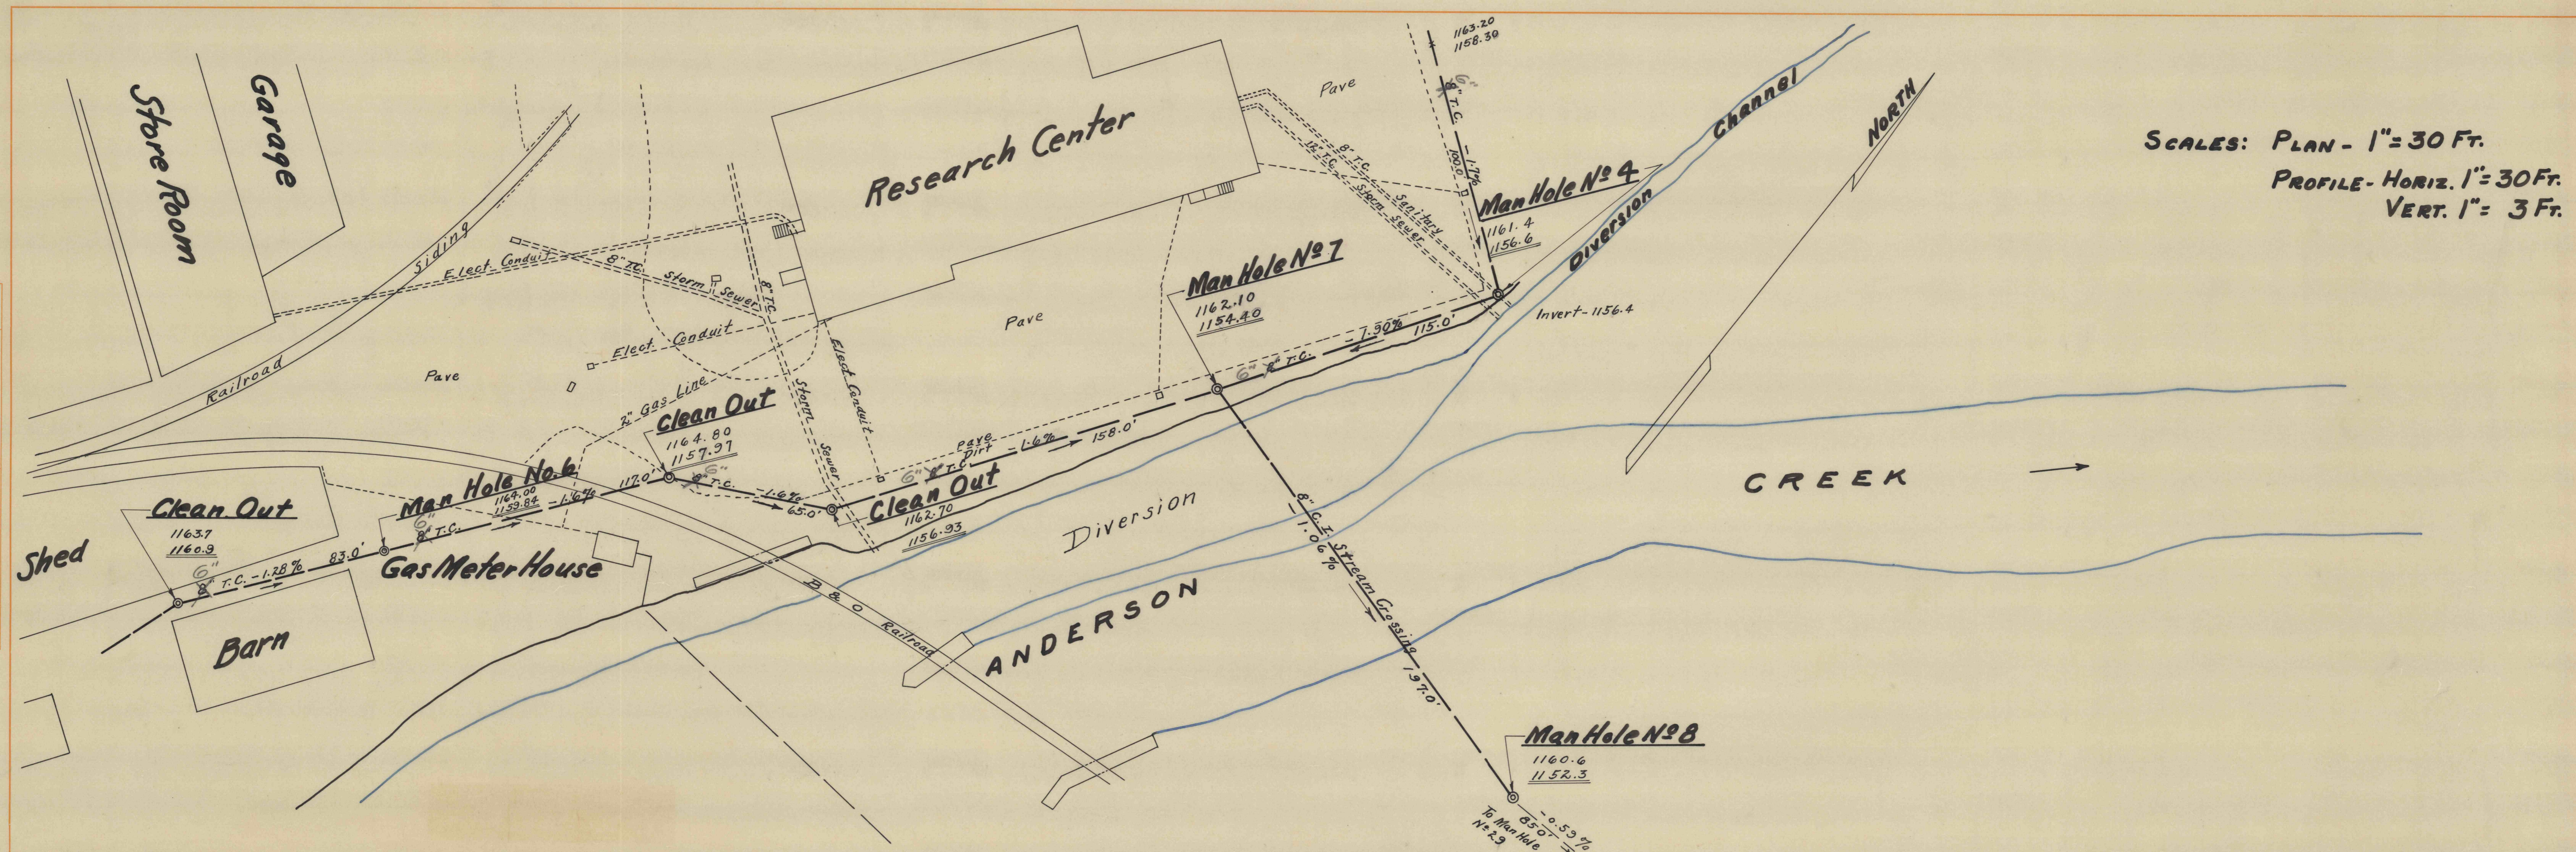

SCALES: PLAN - 1" = 30 Ft.
 PROFILE - HORIZ. 1" = 30 Ft.
 VERT. 1" = 3 Ft.

DATE _____
 BY _____
 SURVEYED _____
 ORIGINAL SURVEY _____
 NOTE BOOK _____
 AREAS CHECKED _____

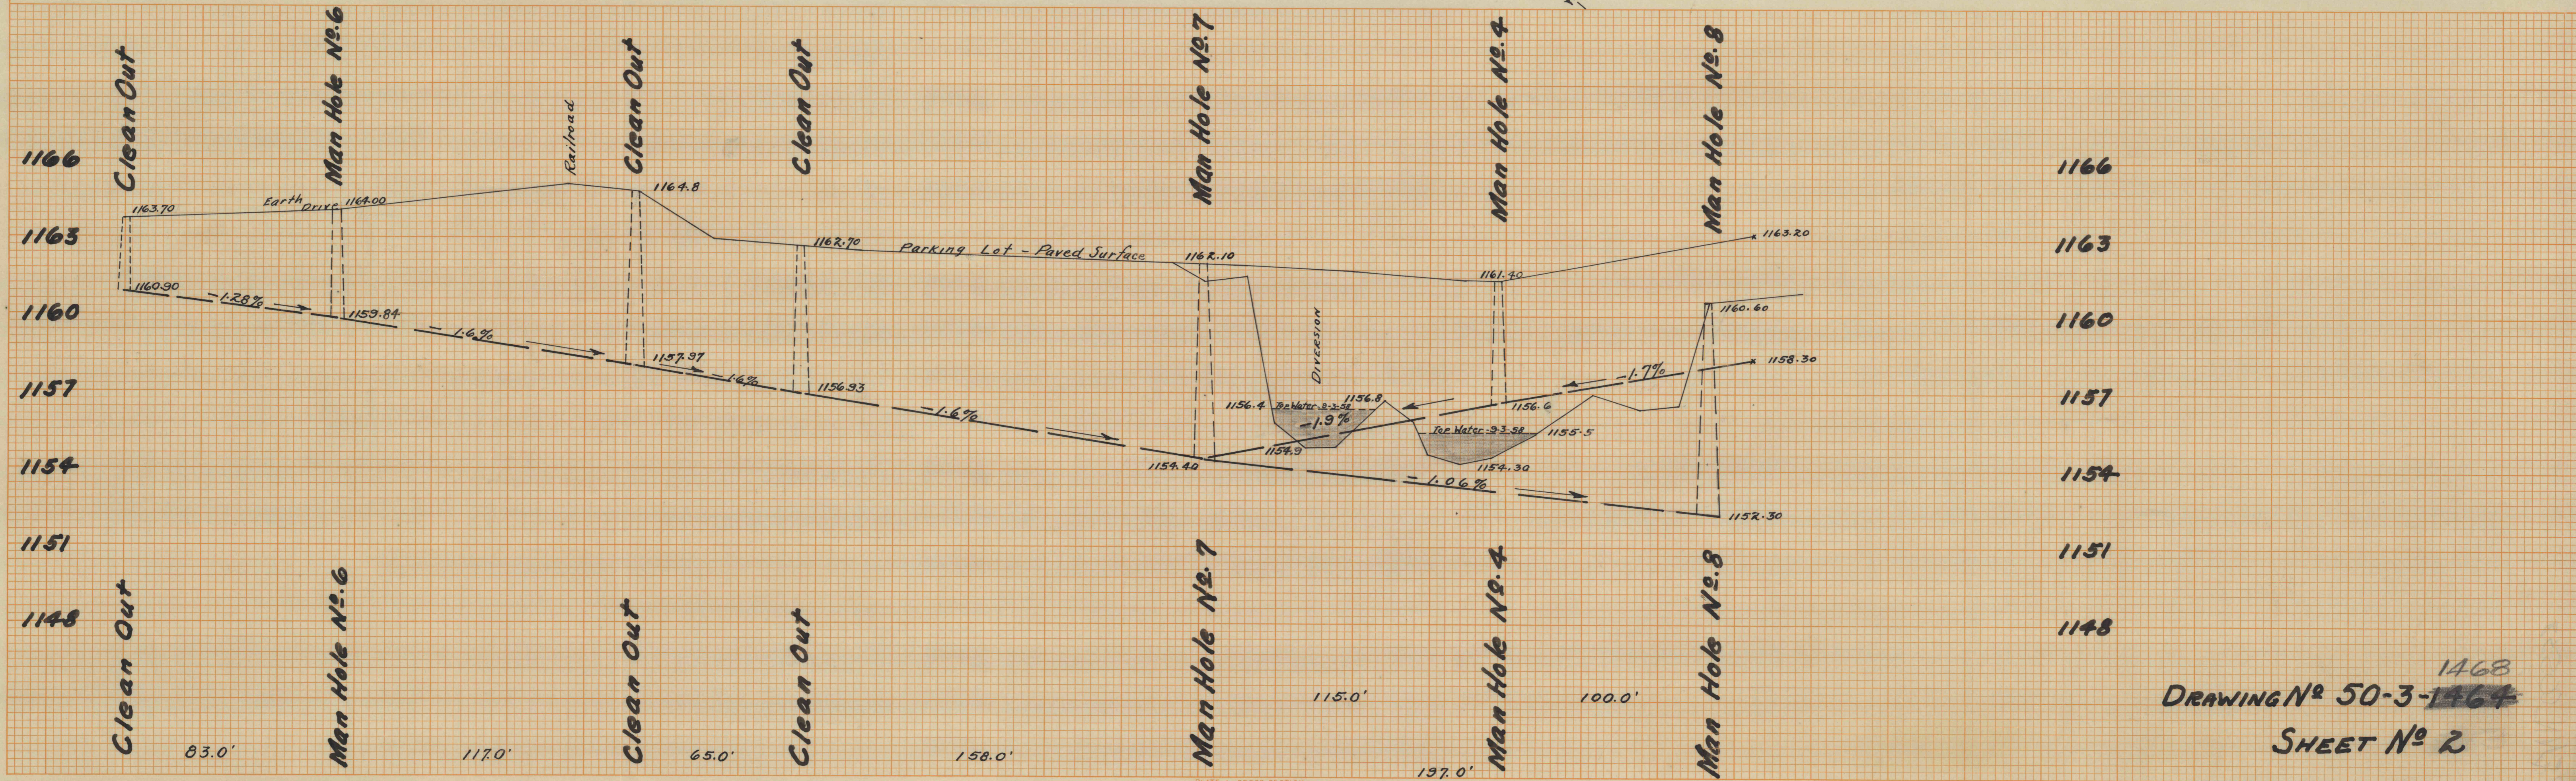

1468
 DRAWING N^o 50-3-1464
 SHEET N^o 2

4-16-59