



FINAL SURVEYED, PLOTTED, AND CHECKED. DATE: BY: NO. AREAS CHECKED.

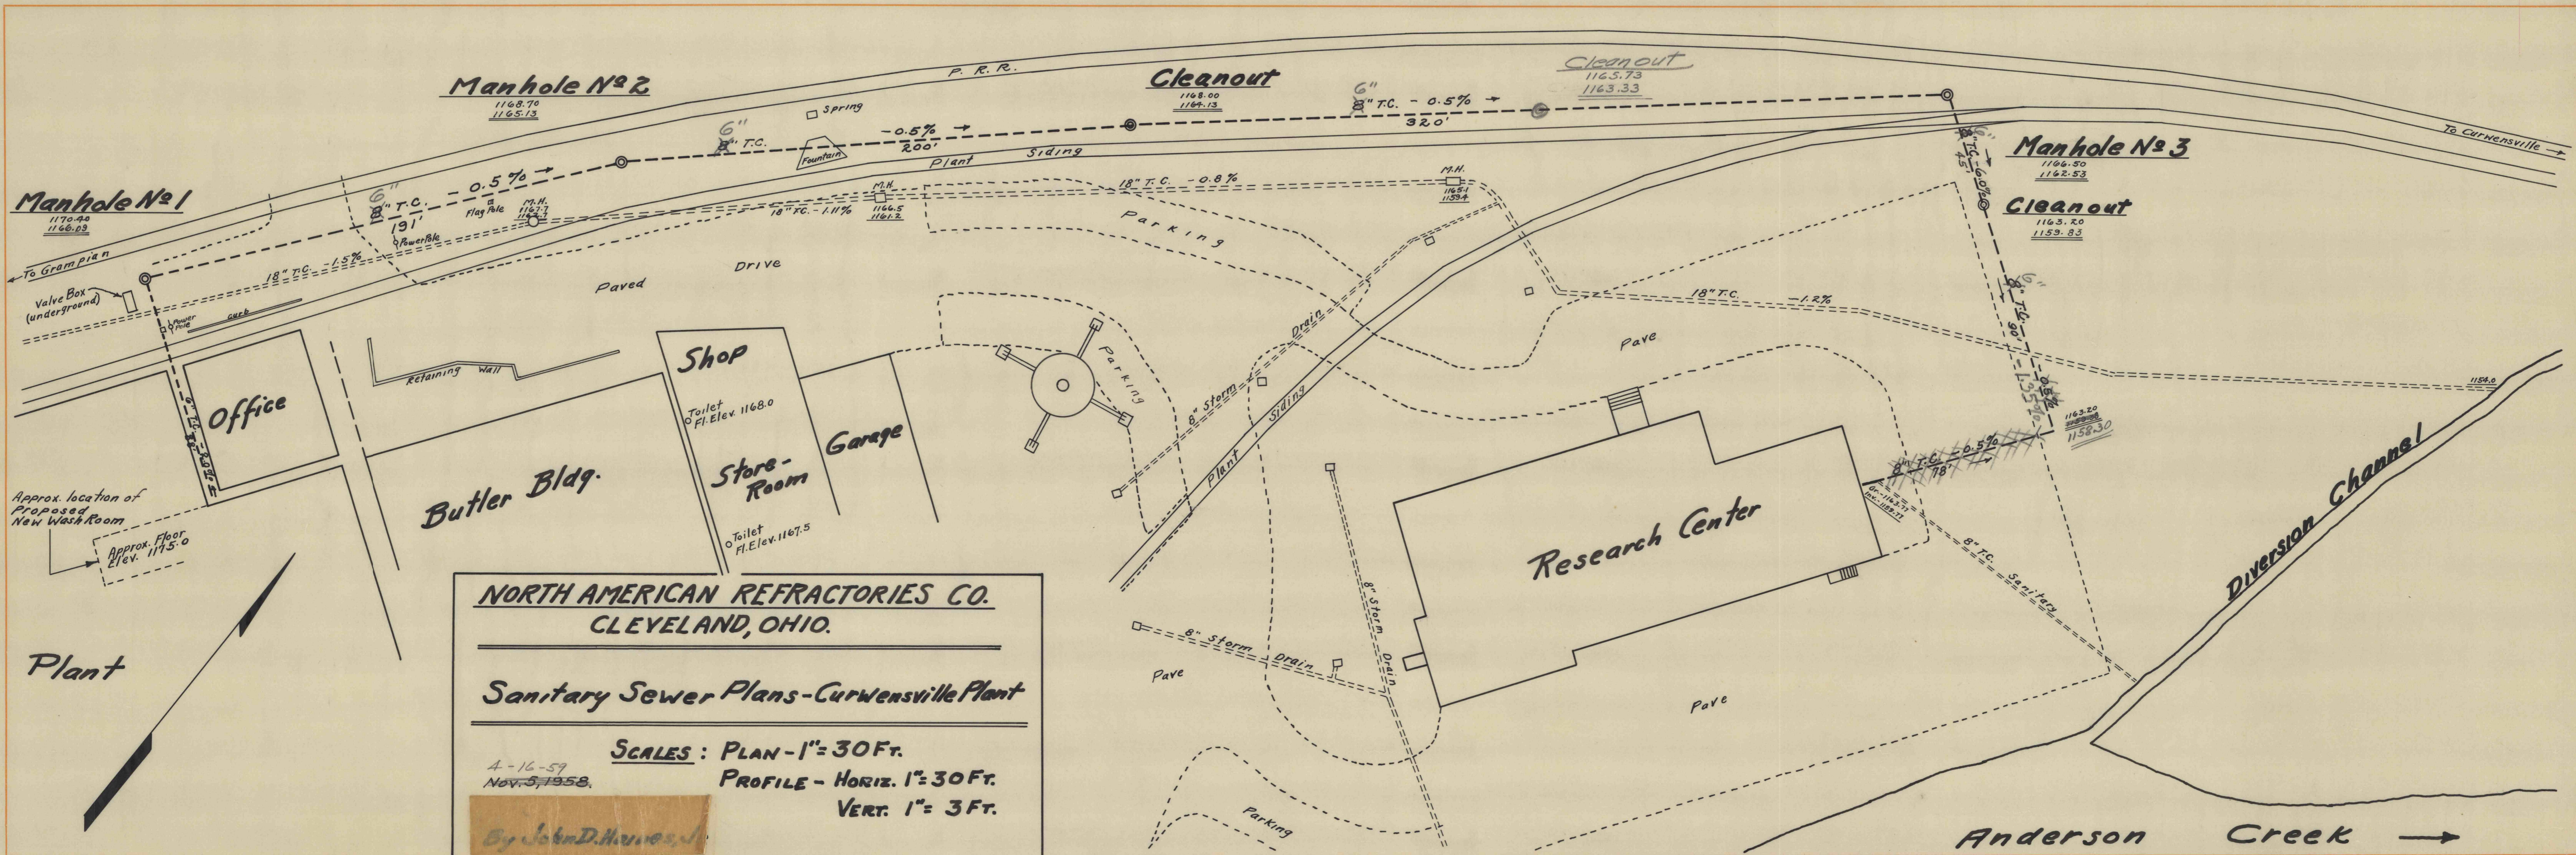

ORIGINAL SURVEYED, PLOTTED, AND CHECKED. DATE: BY: NO. AREAS CHECKED.

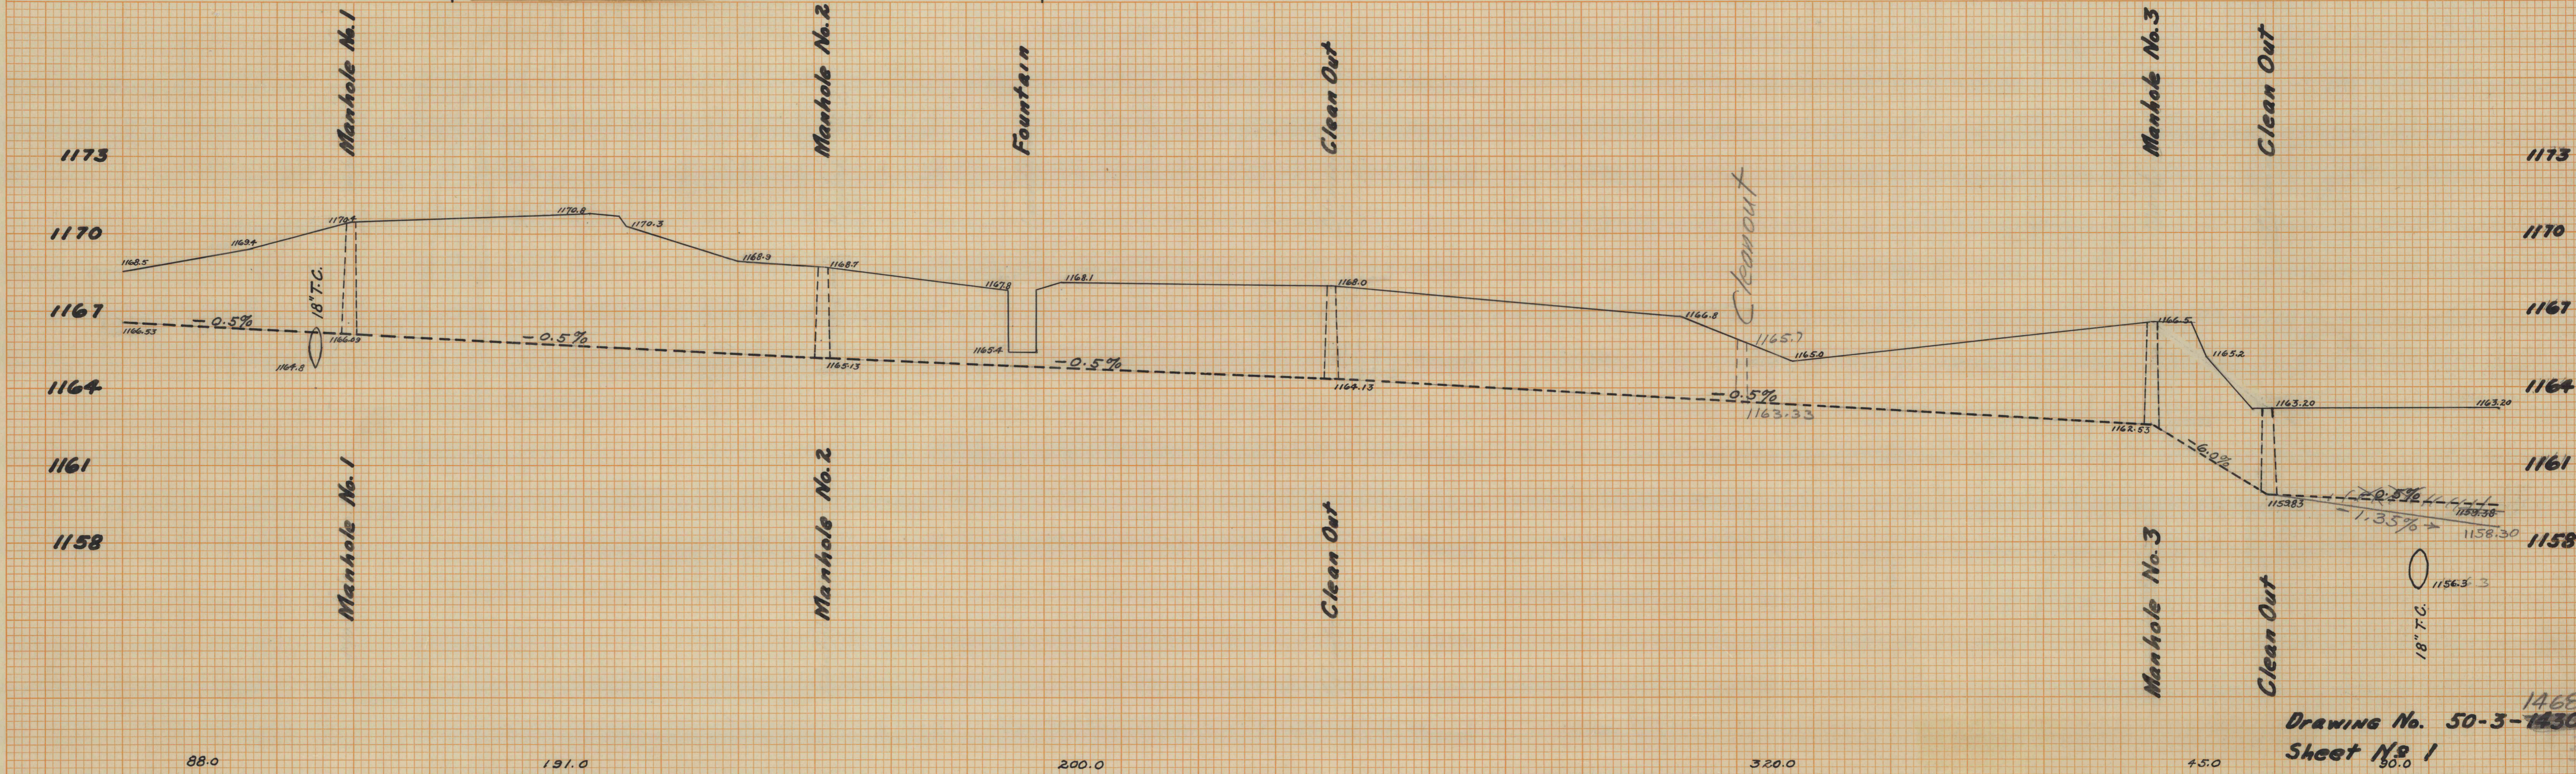

Drawing No. 50-3-1430
Sheet No. 1