
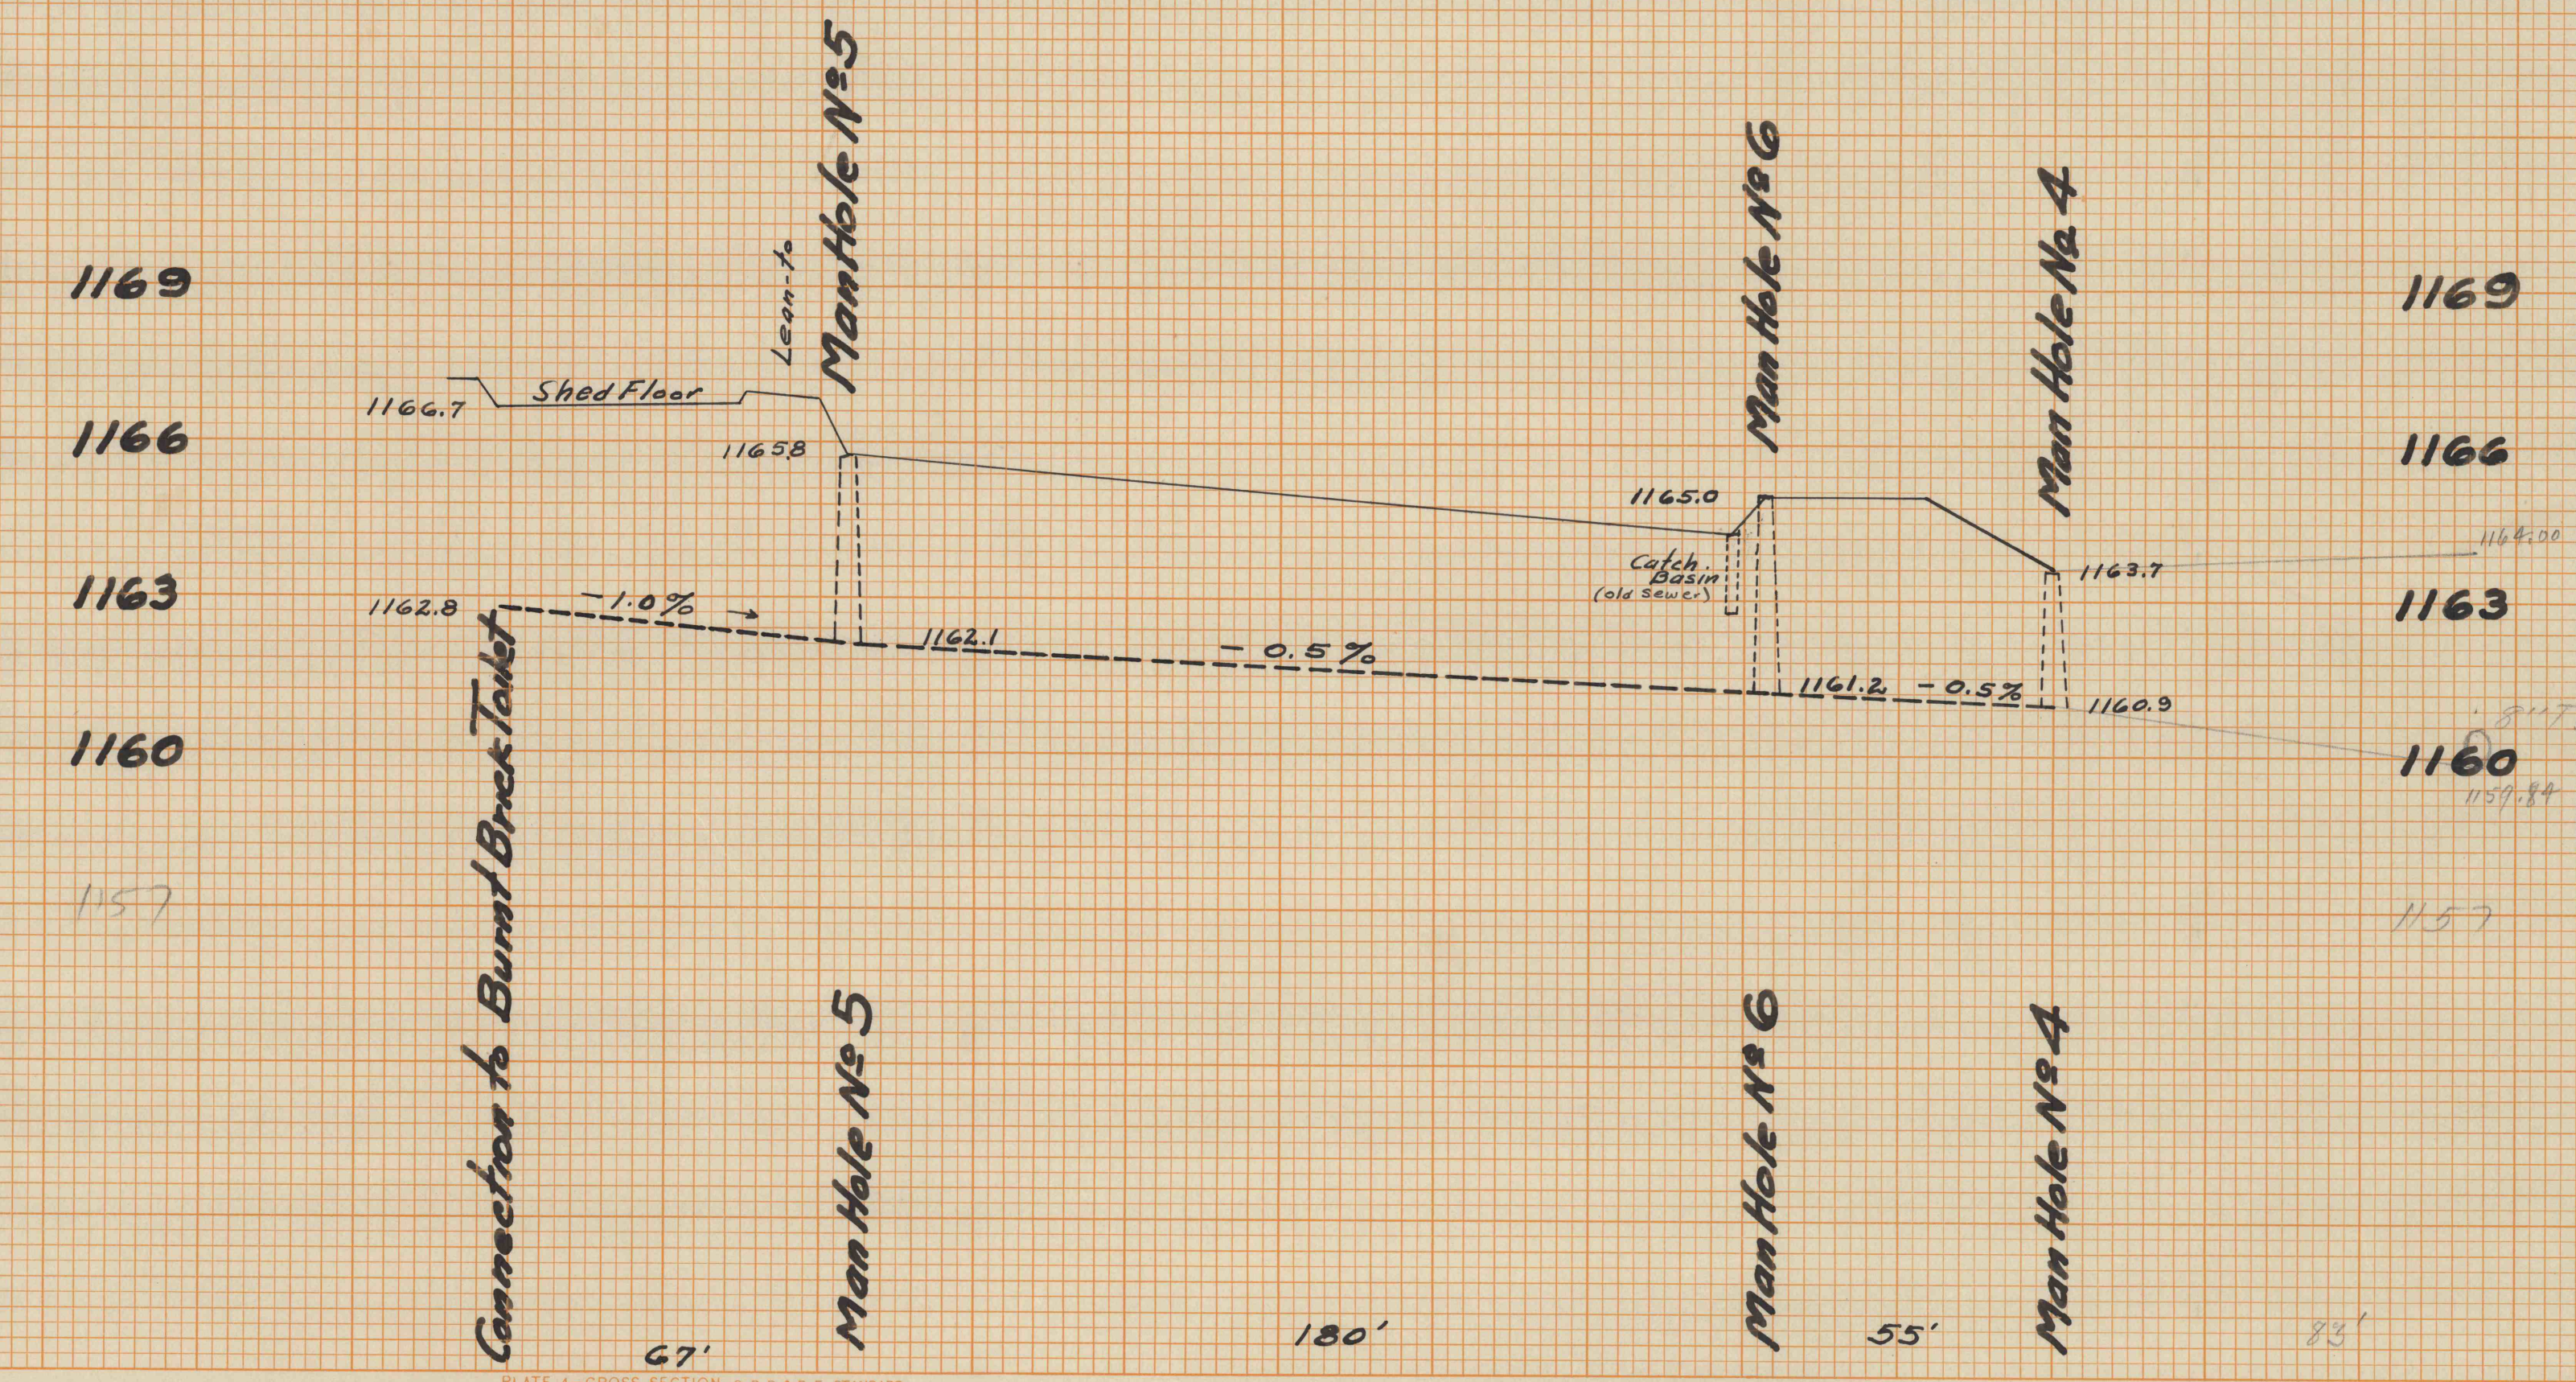


55-3-1422
(Sheet 2)

SCALES: PLAN - 1" = 30 FT.
PROFILE - HORIZ. 1" = 30 FT.
VERT. 1" = 3 FT.

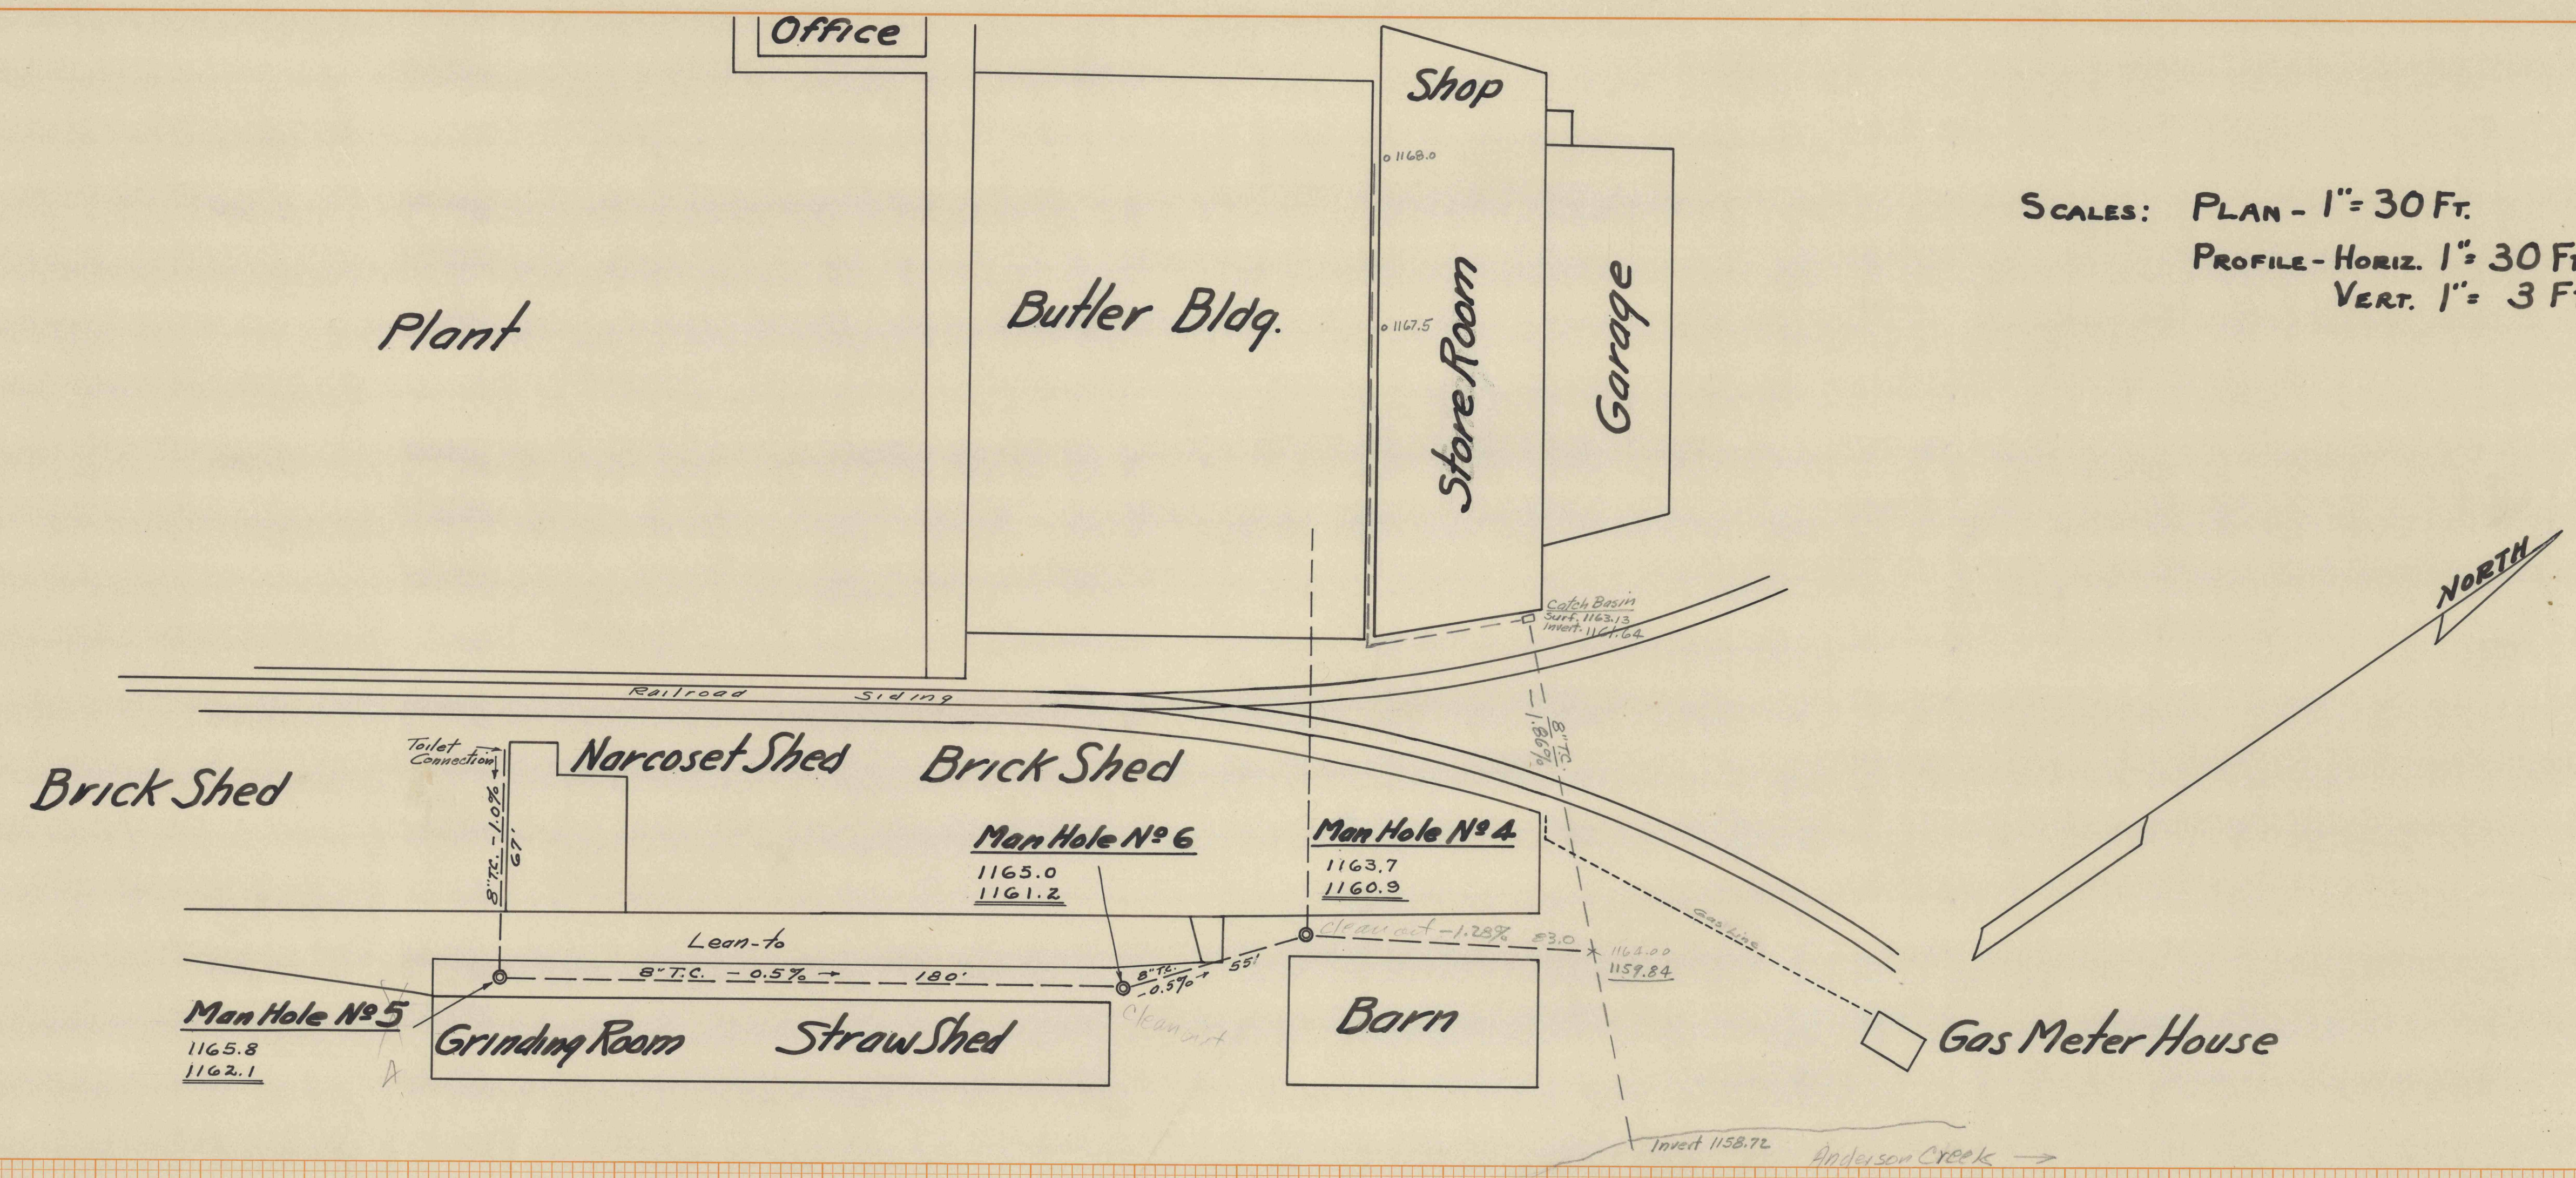

DRAWING No 50-3-1422
SHEET No 2

PLATE 4--GROSS SECTION O.P. & R.E. STANDARD
KEUFFEL & ESSER CO., NEW YORK

K & E CO. NO. 345-4 MOD. U.S.A. 4123

55-3-1422
(Sheet 2)
BEWIT OLSON

FINAL SURVEY	NO.
SURVEYED	DATE
PLOTTED	BY
TEMPLATE	
NOTE BOOK	
AREAS CHECKED	

ORIGINAL SURVEY	NO.
SURVEYED	DATE
PLOTTED	BY
TEMPLATE	
NOTE BOOK	
AREAS CHECKED	

9-3-58