


← 578.03  
 THIS POINT 63.5' FROM WALL  
 AT END OF TRANSFER TRACK

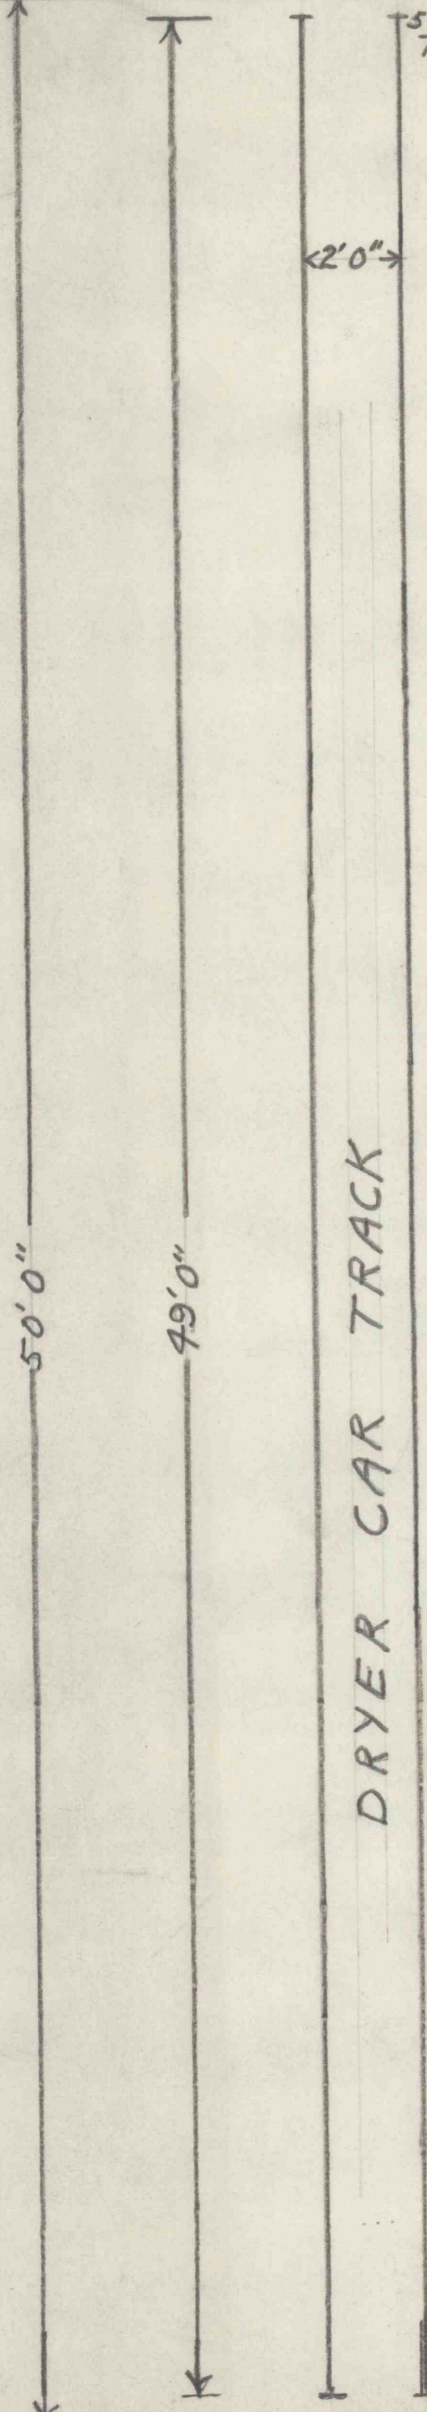


DRYER CAR TRACK

POWER PRESS

NORTH AMERICAN REFRACTORIES CO.  
 CLEVELAND, OHIO  
 ELEVATIONS AT MT. UNION WORKS  
 SCALE 1/4" = 1'  
 DRAWN 6-16-49 J.C.M. APPROVED 6-16-49 J.M.F.  
 DWG. NO. 60-1-506-50

ENGINE ROOM

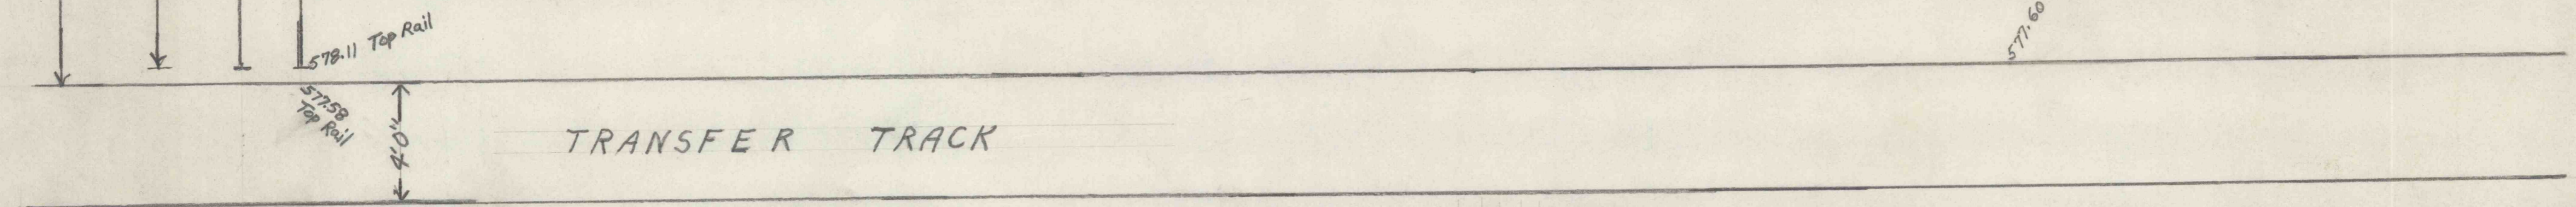

TOP OF RAIL OF  
 DRYER CAR TRACK  
 NO. 9 DOOR 578.10

↓  
 TOP OF TRANSFER TRACK GREEN BRICK SIDE 576.60

60-1-506-50