
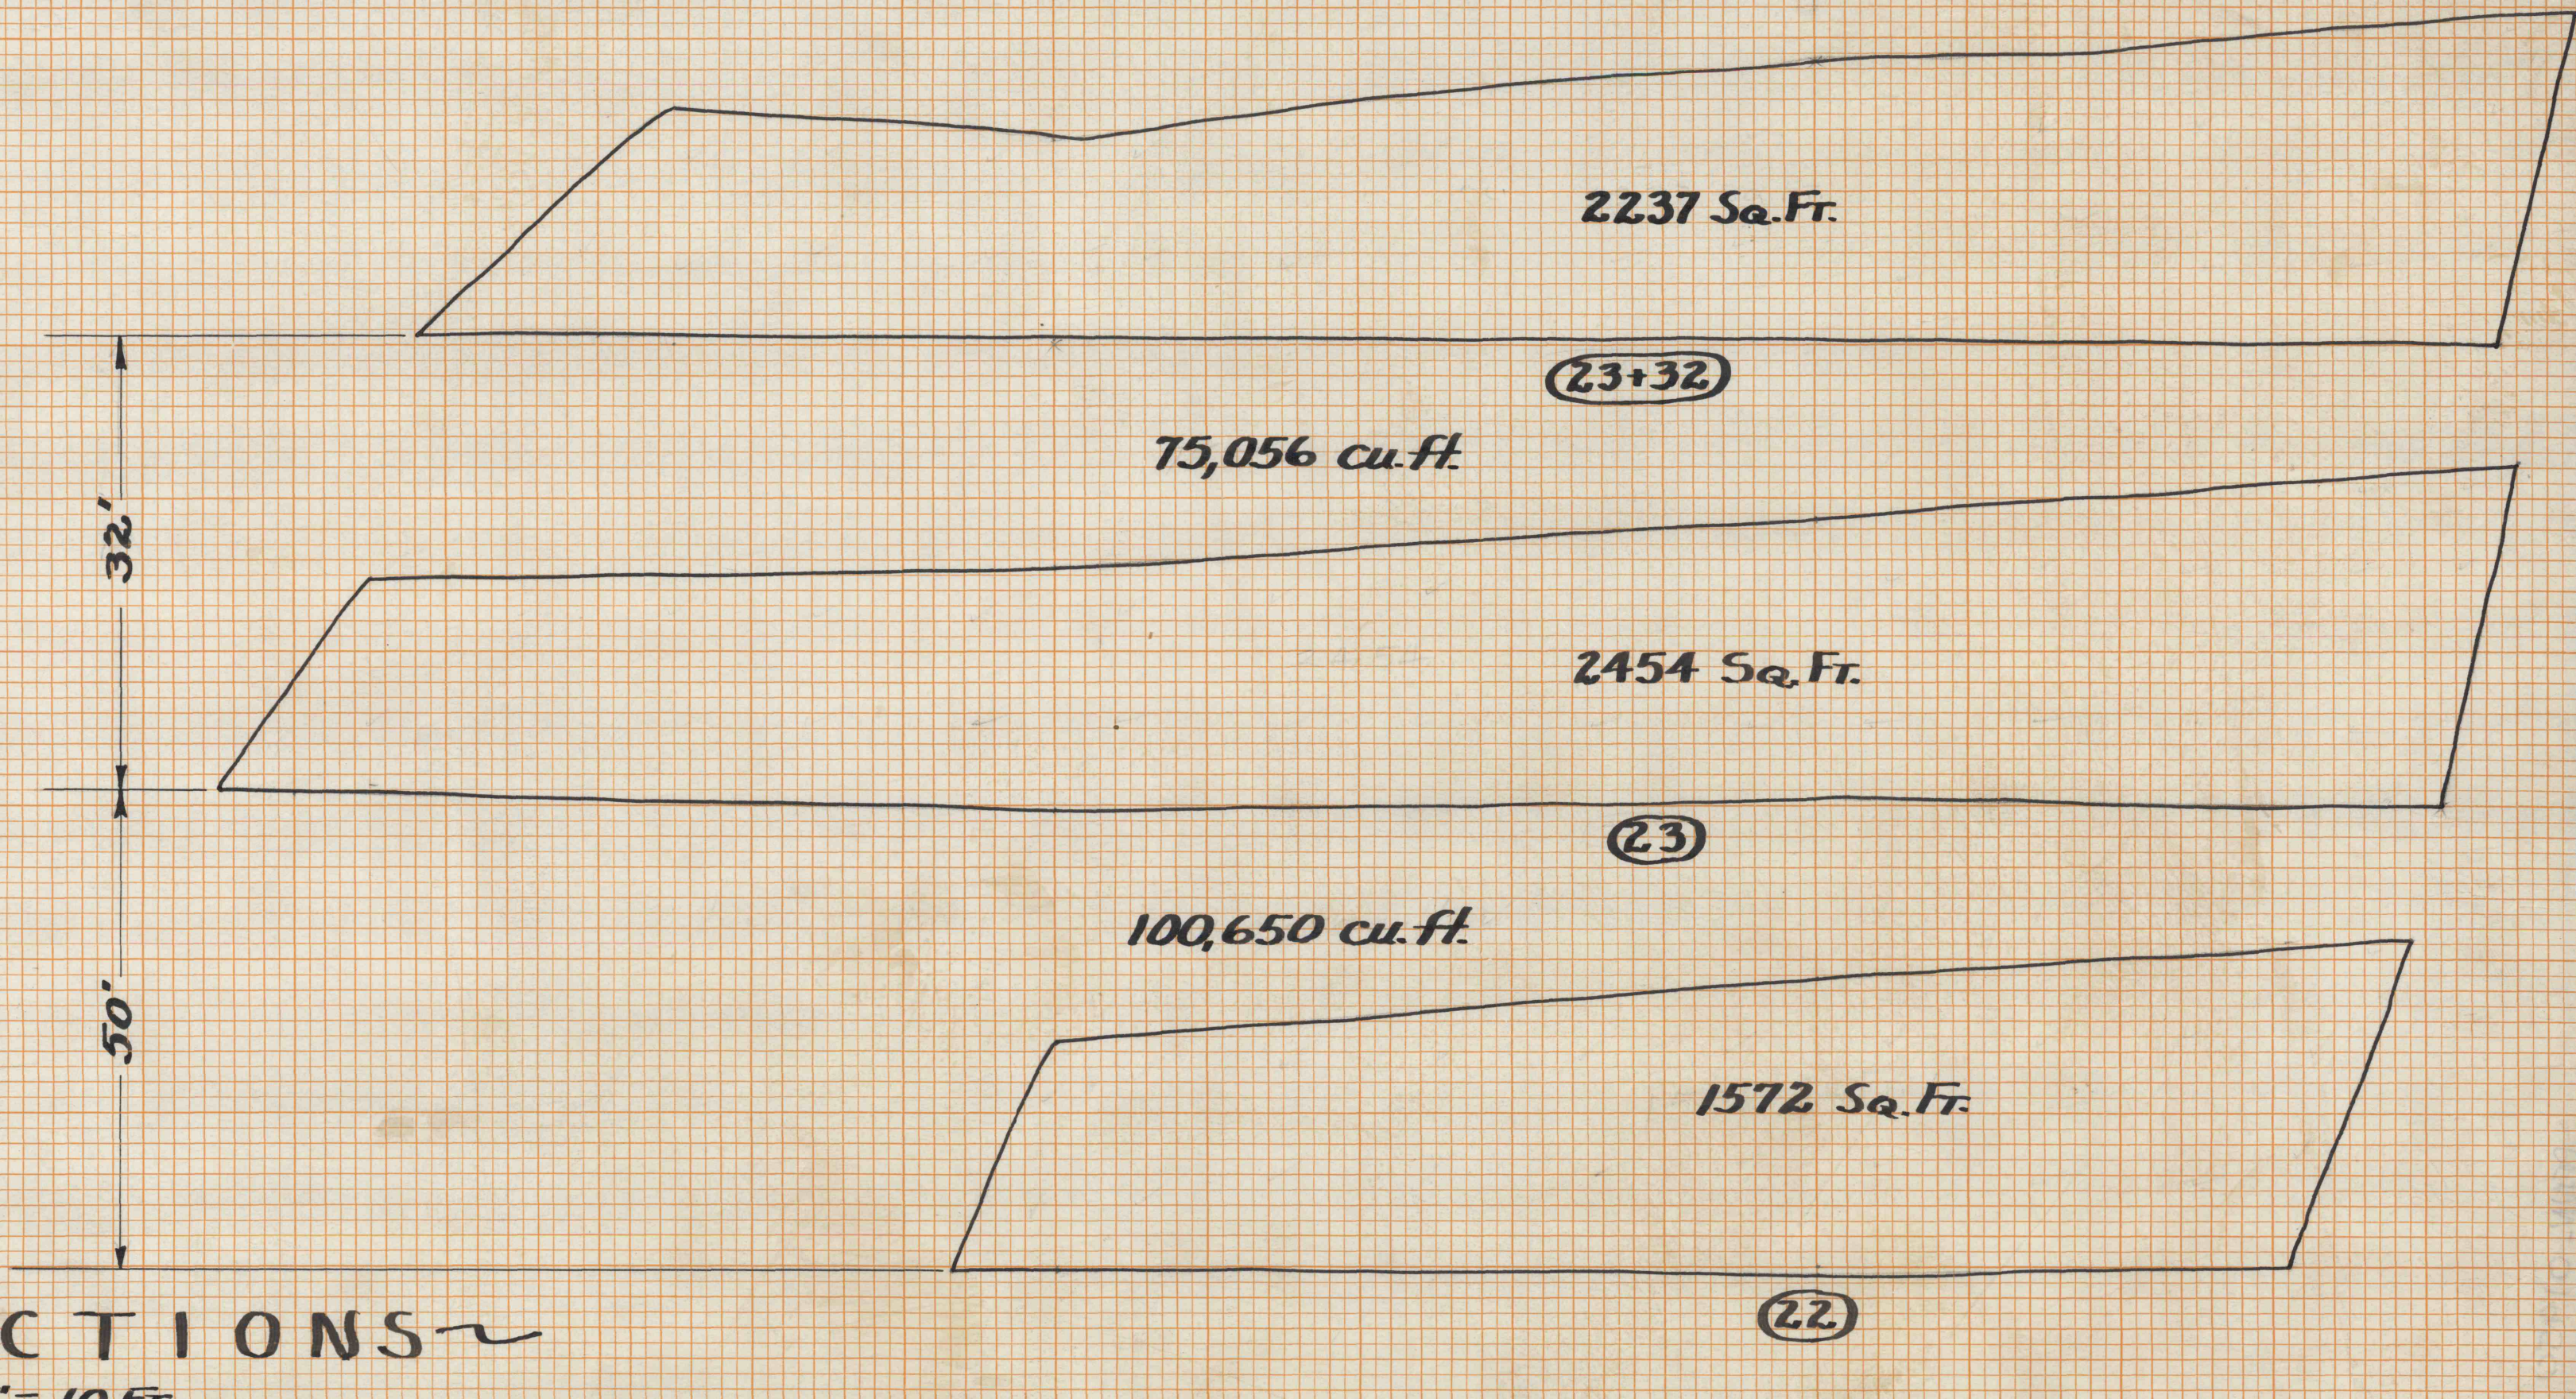


NORTH AMERICAN REFRACTORIES CO.  
WINGERT TRACT  
1944-45 STRIPPING  
SURVEYED 6-3-45

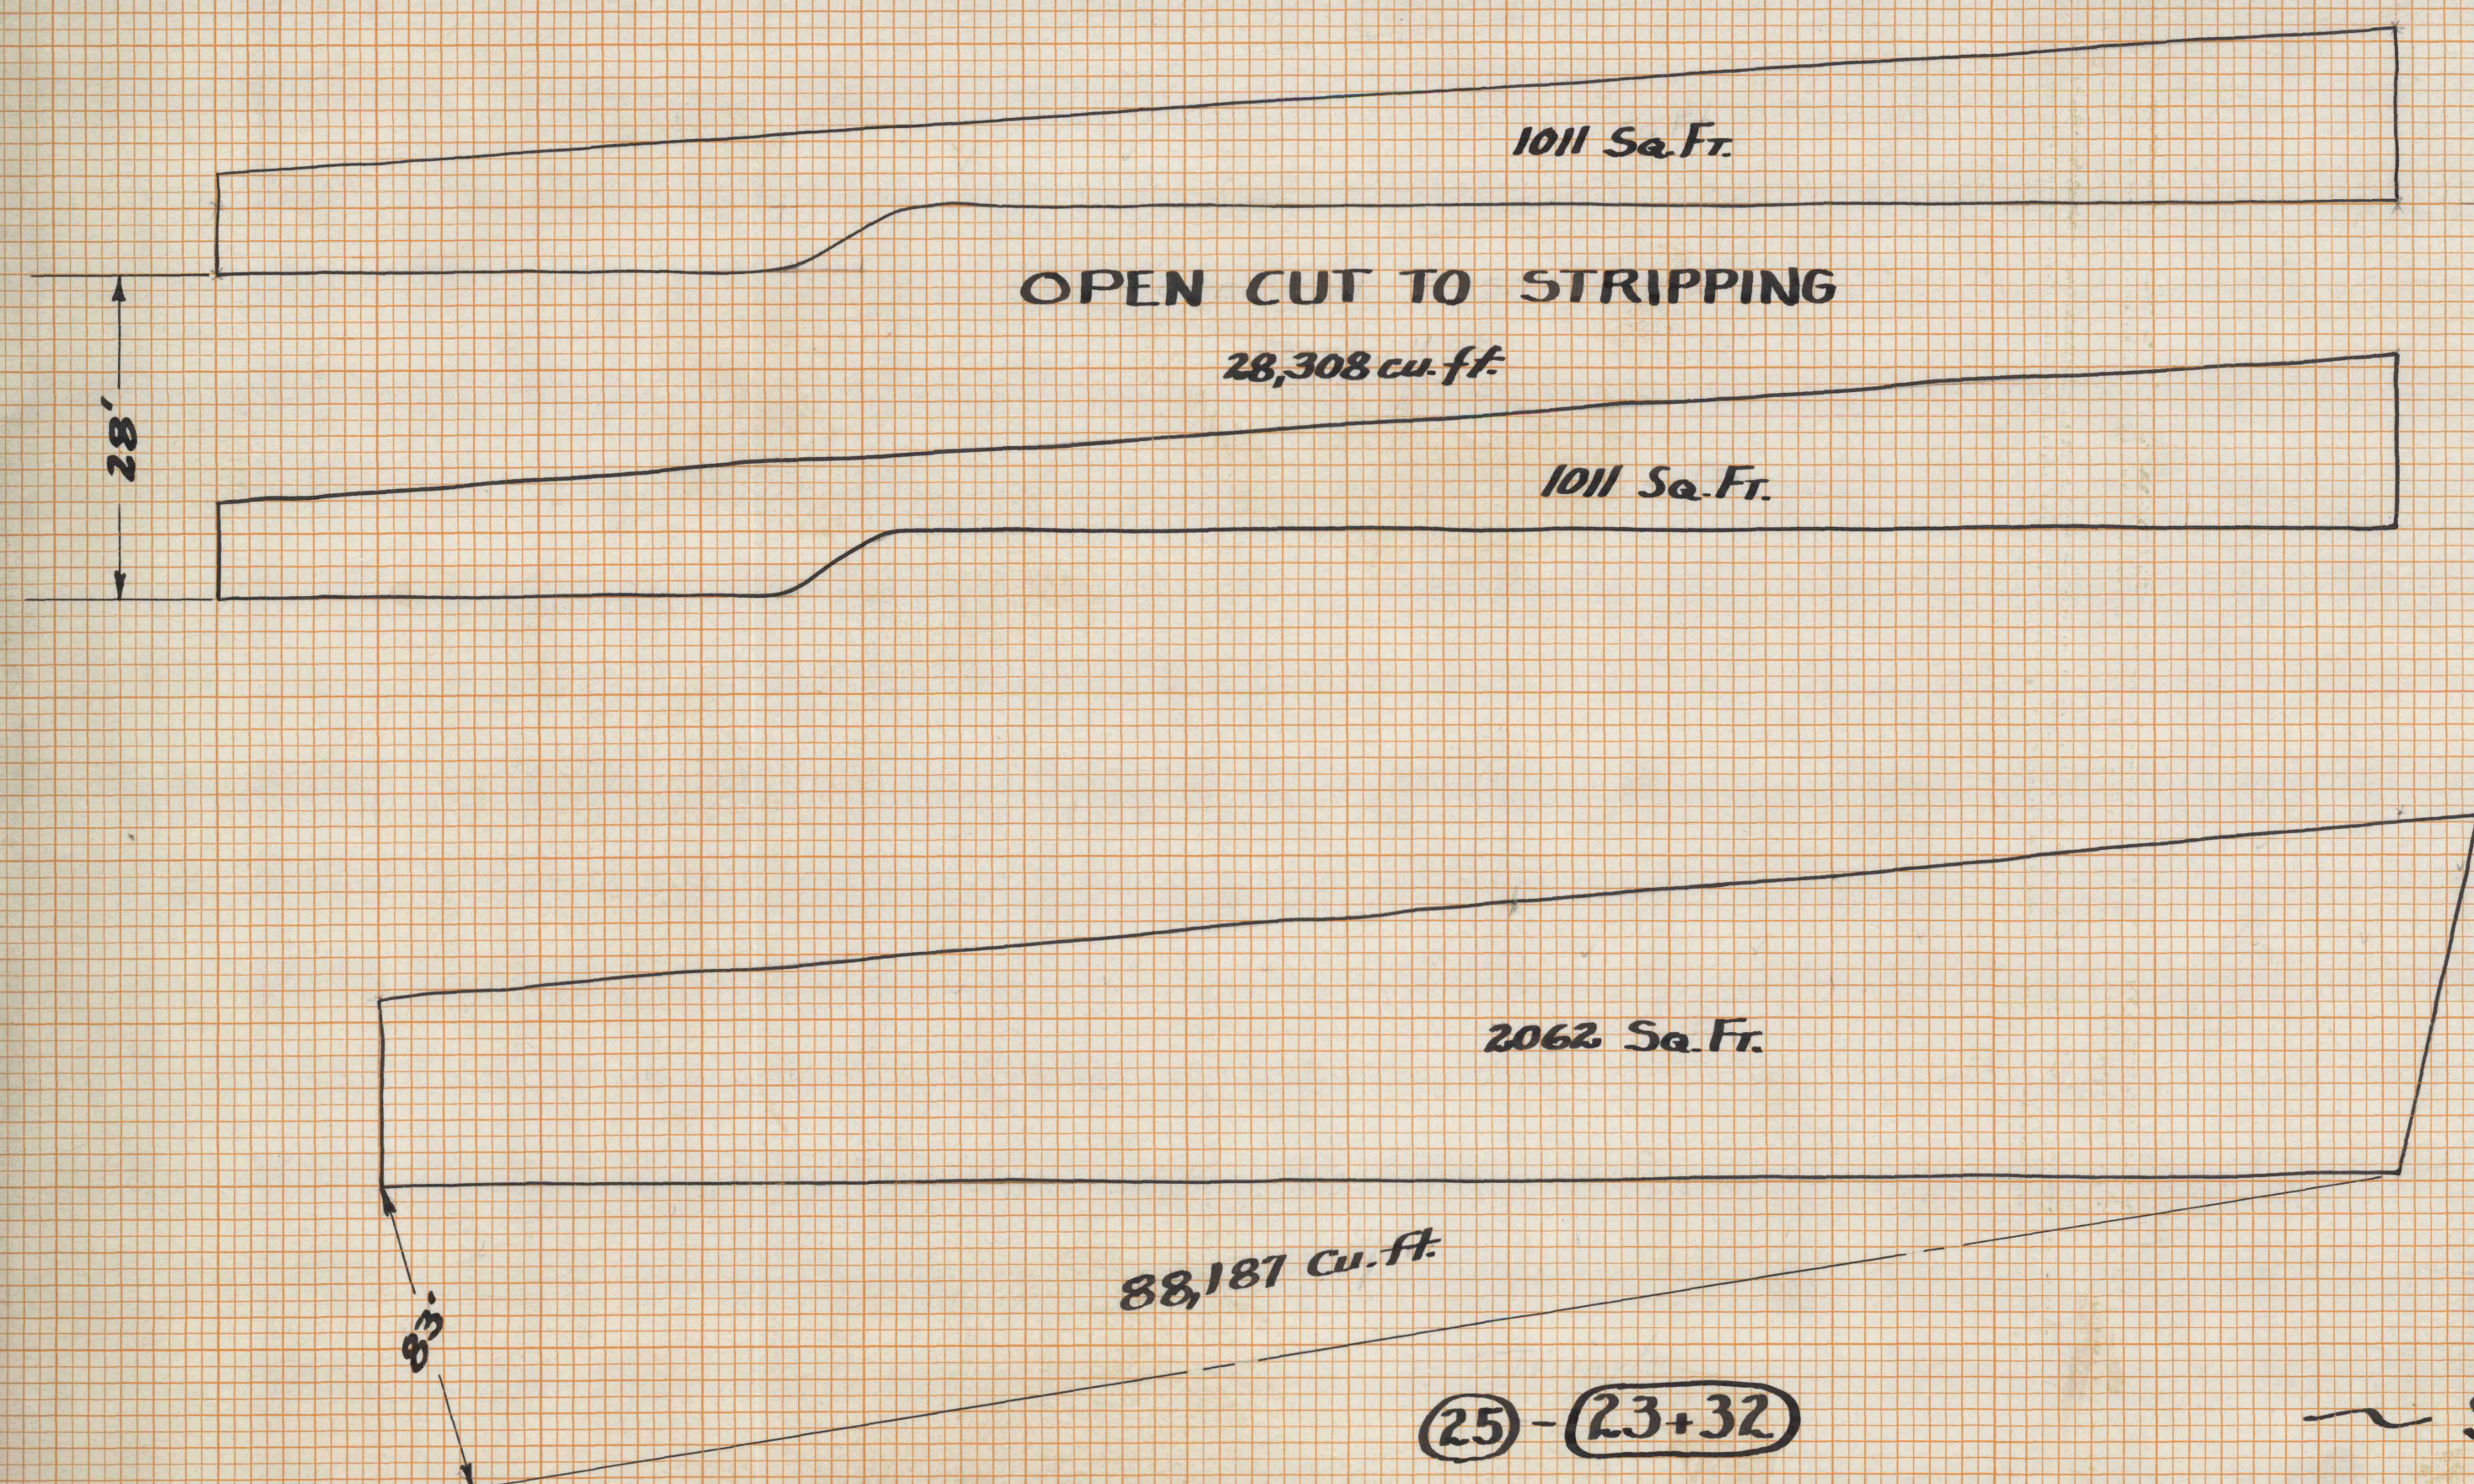

SECTIONS  
1" = 10 Ft.

PLATE 4-CROSS SECTION O.P.R. & E. STANDARD  
KEUFFEL & ESSER CO. NEW YORK

DATE: \_\_\_\_\_  
BY: \_\_\_\_\_  
FINAL SURVEY PLOTTED \_\_\_\_\_  
NOTE BOOK NO. \_\_\_\_\_  
AREAS CHECKED \_\_\_\_\_

DATE: \_\_\_\_\_  
BY: \_\_\_\_\_  
ORIGINAL SURVEY PLOTTED \_\_\_\_\_  
NOTE BOOK NO. \_\_\_\_\_  
AREAS CHECKED \_\_\_\_\_