

REFERENCE DATA

# CRESCENT REFRACTORIES CO.

CURWENSVILLE, CLEARFIELD COUNTY, PA.

ENGINEERING DEPARTMENT

ENV. No. R<sub>2</sub>

SHEET No. 54.


50-3-472

ISAAC BLACK AND O. BRUNETTI PROPERTIES

SCALE 50' = 1"

PINE STREET, CURWENSVILLE, PA.

DATE MAR., 5, 1921.

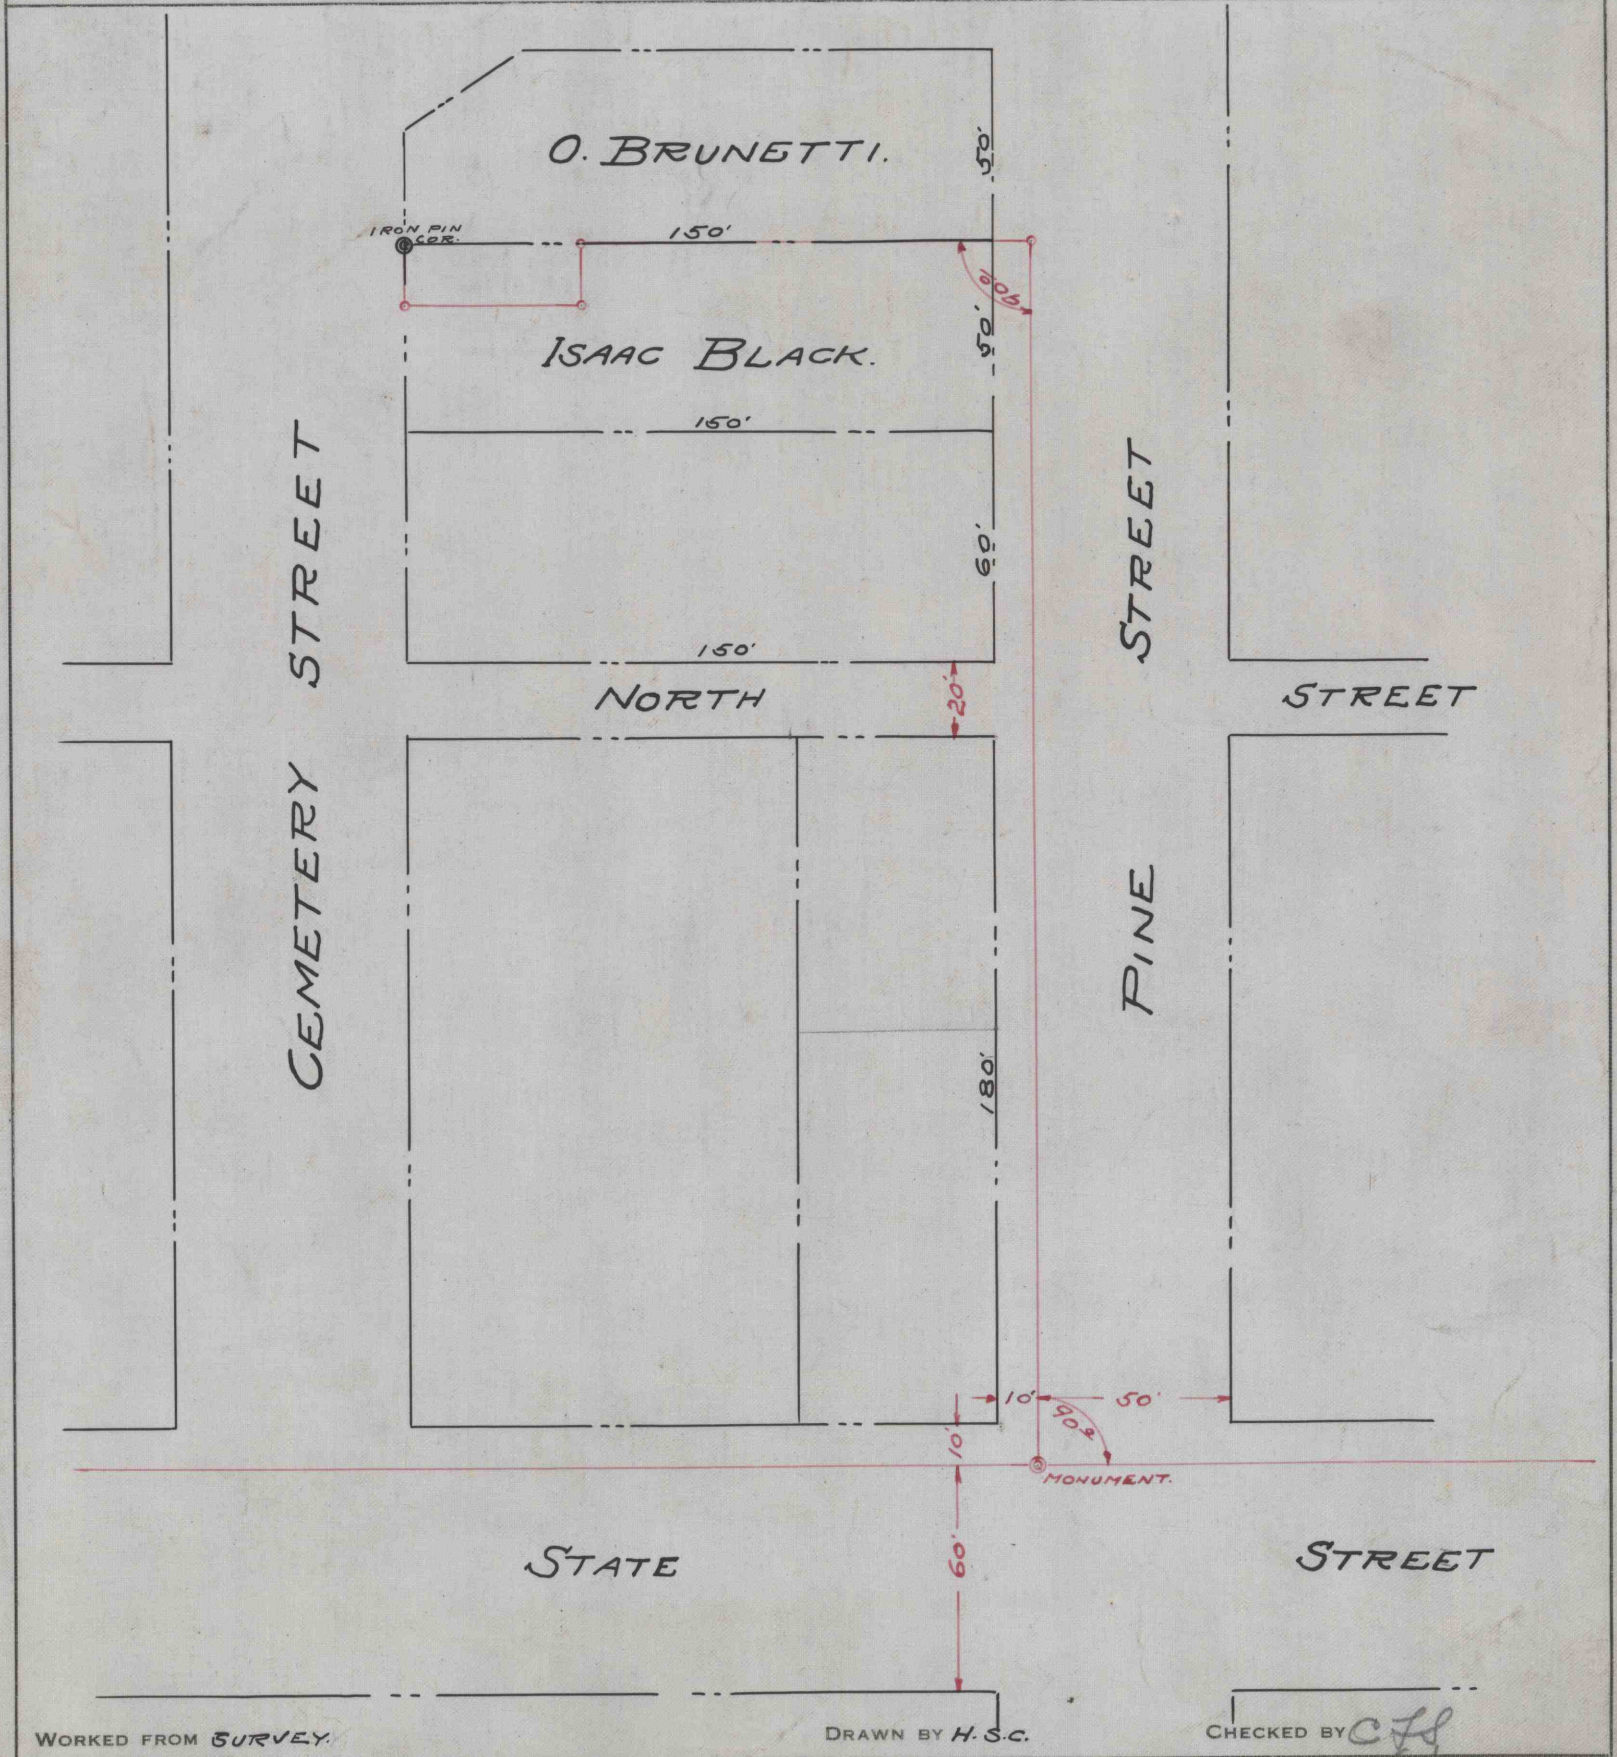

WORKED FROM SURVEY.

DRAWN BY H. S. C.

CHECKED BY *CH*

92000-1119