
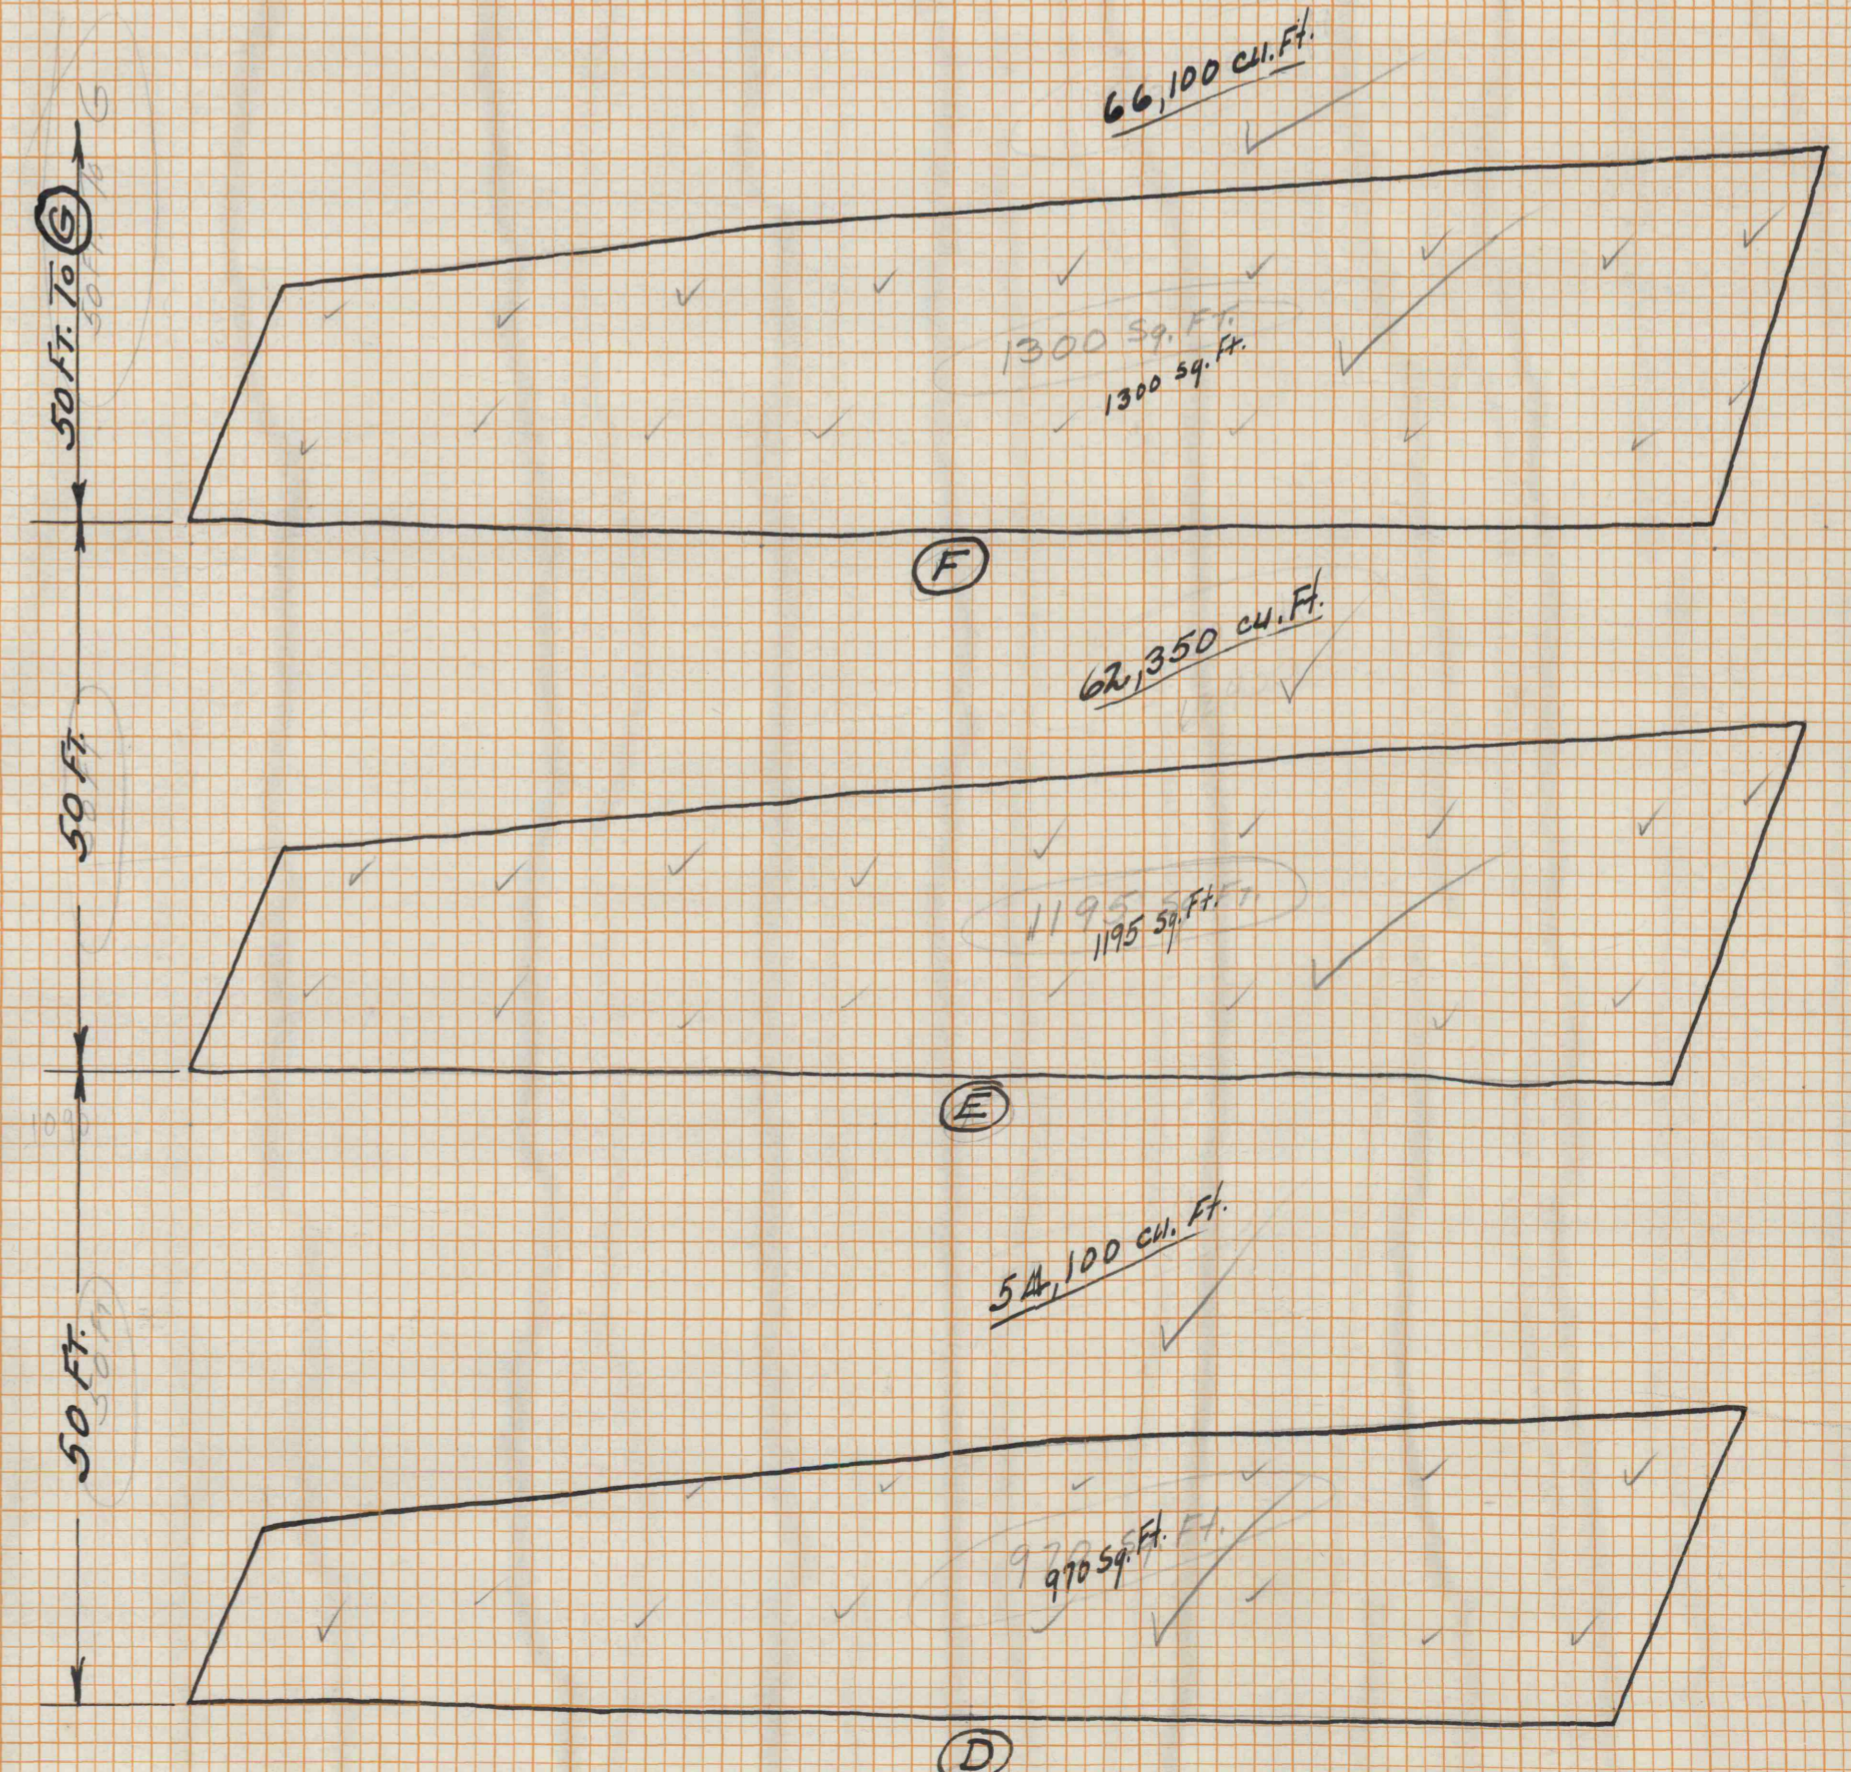
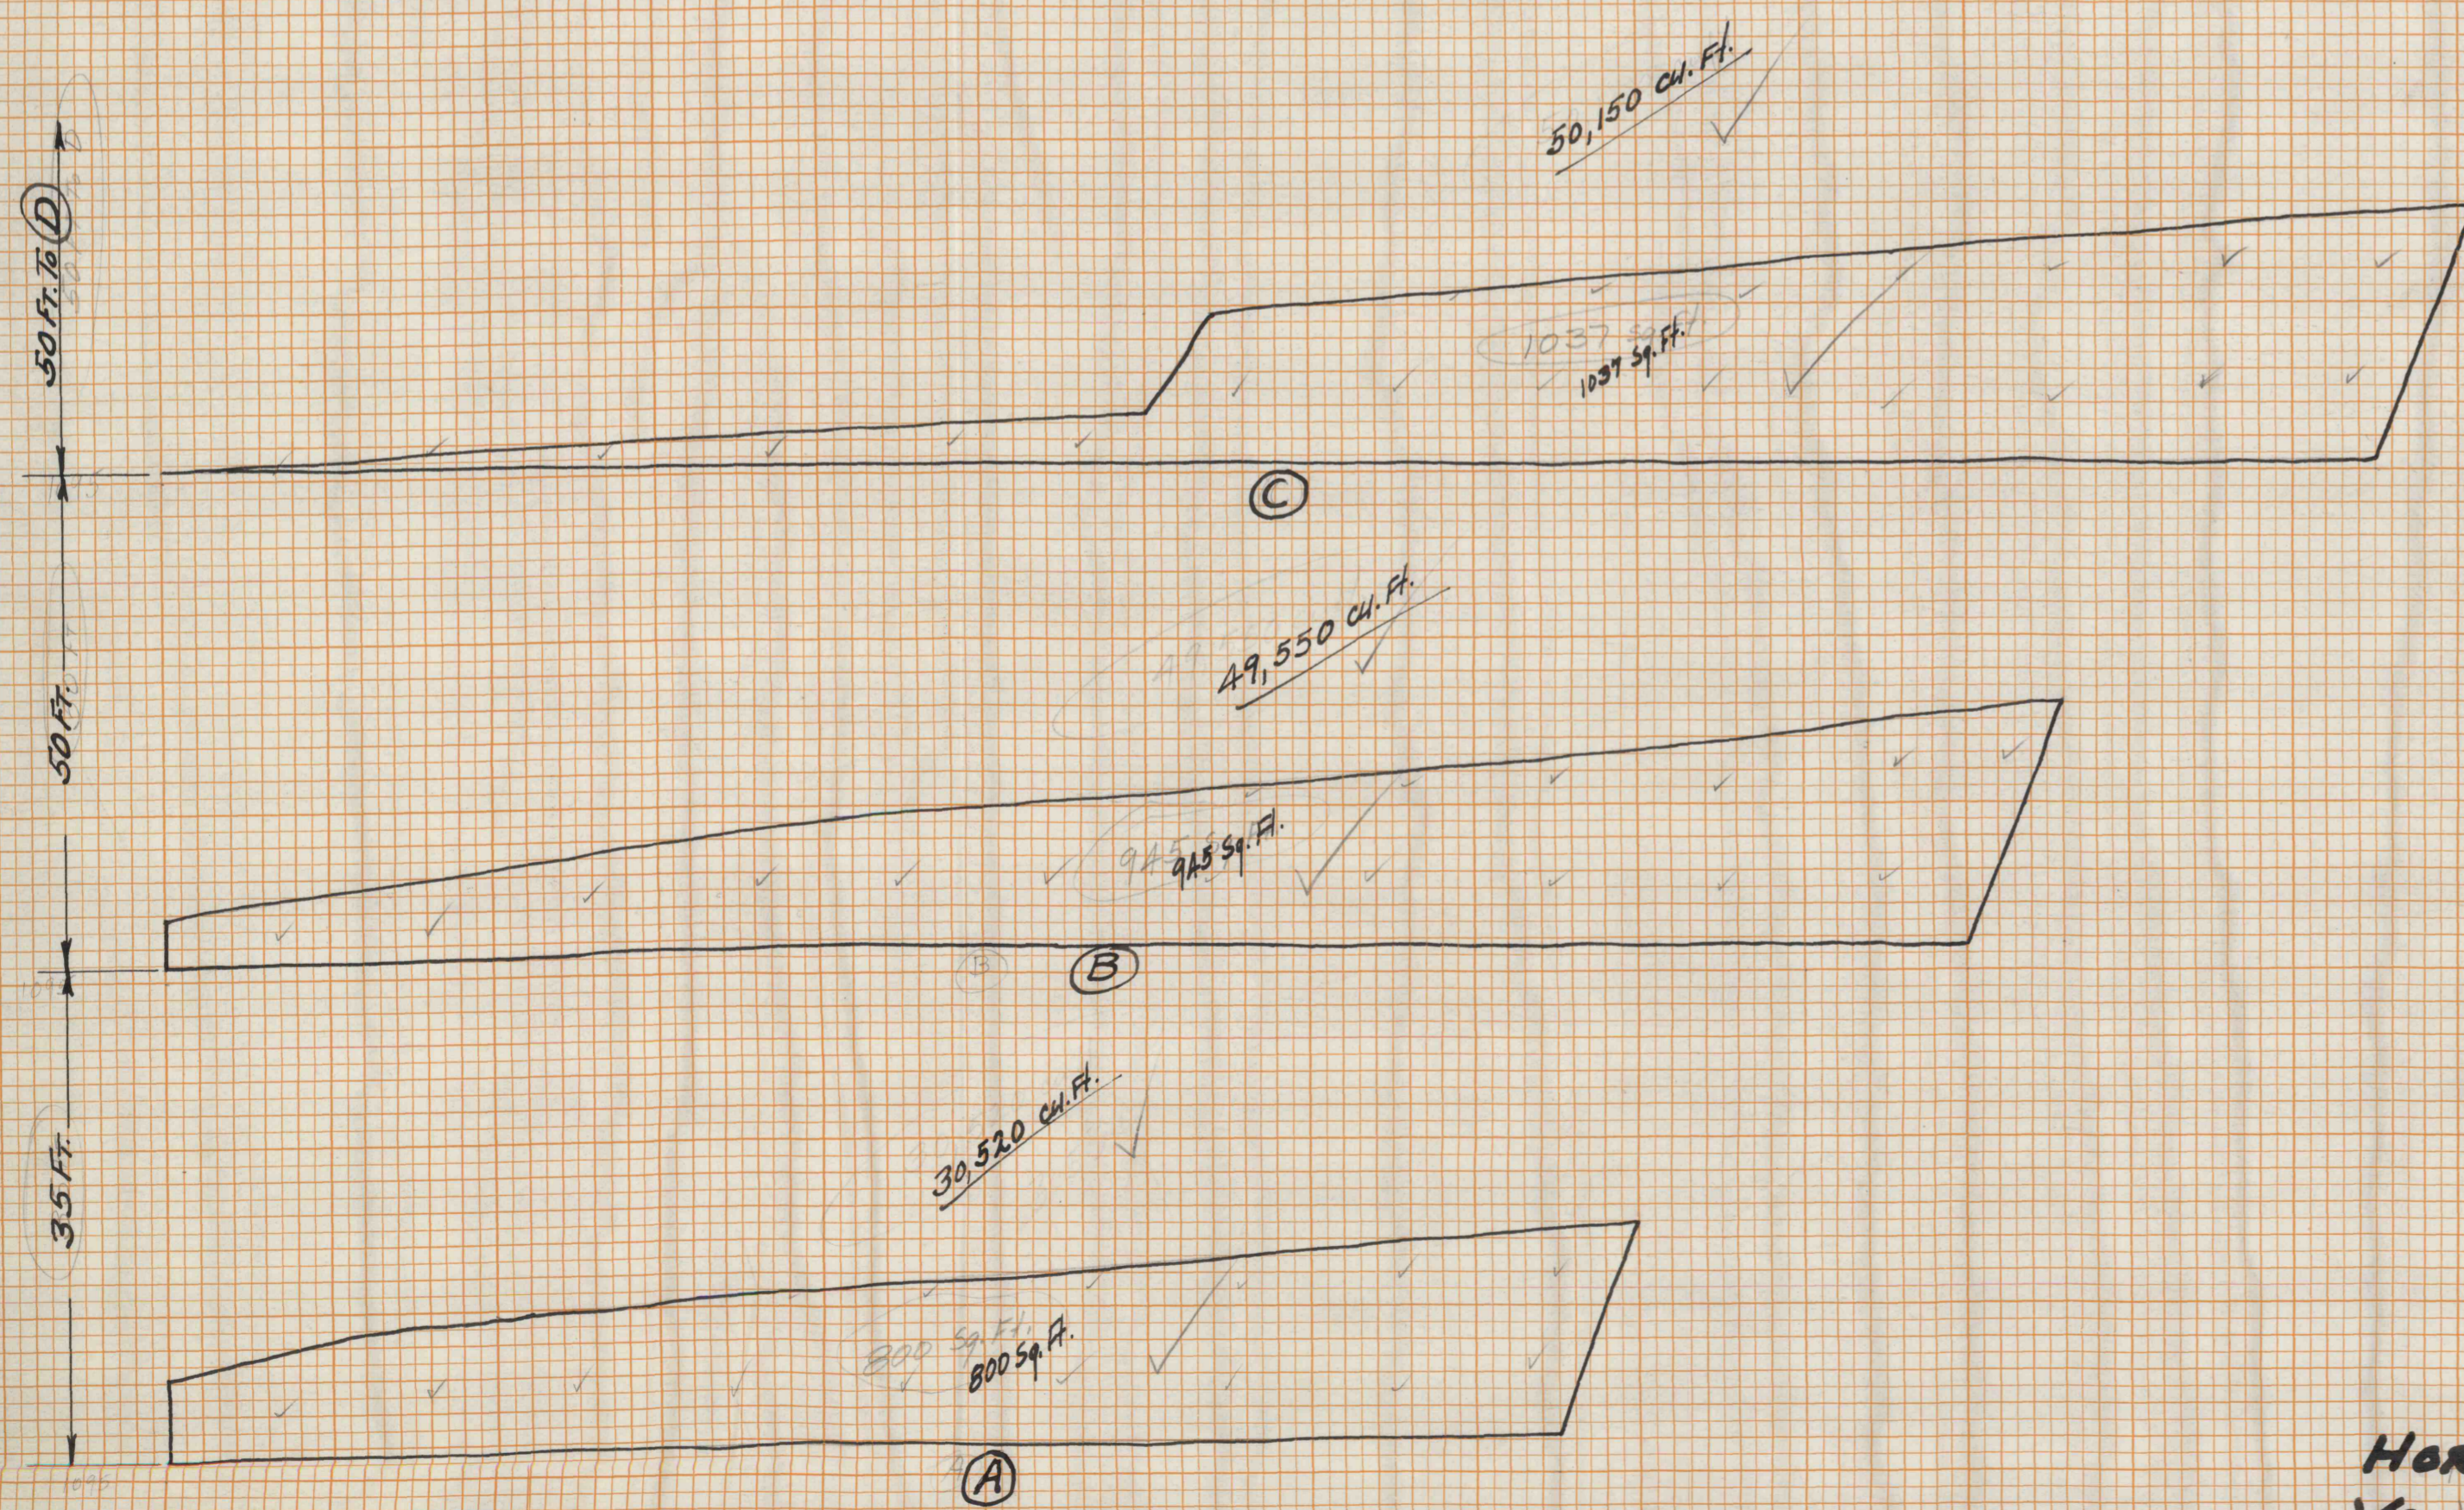
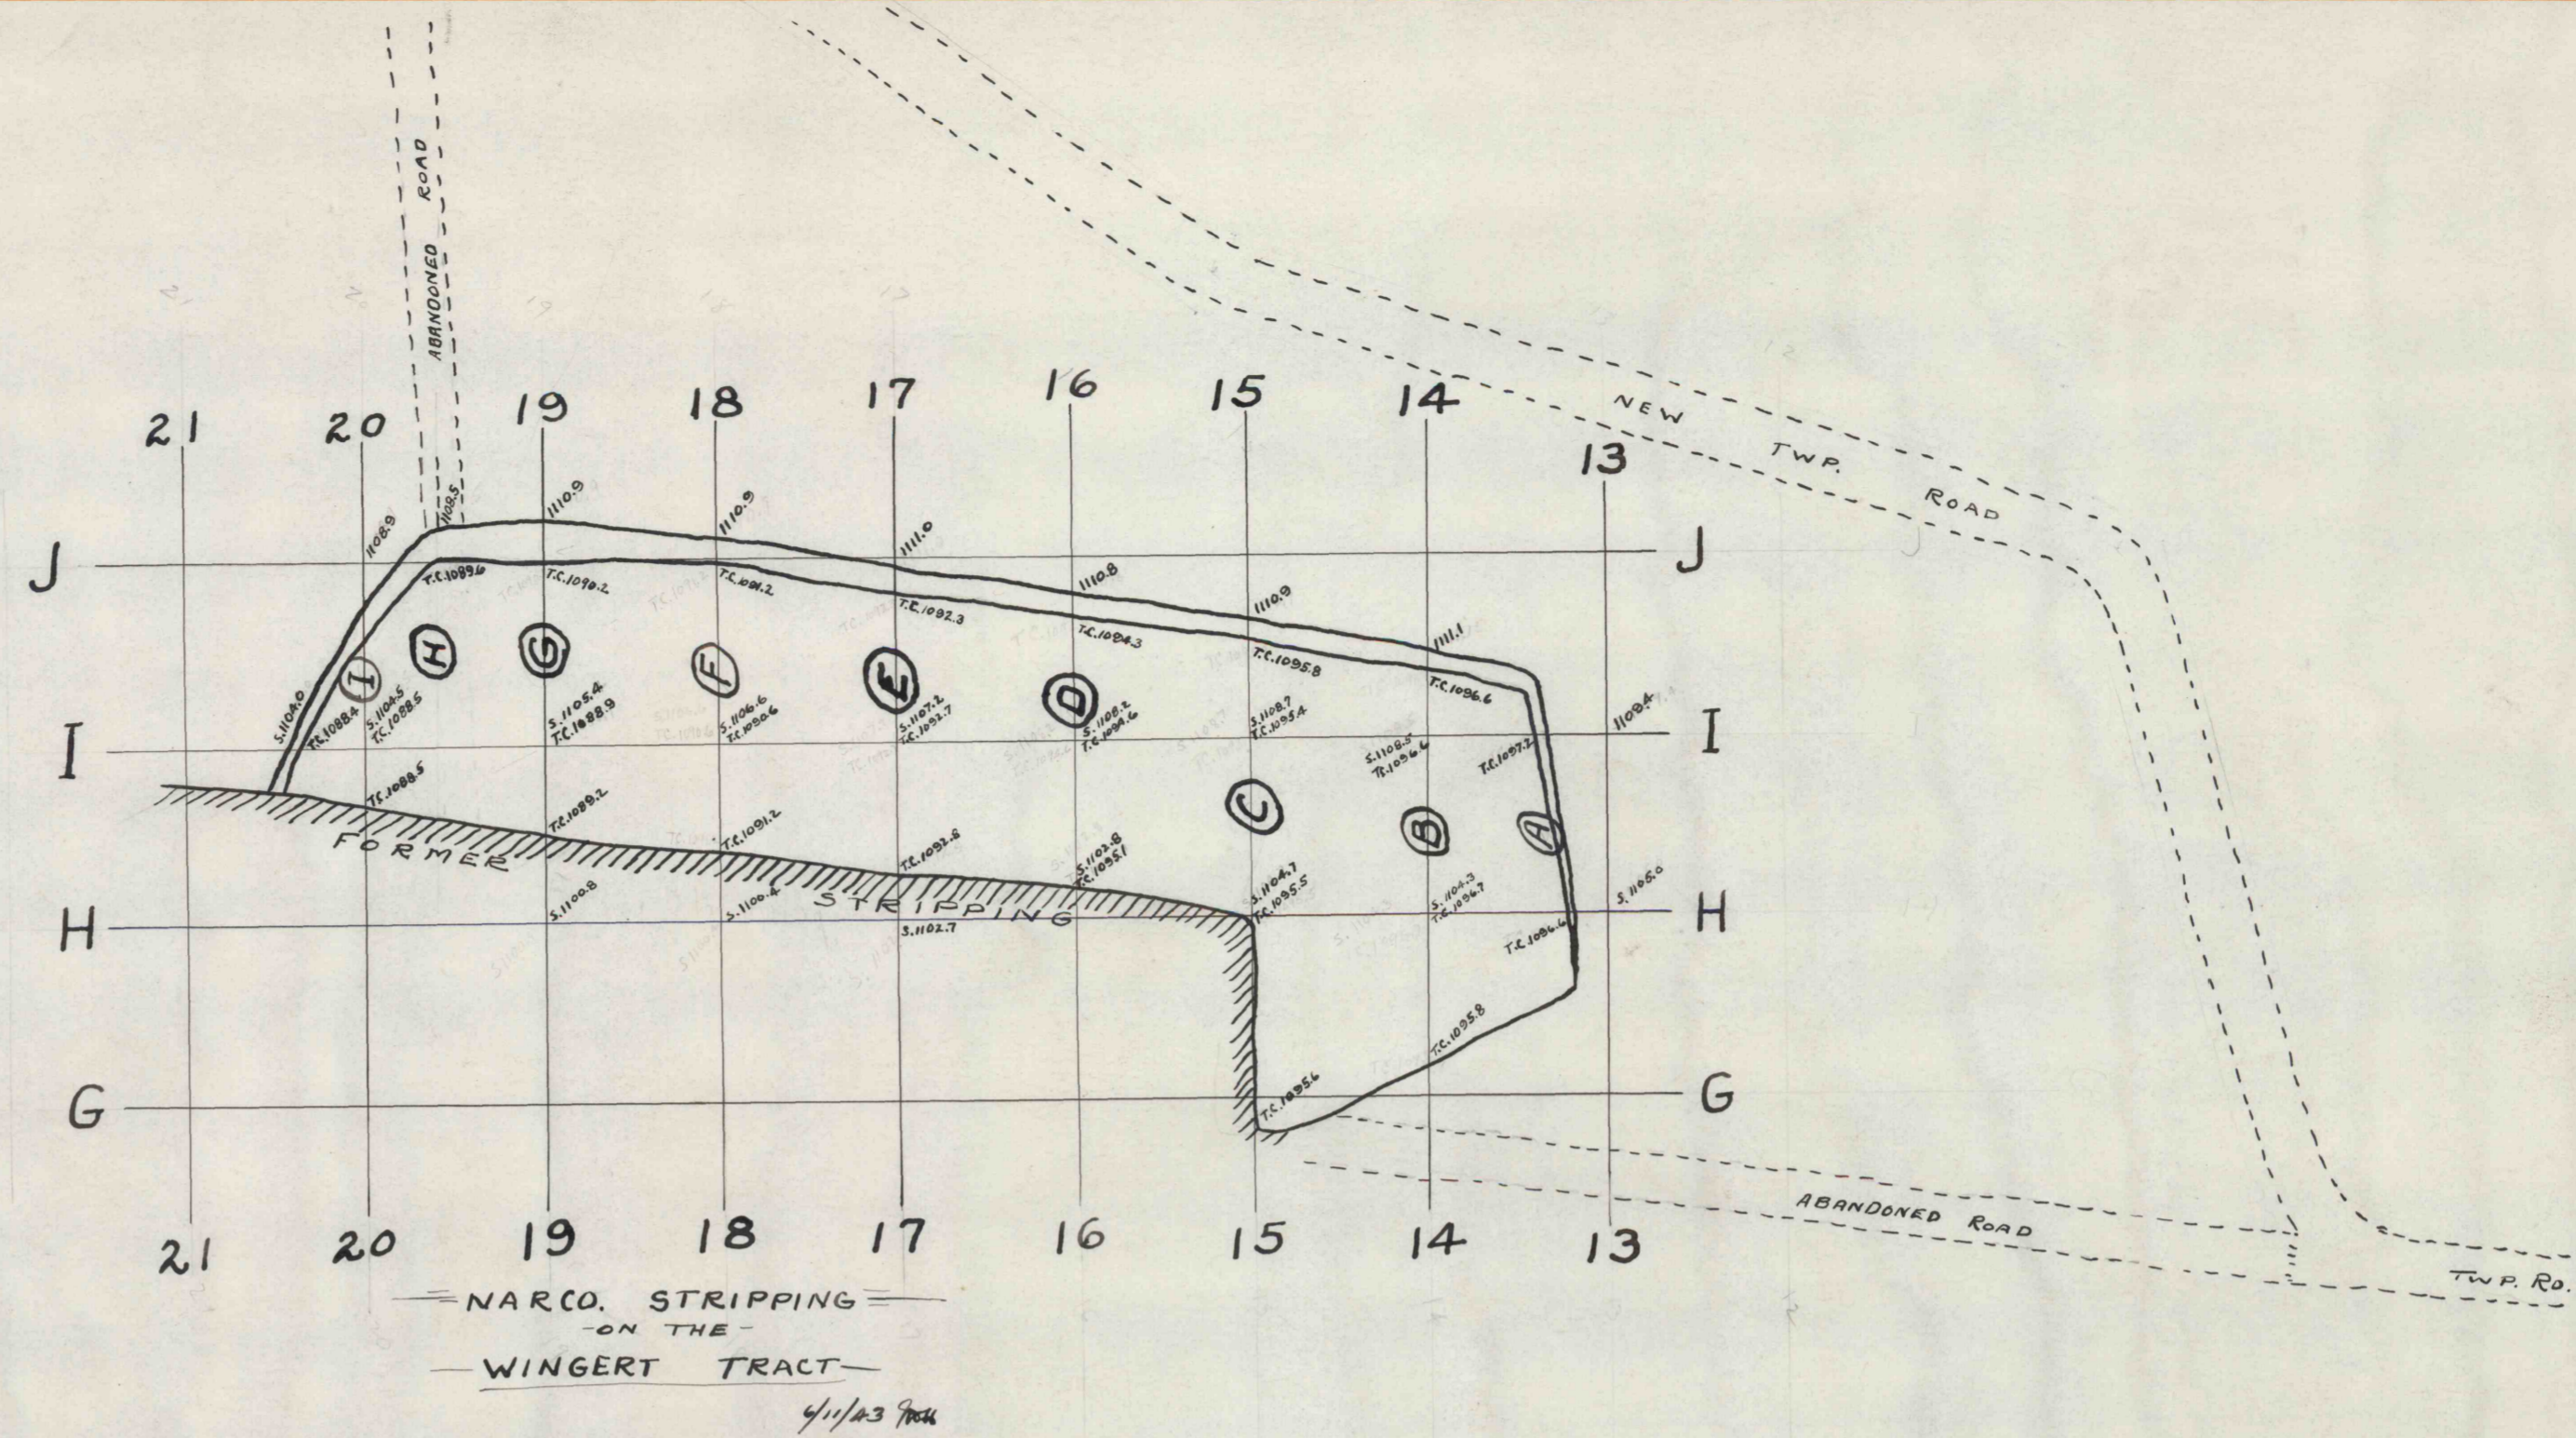


FINAL SURVEY SURVEYED BY DATE
 PLOTTED BY
 TEMPLATE NO.
 NOTE BOOK NO.
 AREAS CHECKED

ORIGINAL SURVEY SURVEYED BY DATE
 PLOTTED BY
 TEMPLATE NO.
 NOTE BOOK NO.
 AREAS CHECKED

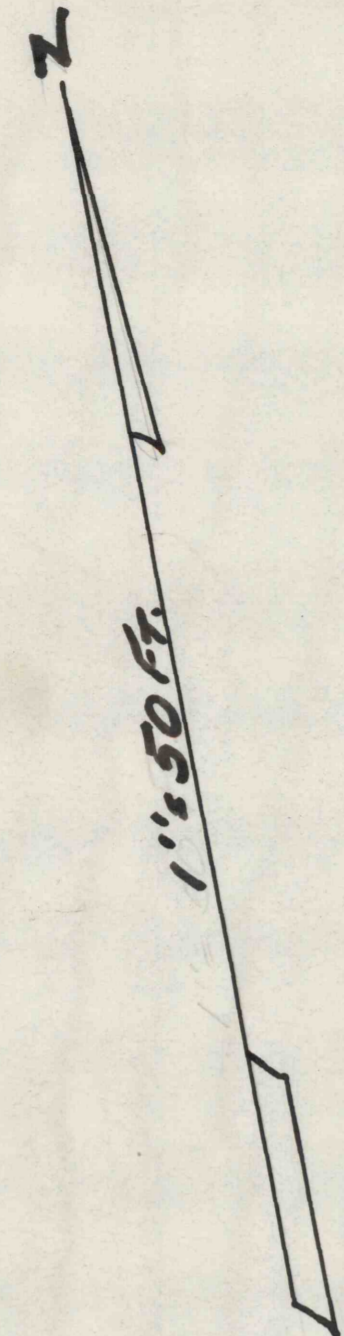

HORIZ. 1" = 10 FT.
 VERT. 1" = 10 FT.

4/10/24 984
 6/11/43 107112