


PLAN
1" = 50 Ft.

NORTH AMERICAN REFRACTORIES CO.
WINGERT TRACT
1949 STRIPPING
SURVEYED 9-13-49


No. 51-2-46

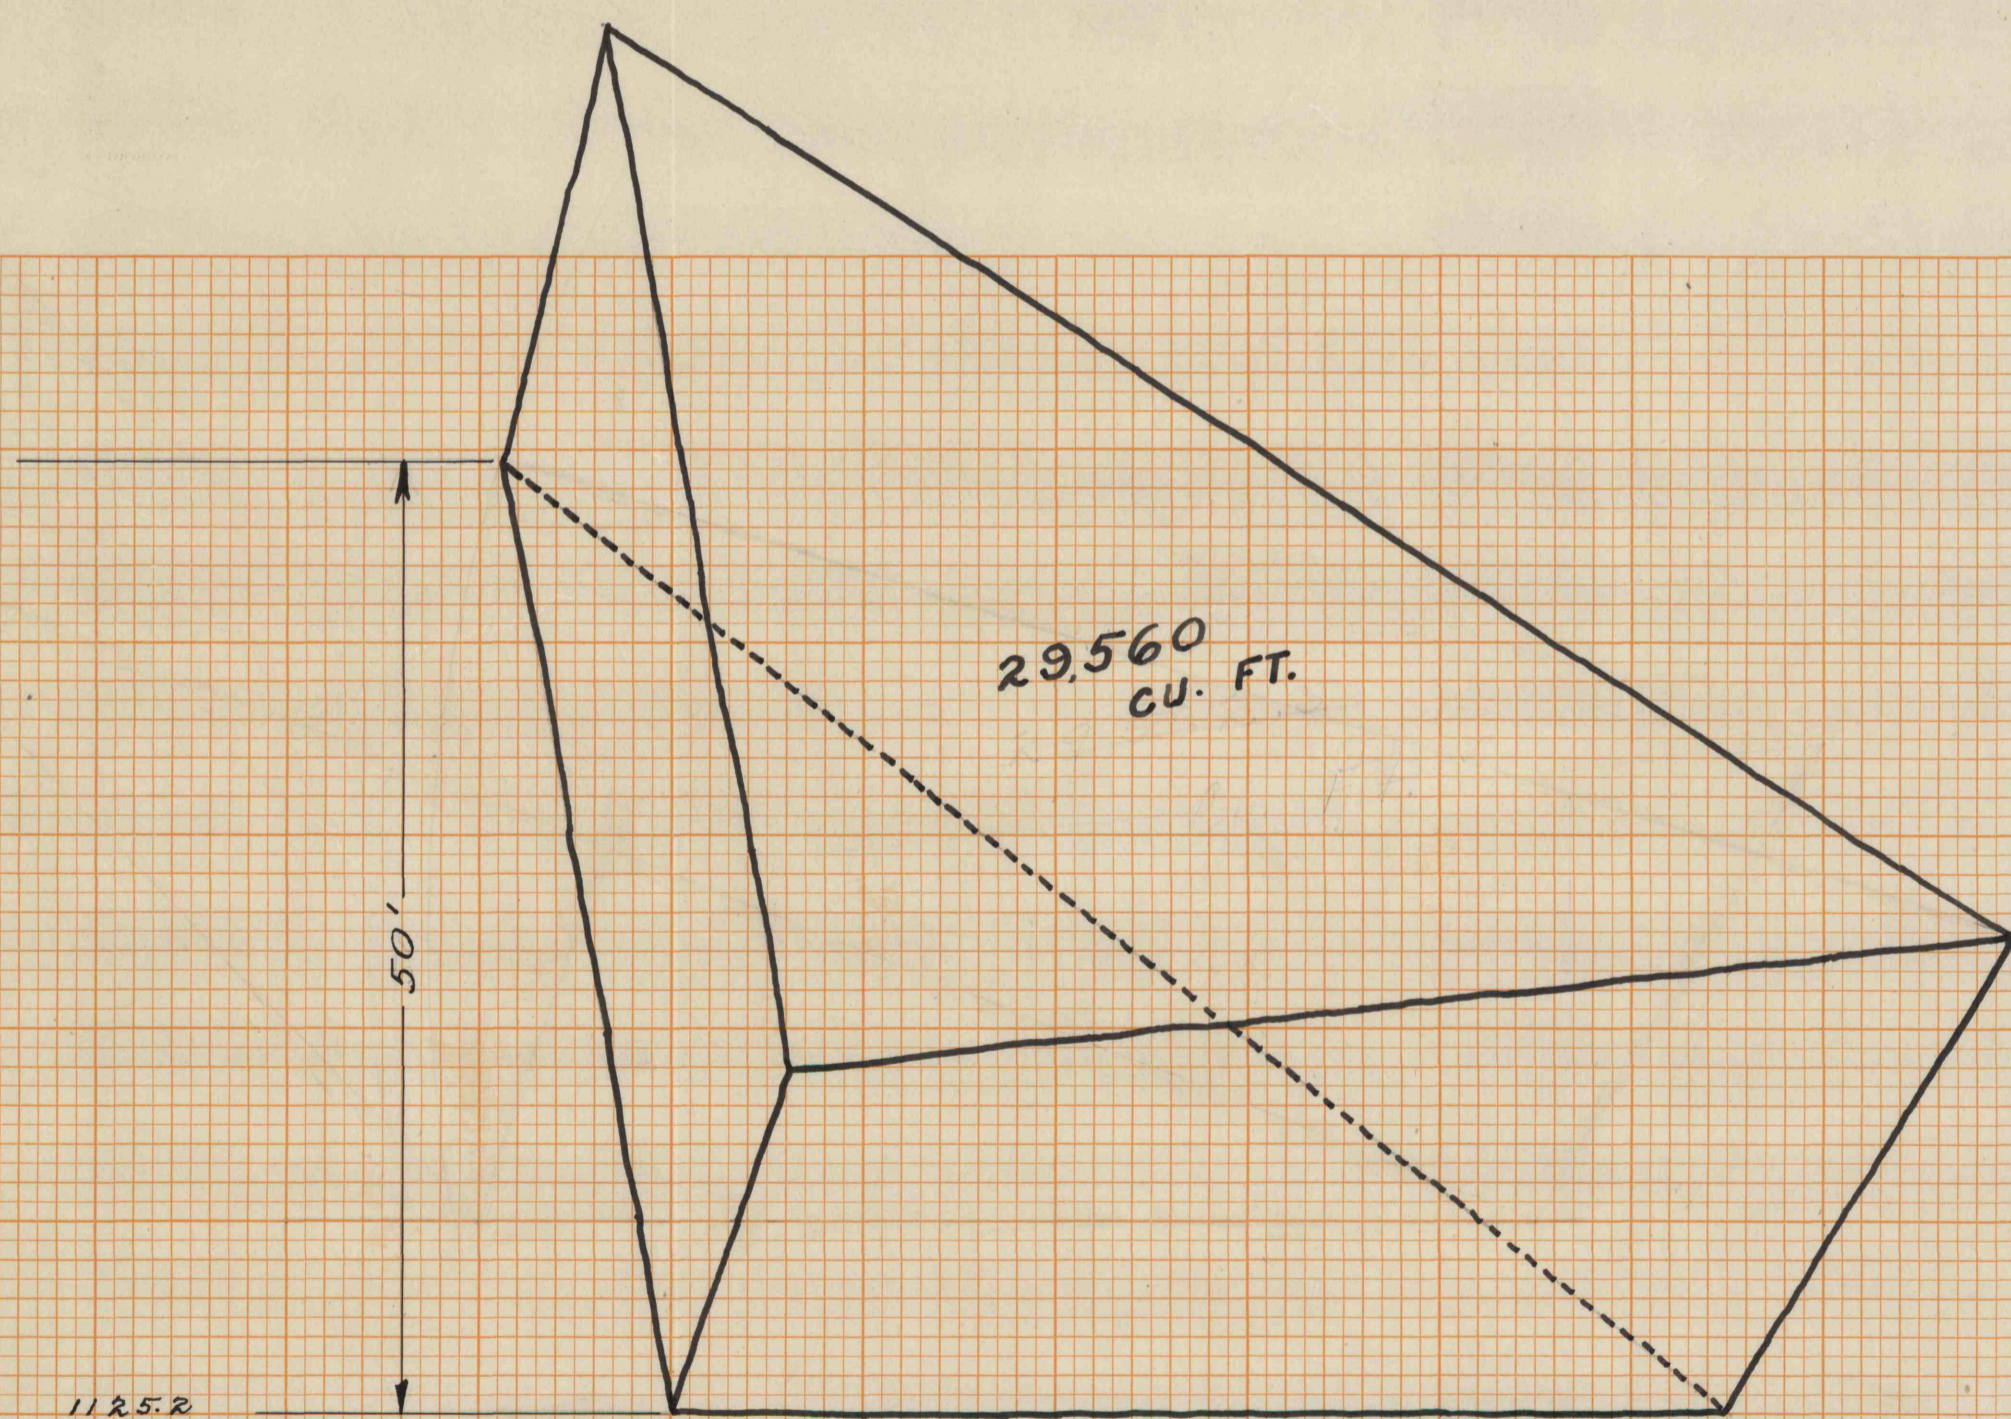

29,560
CU. FT.


50'

End Section

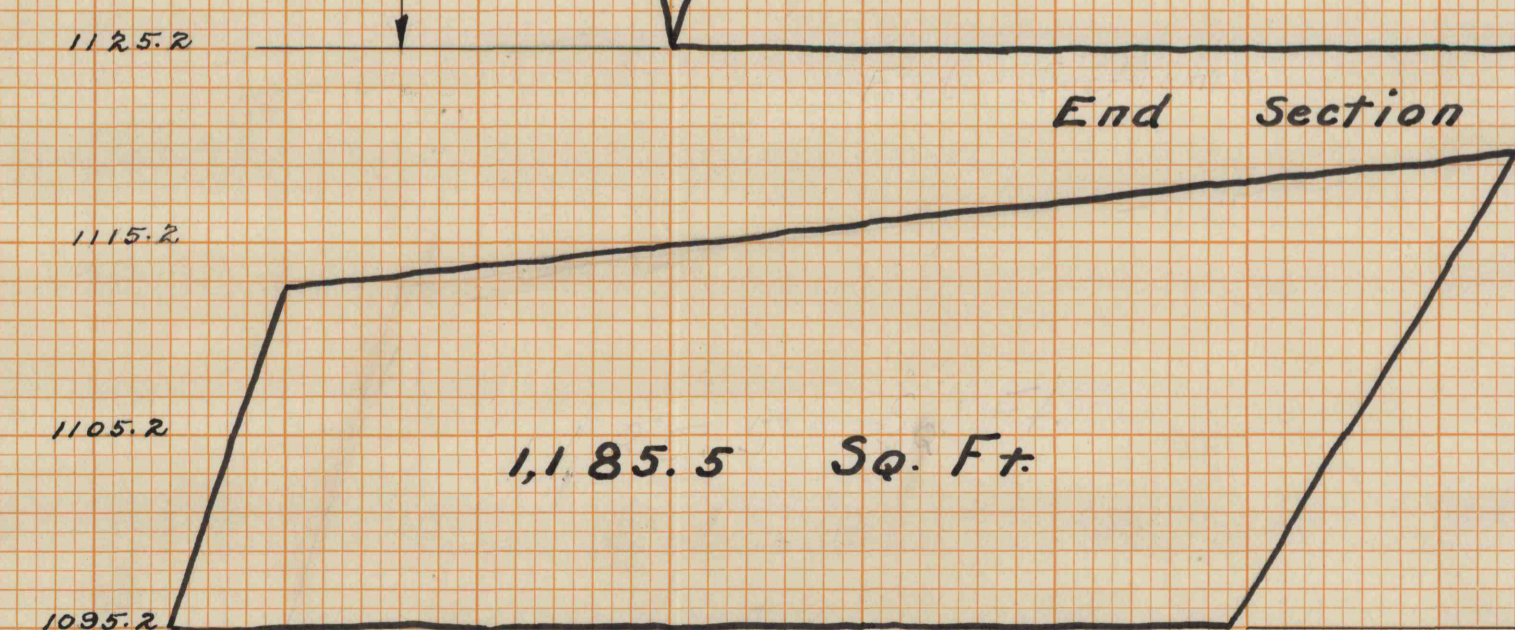

1,185.5 Sq. Ft.


Section A

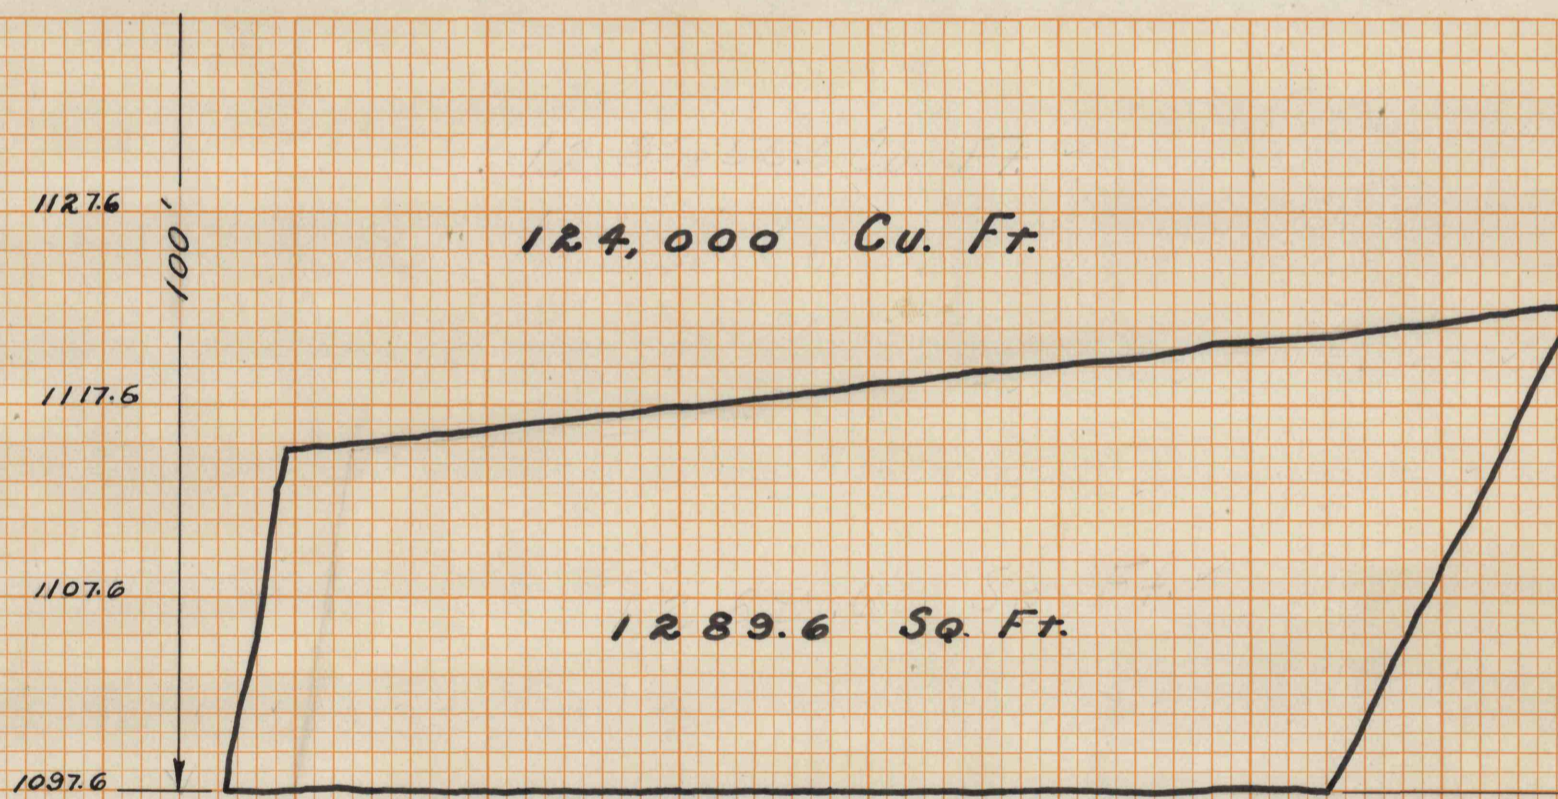

12,89.6 Sq. Ft.


Section B

139,300 Cu. Ft.

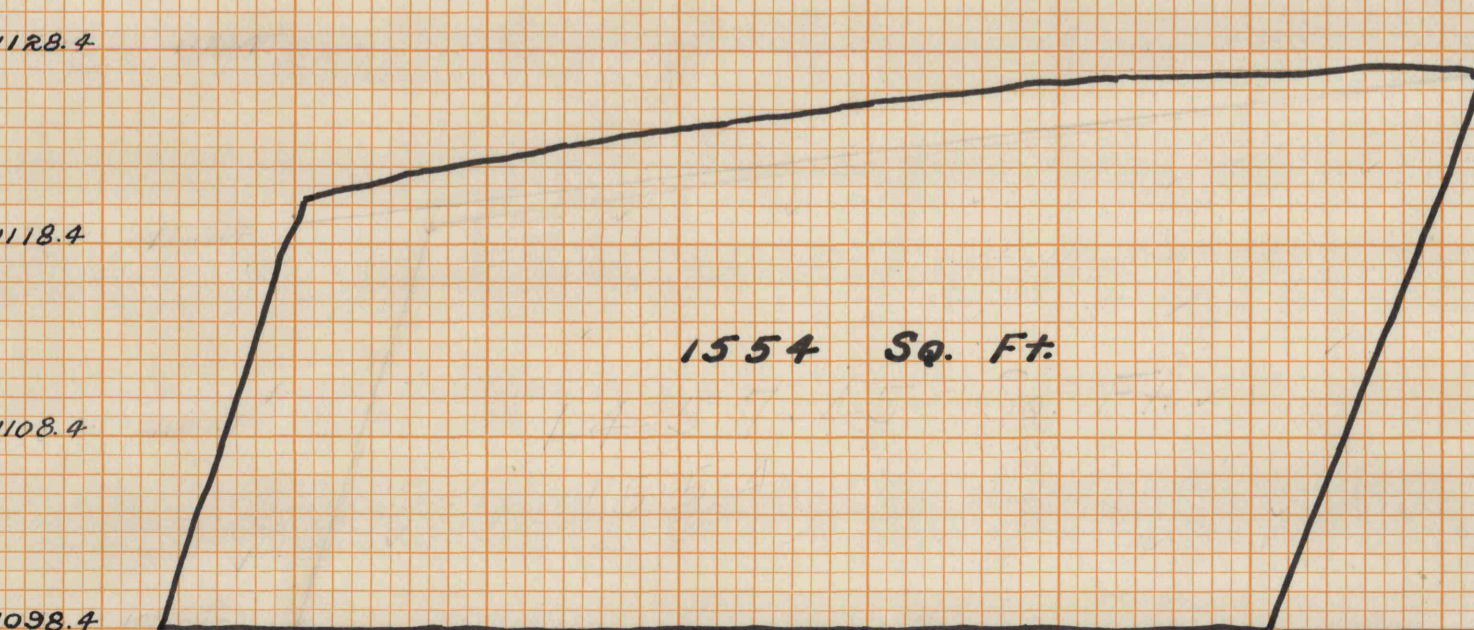

1,554 Sq. Ft.


Section C

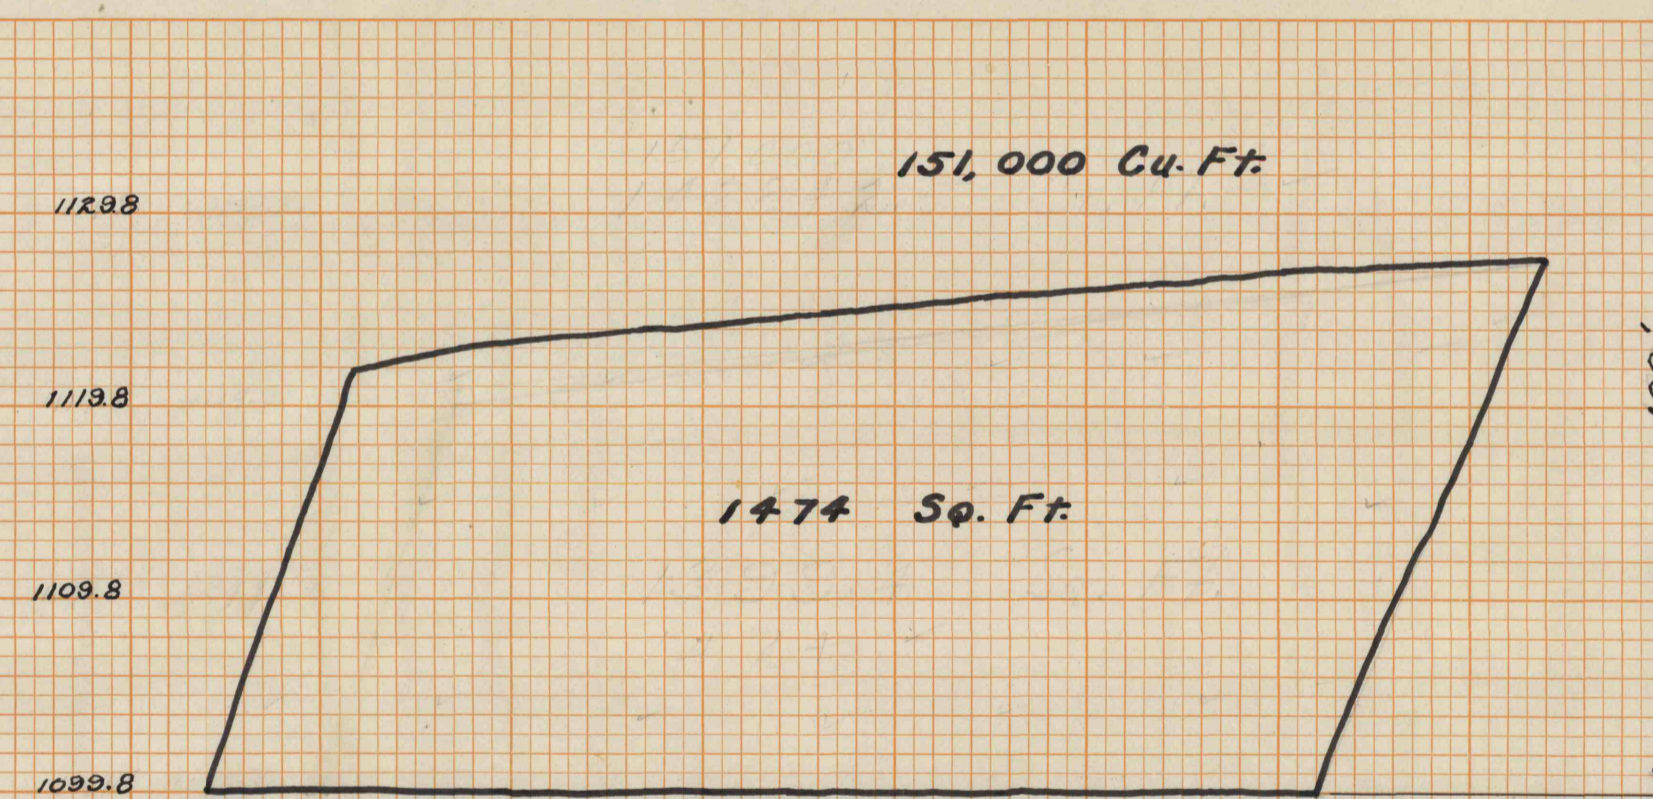

1474 Sq. Ft.

Section D

147,100 Cu. Ft.

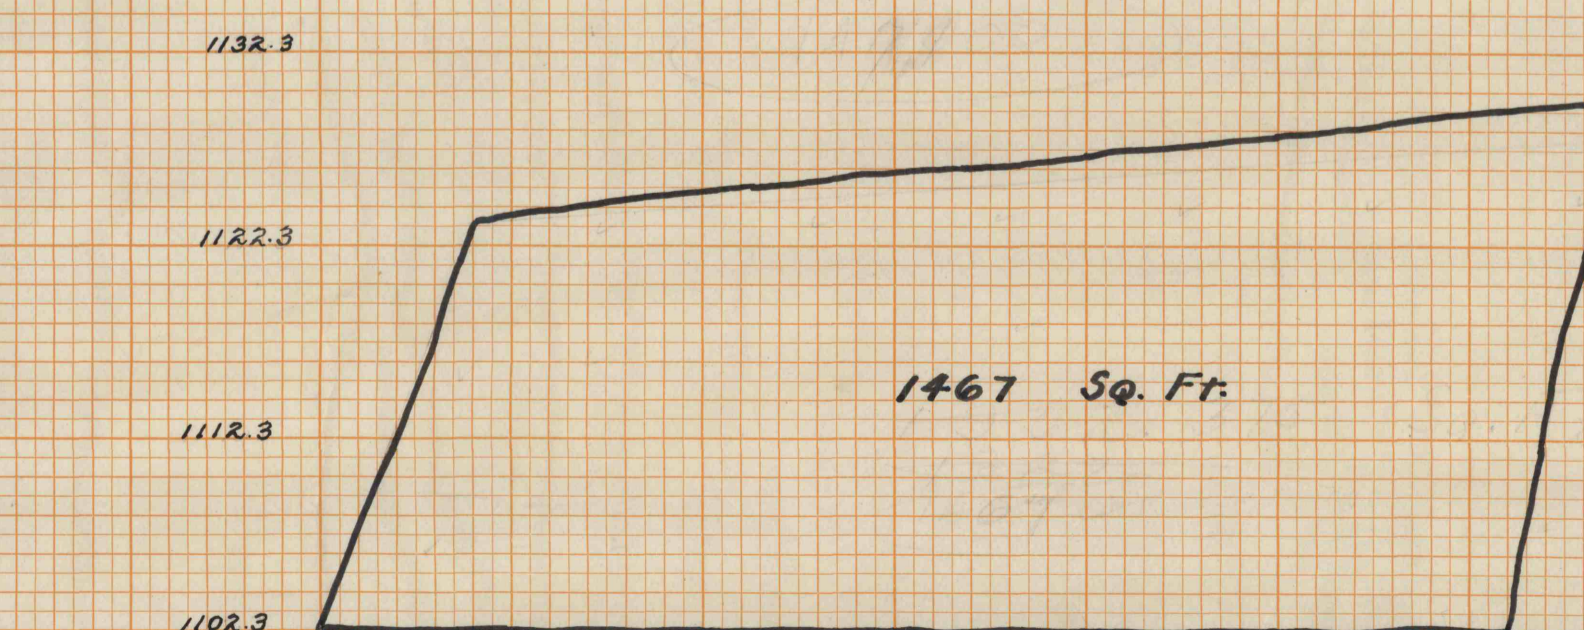

1,467 Sq. Ft.

Section E

Sections 1" = 10'

FINAL SURVEY PLOTTED
NOTE BOOK AREAS CHECKED

ORIGINAL SURVEY PLOTTED
NOTE BOOK AREAS CHECKED