
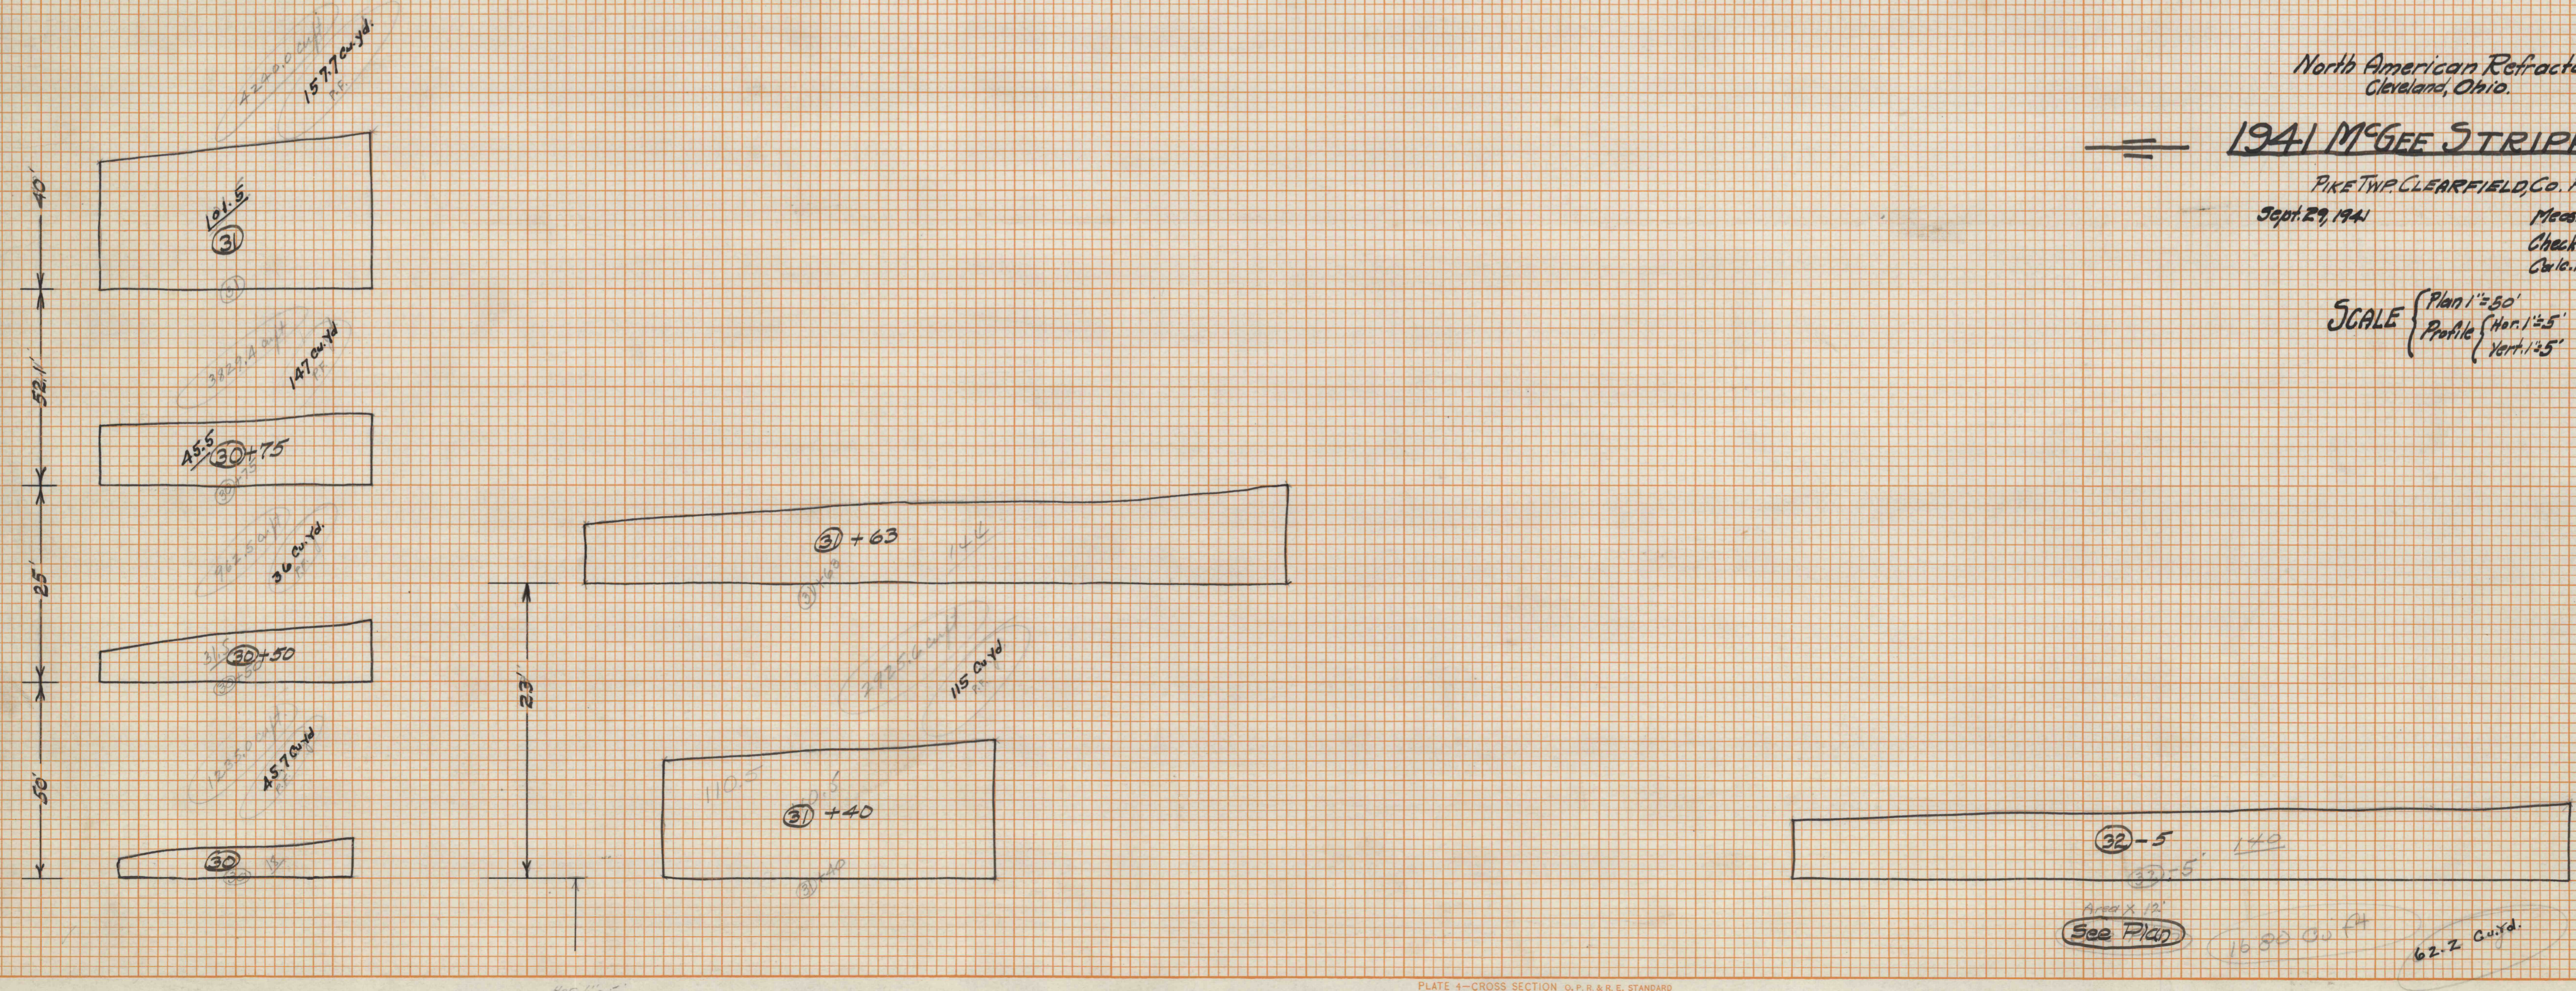


FINAL SURVEY
 NO. _____
 DATE _____
 BY _____
 SURVEYED _____
 PLOTTED _____
 TEMPLATE _____
 NOTE BOOK _____
 AREAS CHECKED _____

ORIGINAL SURVEY
 NO. _____
 DATE _____
 BY _____
 SURVEYED _____
 PLOTTED _____
 TEMPLATE _____
 NOTE BOOK _____
 AREAS CHECKED _____

20641
 22-3-14B

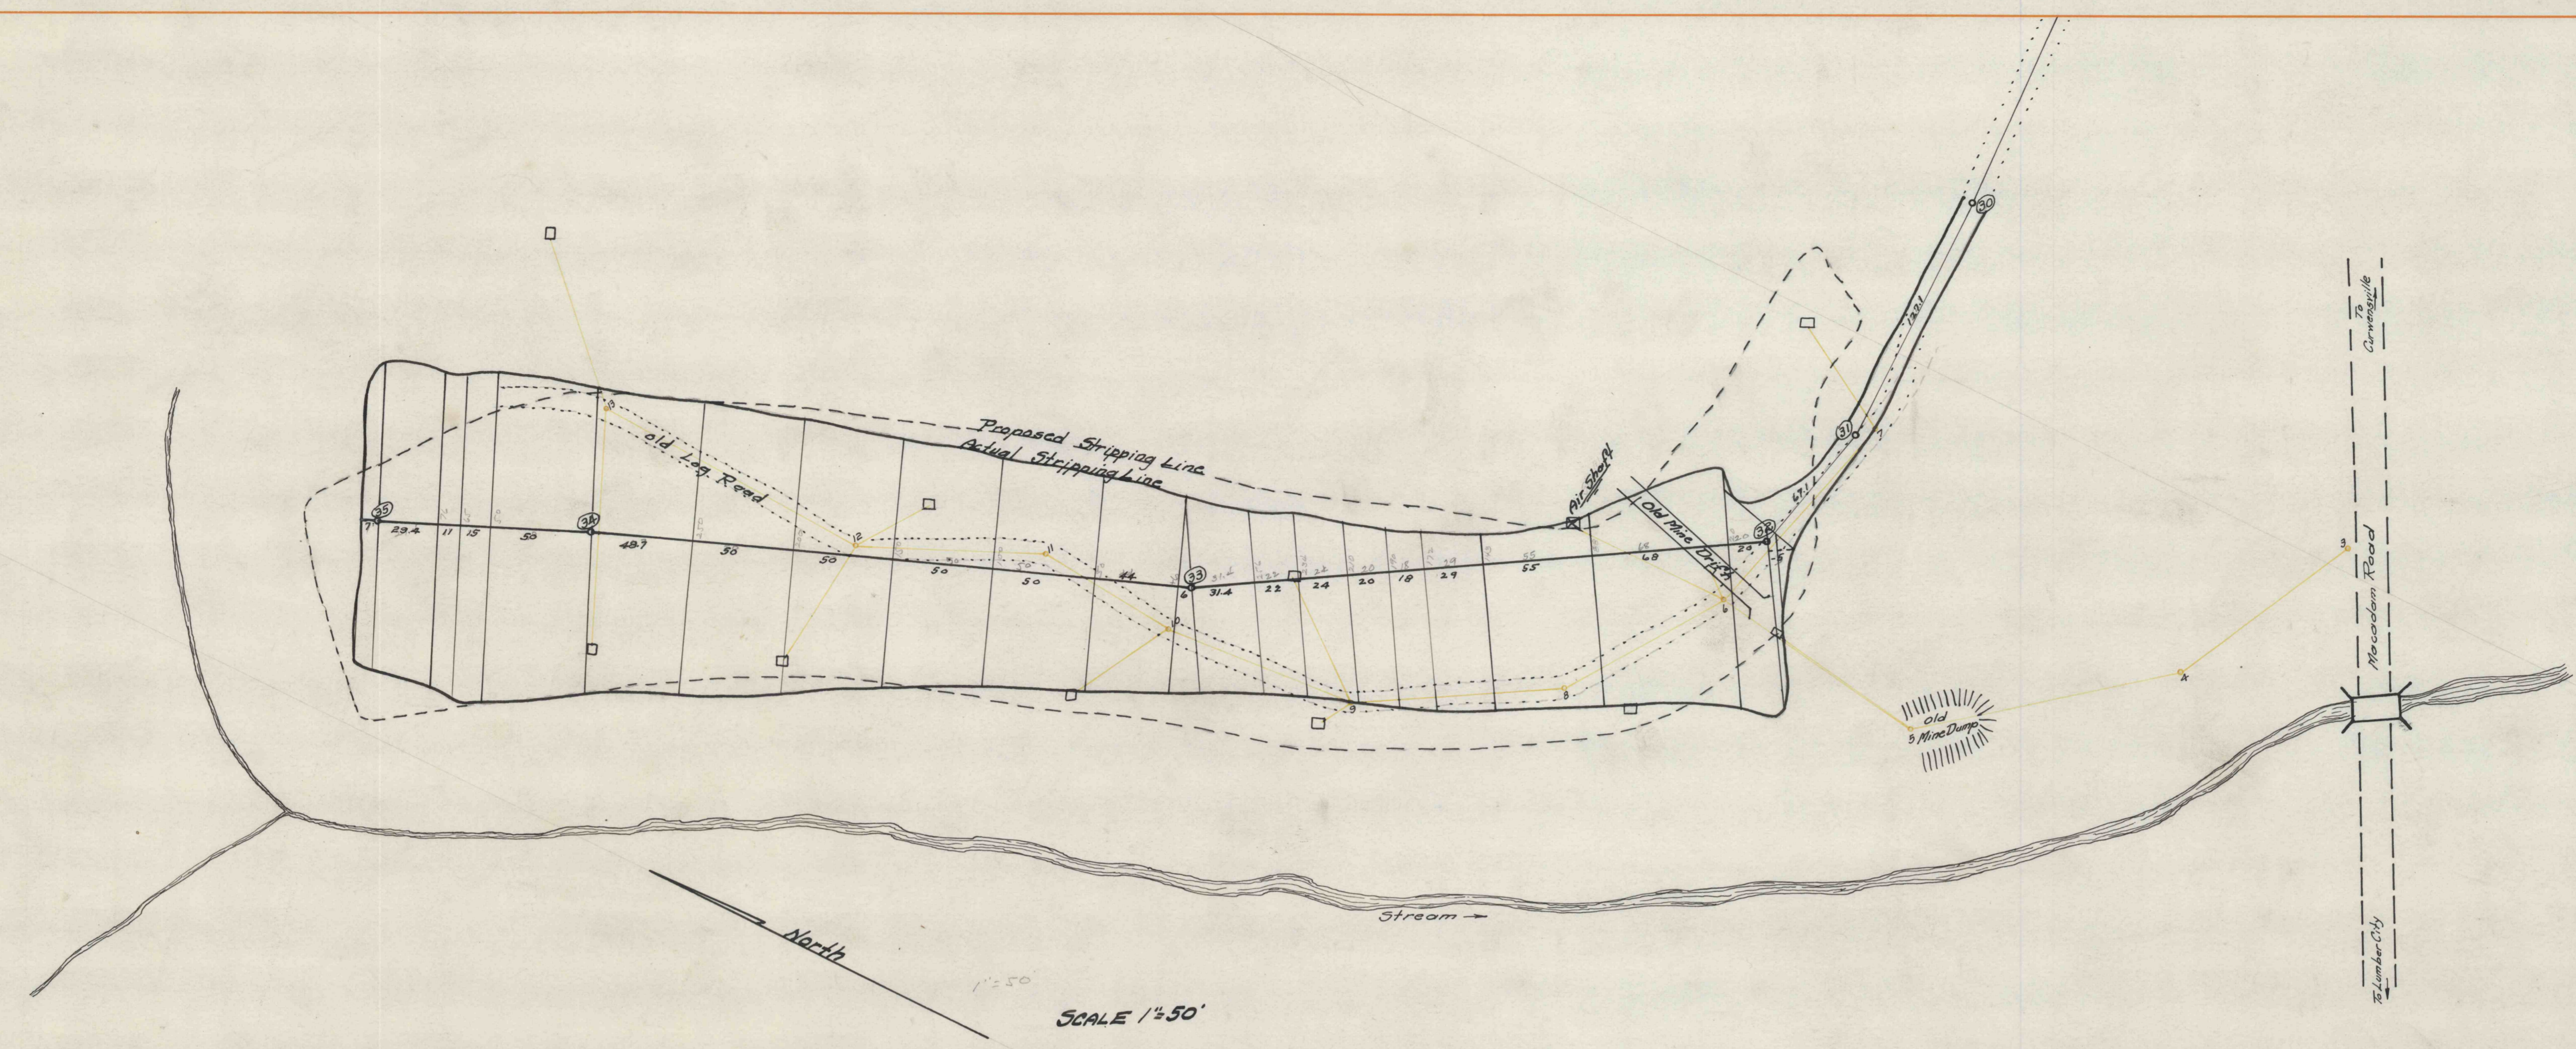

North American Refractories Co.
 Cleveland, Ohio.

1941 MCGEE STRIPPING

PIKE TWP. CLEARFIELD CO. PENNA.
 Sept 29, 1941
 Meas. By: J. H. J.
 Checked By: _____
 Calc. By: _____

SCALE (Plan 1"=50'
 Profile 1"=5')

20641
 22-3-14B
 1