


FINAL SURVEY
SURVEYED
PLOTTED
NOTE BOOK
NO.

ORIGINAL SURVEY
SURVEYED
PLOTTED
NOTE BOOK
NO.

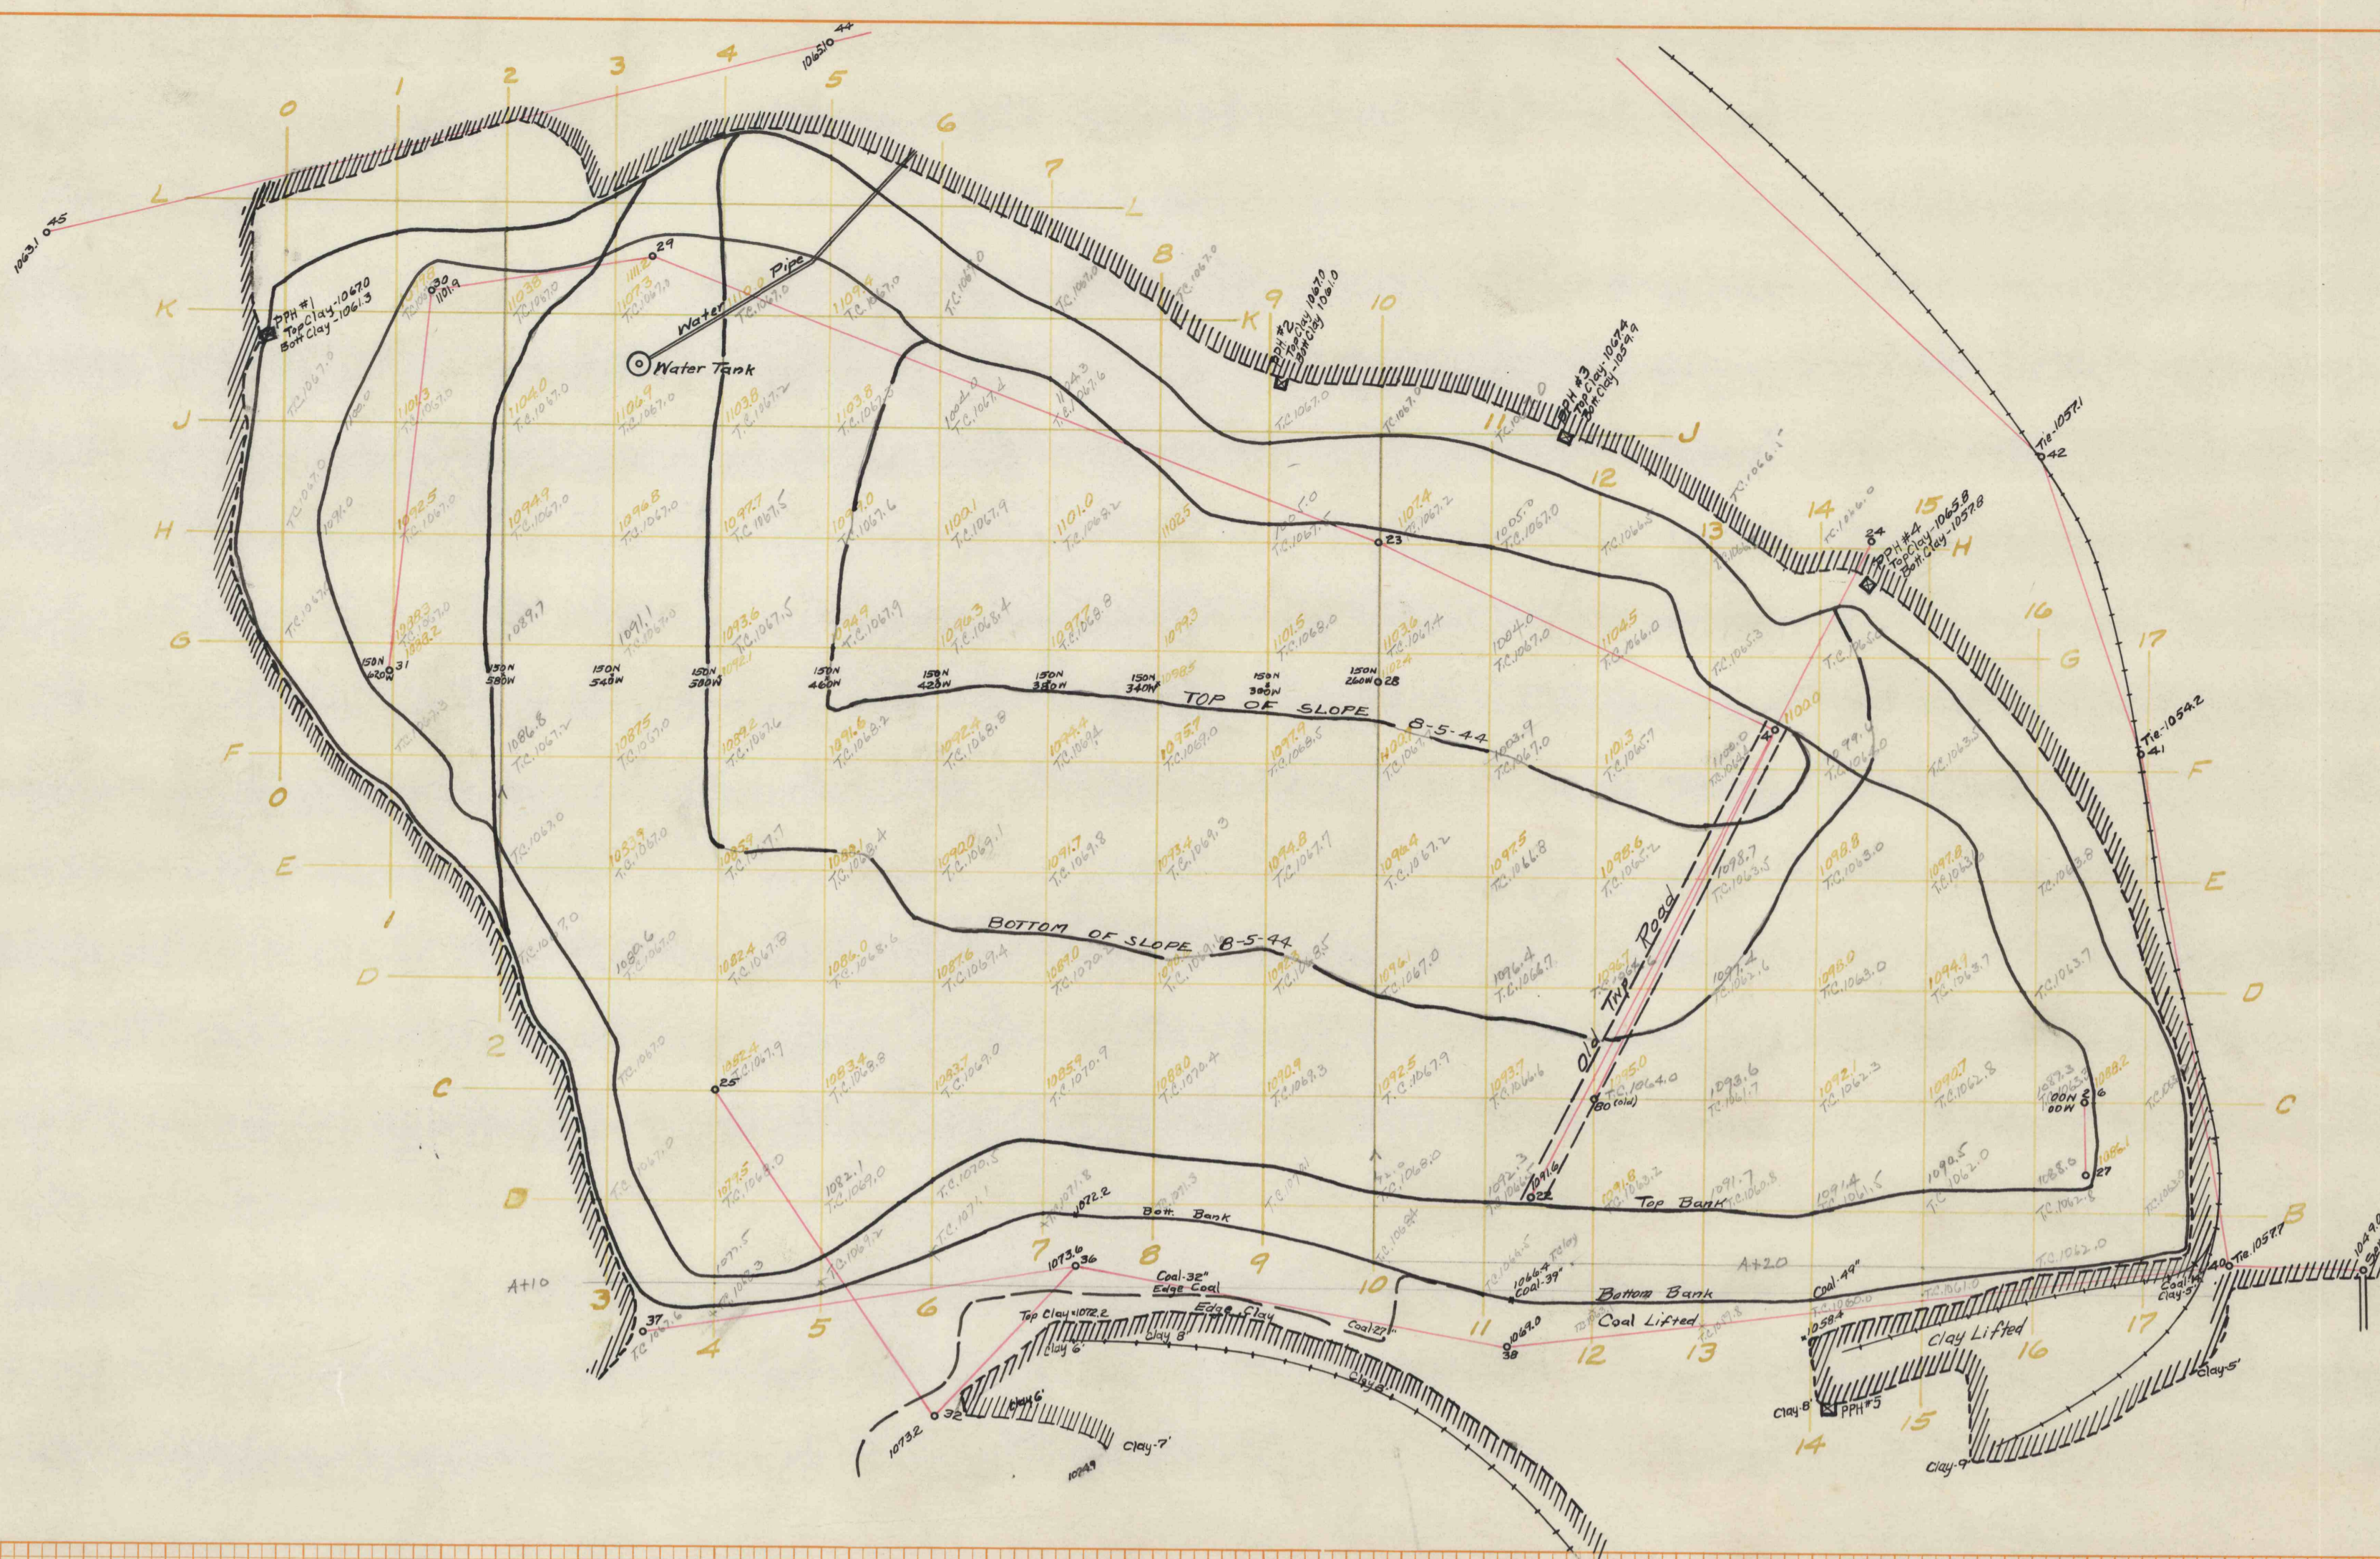

North American Refractories Co.
Cleveland, Ohio.
STRASBURG No. 2
ISLAND STRIPPING
Franklin Twp., Tuscarawas Co., Ohio.
SCALE 1" = 50'
June 18, 1943. By W.W.Y.
Index No. 76-2-12
M.B. 198

Profile { 46.1' = 10'
10.1' = 10'

