


NOTE:-

IF PROPOSED CHANGE IS MADE, SAFETY DERAILS TO BE INSTALLED ON EACH SIDE OF CROSSING AND OPERATED FROM OPPOSITE SIDE, IF ROARING RUN STONE CO. DESIRES TO OPERATE ON THEIR OLD GRADE.

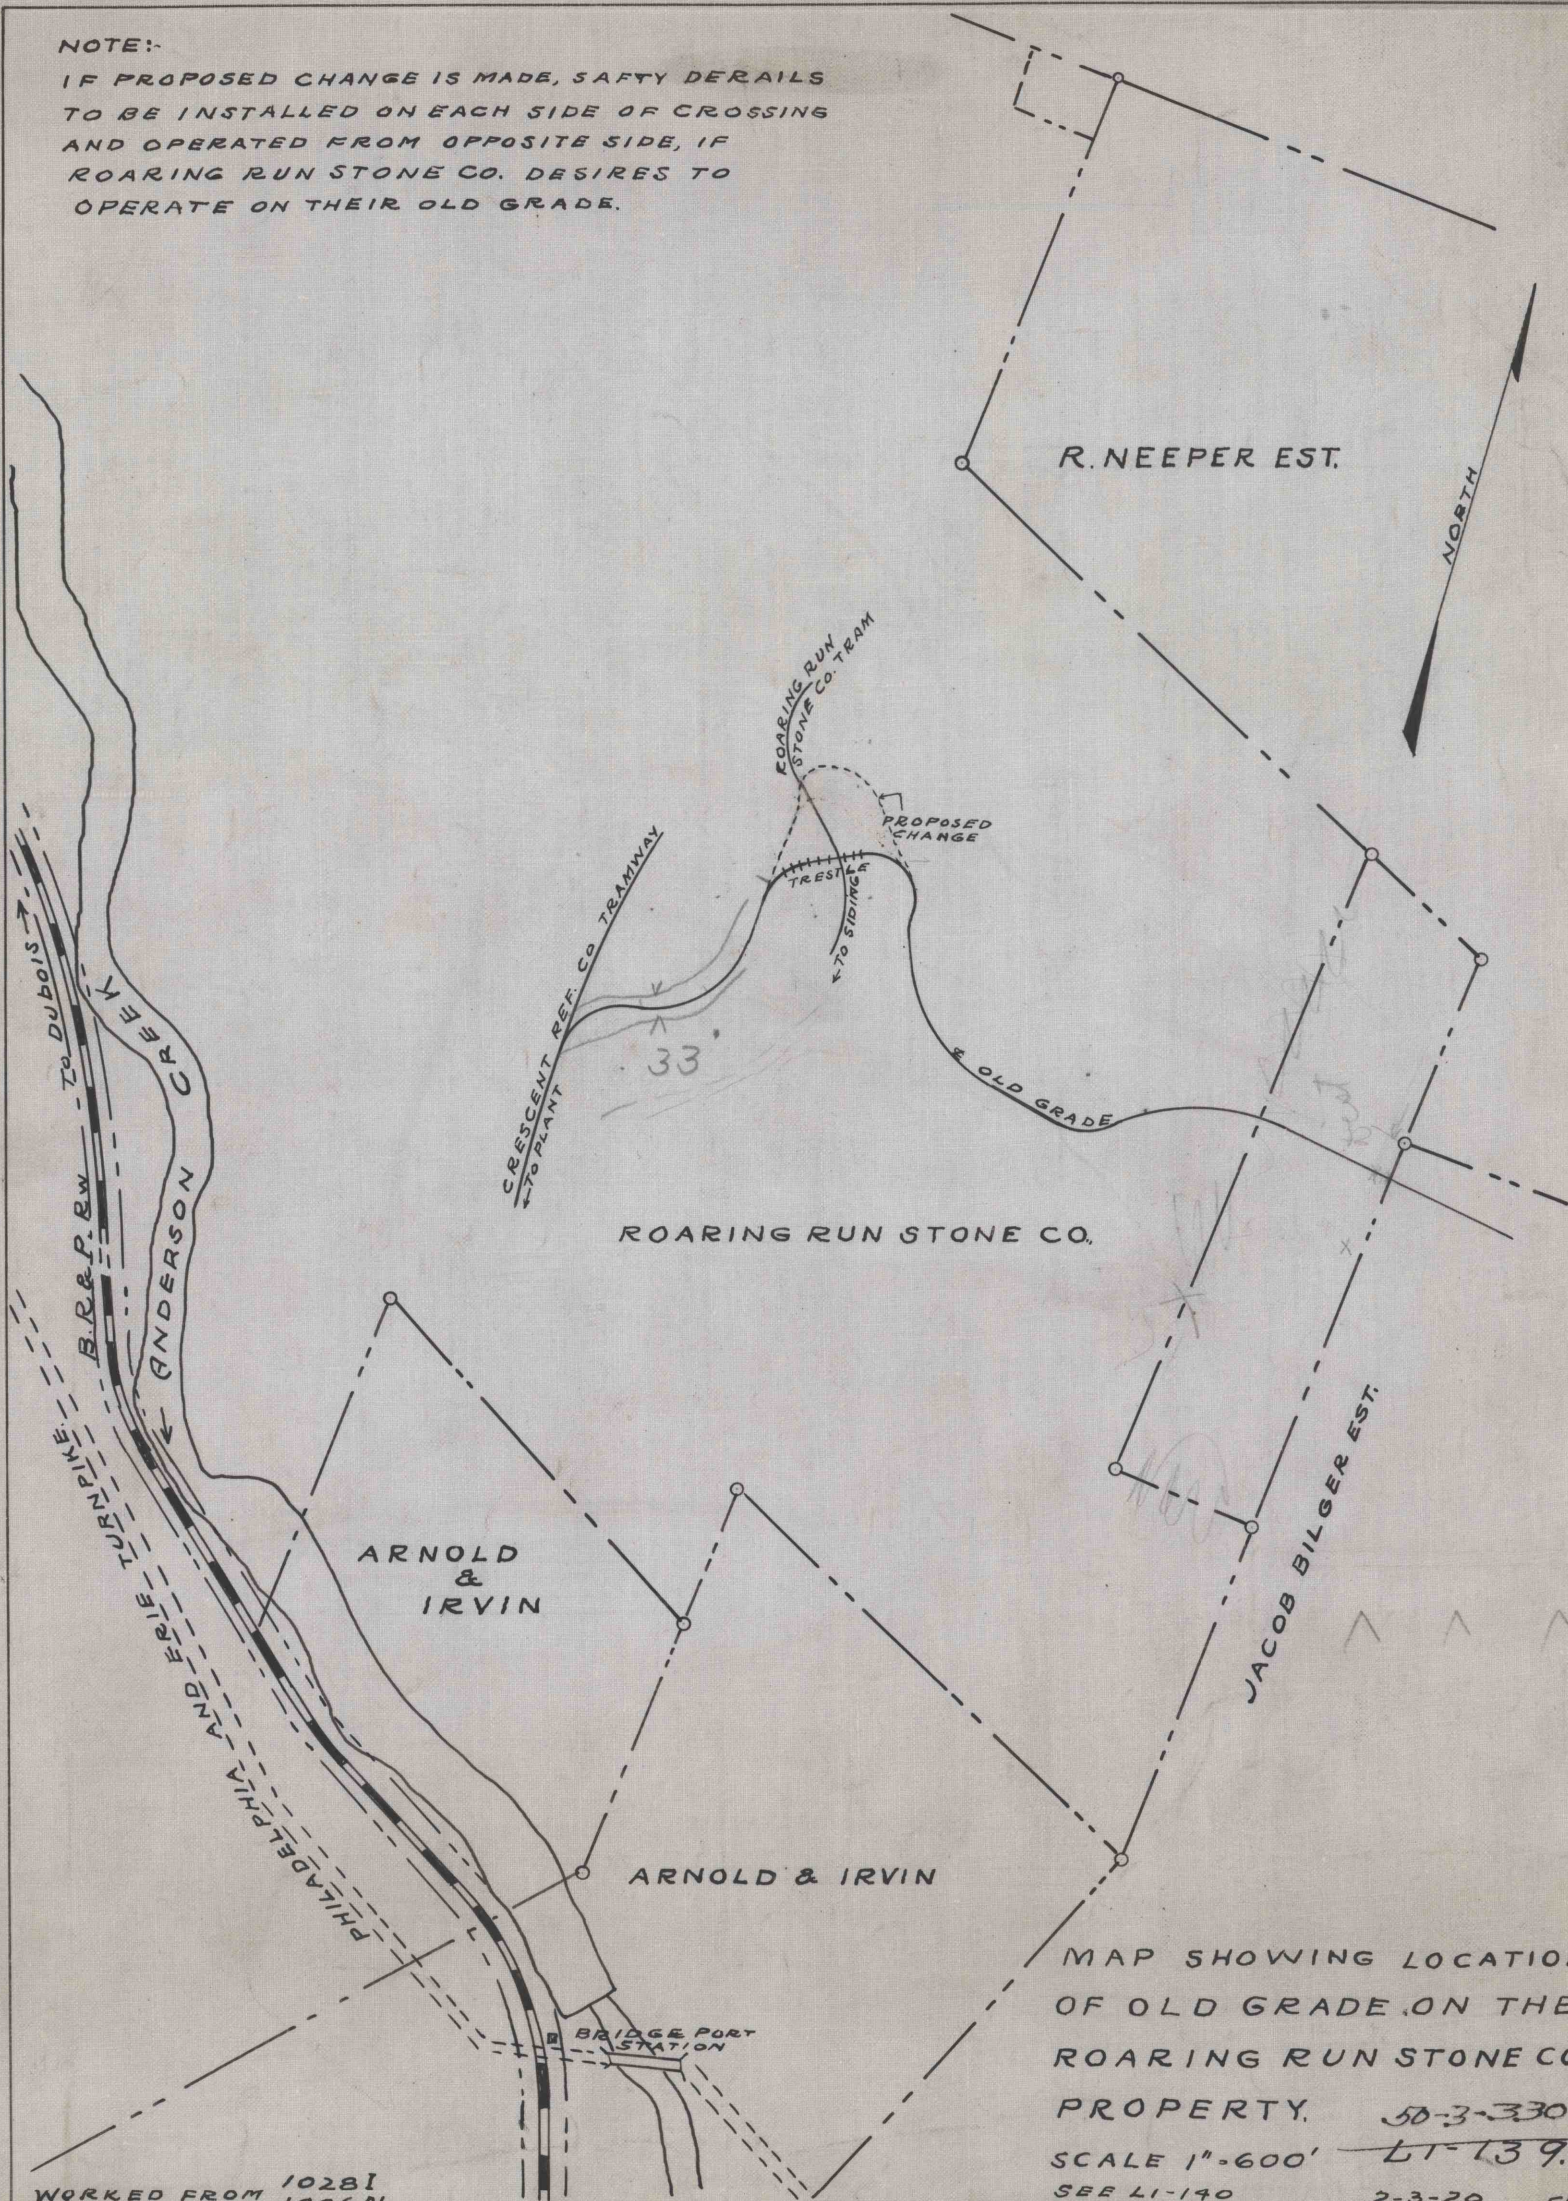

WORKED FROM 10281  
1006N

MAP SHOWING LOCATION  
OF OLD GRADE ON THE  
ROARING RUN STONE CO.  
PROPERTY.

SCALE 1"=600' *50-3-330*  
*LT-139*  
SEE LI-140 2-3-20 C.R.S.