


View from front of Presses showing mixers installed over each press with present elevator lengthened to new bin installed to supply mixers automatically. This plan is only proposed if mixers are desired.

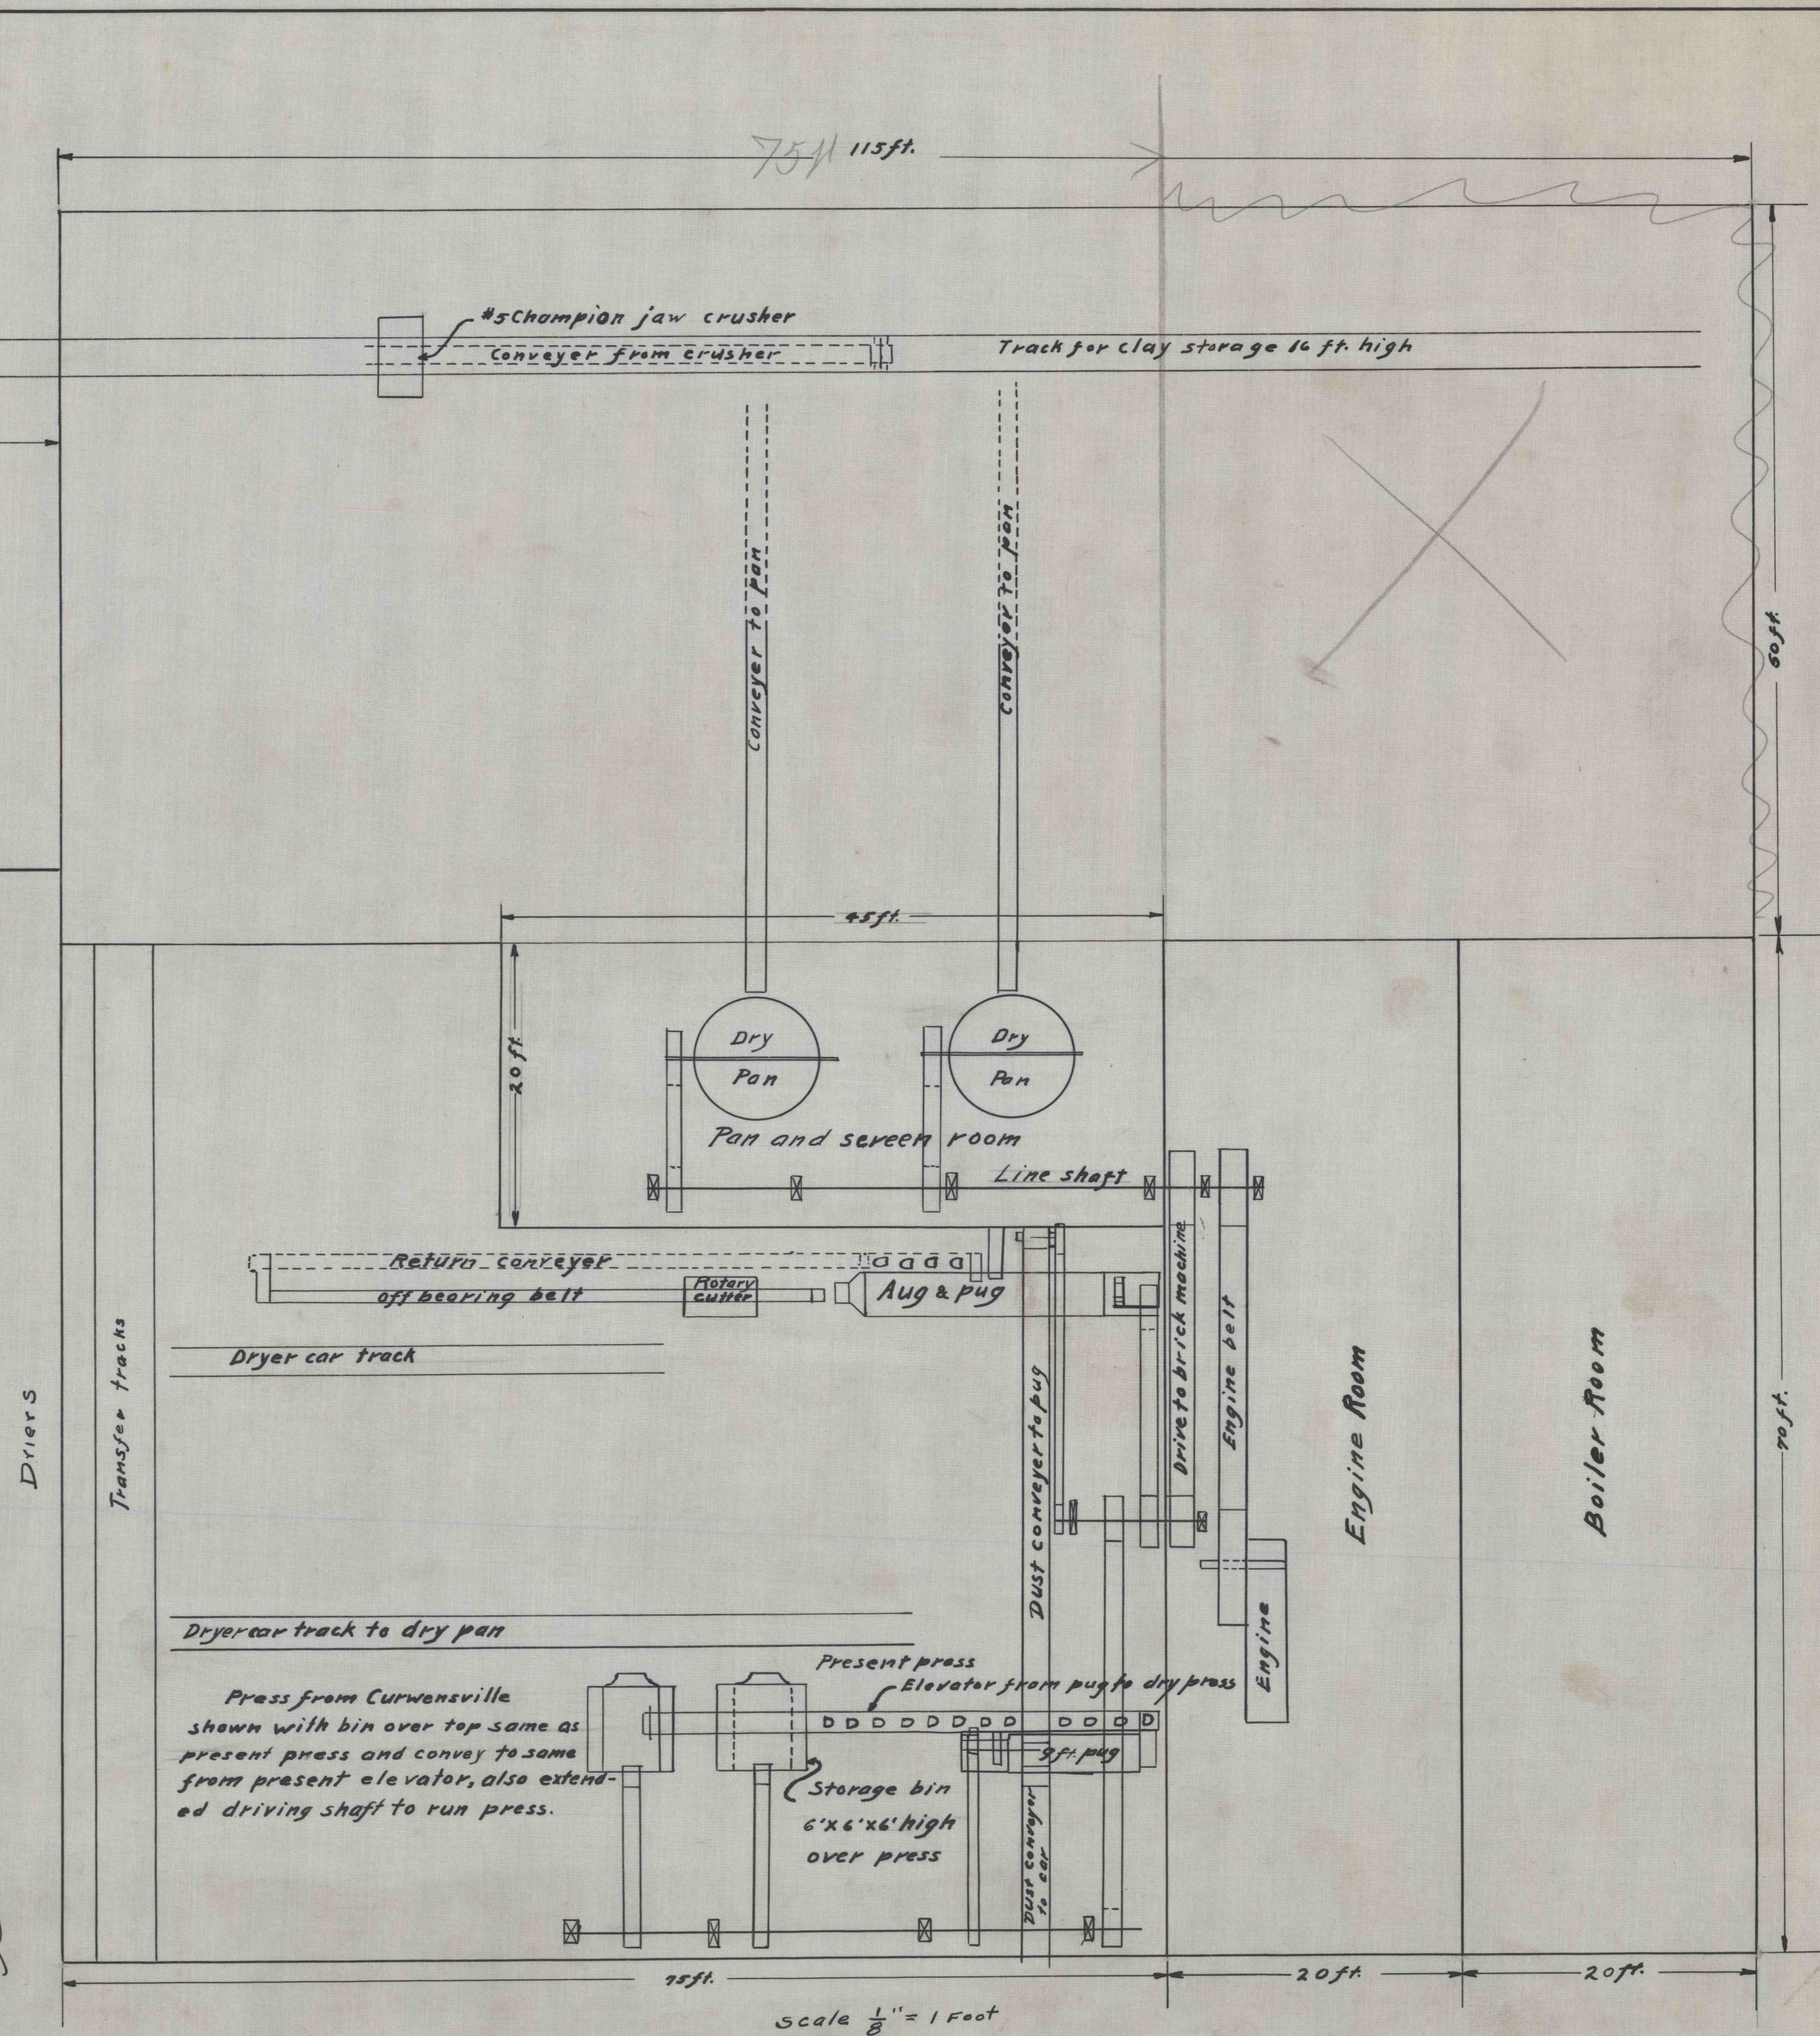

NORTH AMERICAN REFRACTORIES CO.
 PLAN SHOWING PRESENT CLAY DOCK & END OF COAL DOCK
 ALSO SHOWING PRESENT DRY PRESS WITH PROPOSED
 INSTALLATION OF A SECOND DRY PRESS WITH CURWENSVILLE PLANT

DAGUS PLANT AT SI MARYS DIVISION

SCALE as given
 DATE JULY 20 1929.

DRAWN BY *Tom Wall*
 TRACED R.H. & J.H.
 ENGR. DEPT. CRESCENT DIVISION. INDEX EL 1002