

REFERENCE DATA


CRESCENT REFRACTORIES CO.
 CURWENSVILLE, CLEARFIELD COUNTY, PA.
 ENGINEERING DEPARTMENT

ENV. NO. ~~41~~
 SHEET NO. 125
 50-3-300


SCALE $\frac{1}{4}'' = 1'-0''$

STANDARD MAGAZINE.


DATE 11-12-18

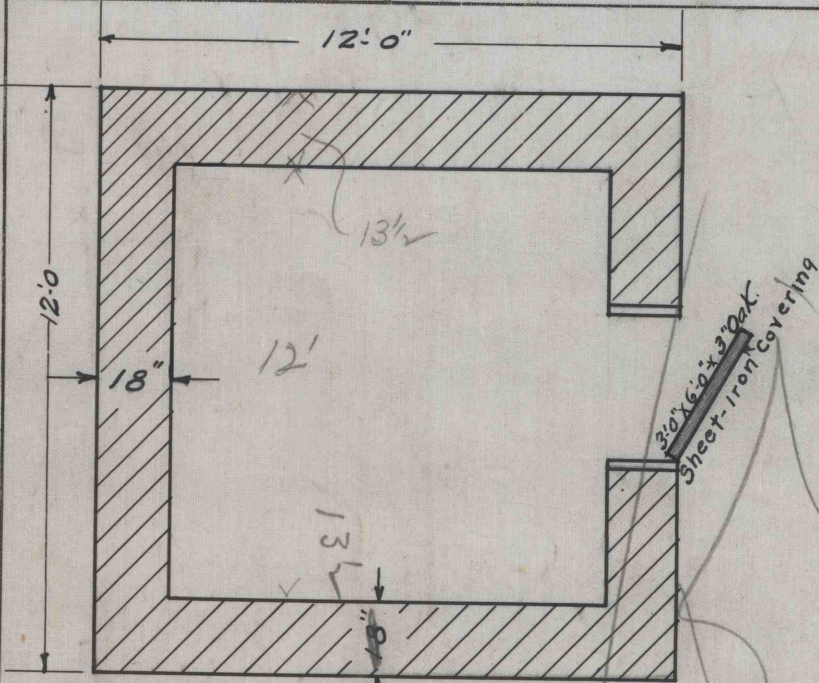

PLAN.

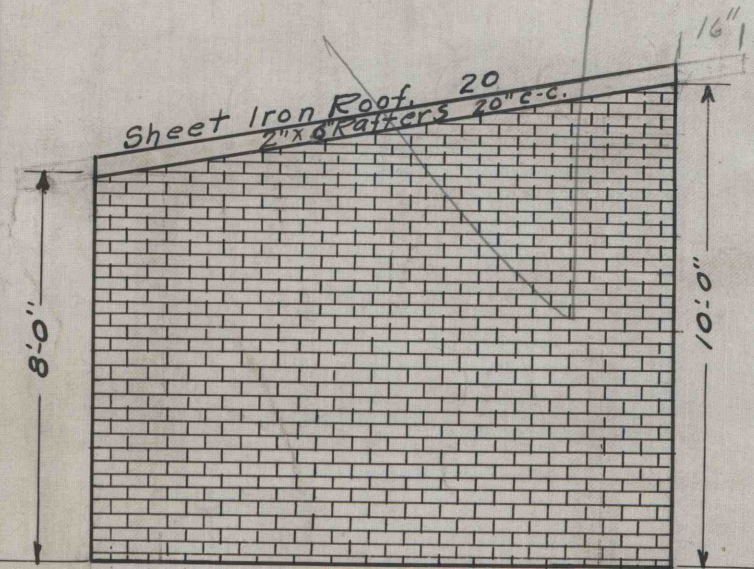

SIDE ELEVATION.

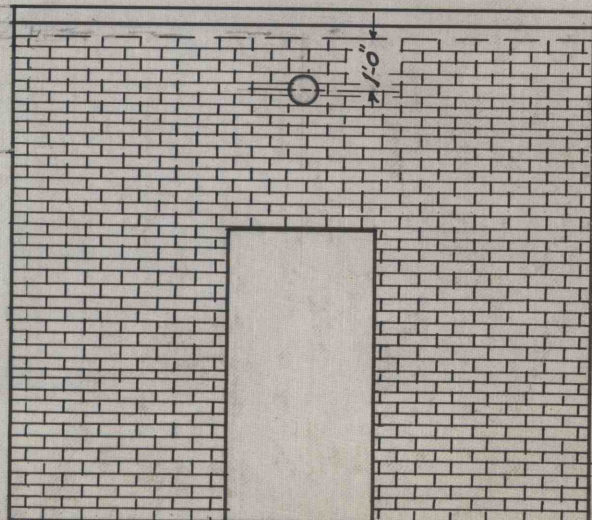

FRONT ELEVATION.

- BILL OF MATERIAL**
 10395
 BRICK - 8694 (AT 21-PER SQ.FT.)
 86-2" X 6" - 12'-0" 17-0
 1-3" X 12" - 5'-0"
 300225 SQ. FT. SHEATING.
 324 SQ. ROOFING.
 ✓ 1-6'-0" X 3'-0" X 3" OAK DOOR
 ✓ 1-2" X 12" - 16'-0" DOOR JAMB.
 ✓ 3 Hinges complete.
 ✓ 1 Hasp, Steeple & Pad-lock.
 5 1/2 4 1/2 Ton sand
 10 4 Bbl's cement.