

Plan-Supports For Conveyor & Bin Three Springs Quarry Mt Union Plant


REFERENCE DATA

NORTH AMERICAN REFRACTORIES CO.
1012 NATIONAL CITY BANK BUILDING
CLEVELAND, OHIO

ENV.No.
SHEET No.
61-2-134-50

SCALE 


DATE **8/20/41**

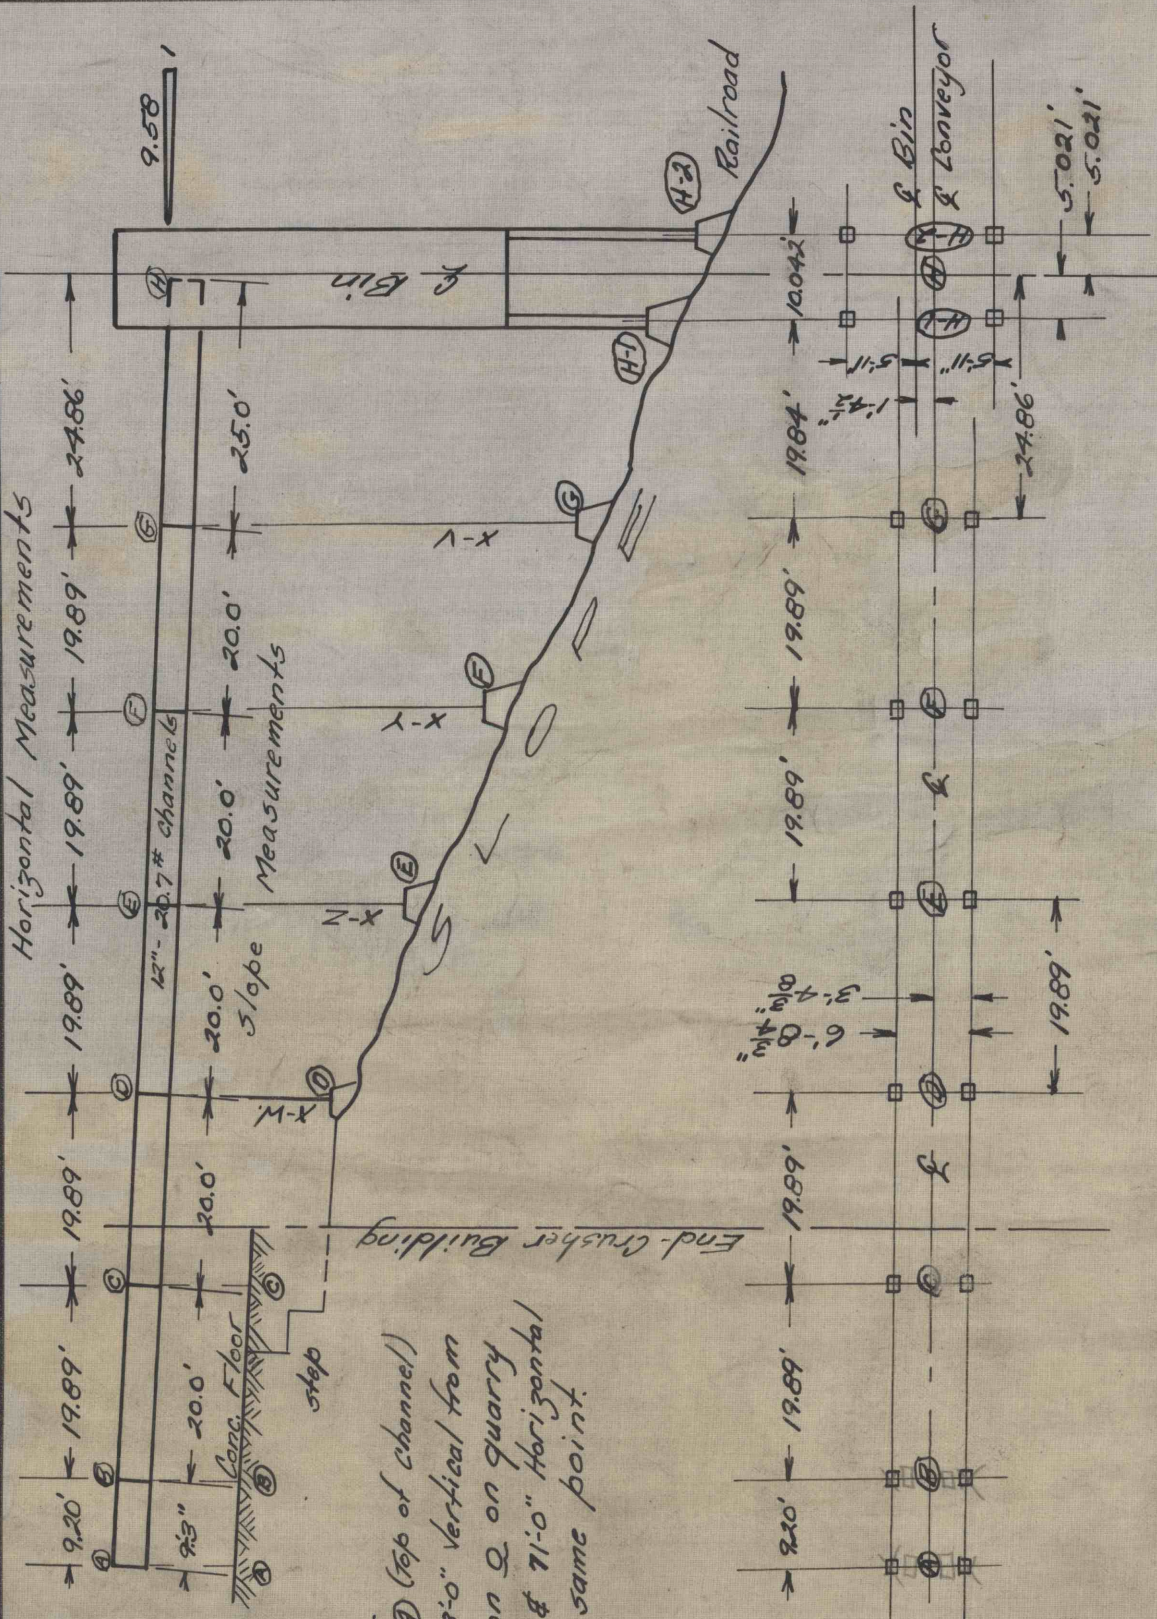

Note -
Sta A (Top of channel)
is 43'-0" vertical from
station Q on quarry
floor & 71'-0" horizontal
from same point.

Location	Station	Elevation
Top Pier	A	1159.67
"	B	1158.71
"	C	1156.64
"	D	1153.50
"	E	1142.52
"	F	1133.20
"	G	1123.95
"	H-1	1114.83
"	H-2	1110.33

Location	Station	Elevation
Top Channel	A	1162.00
"	B	1161.04
"	C	1158.97
"	D	1156.90
"	E	1154.83
"	F	1152.76
"	G	1150.69
"	H	1148.09

WORKED FROM 

DRAWN BY **D.M.D.**

CHECKED BY **J.H.K.**