


66-2-2
Sheet # 2

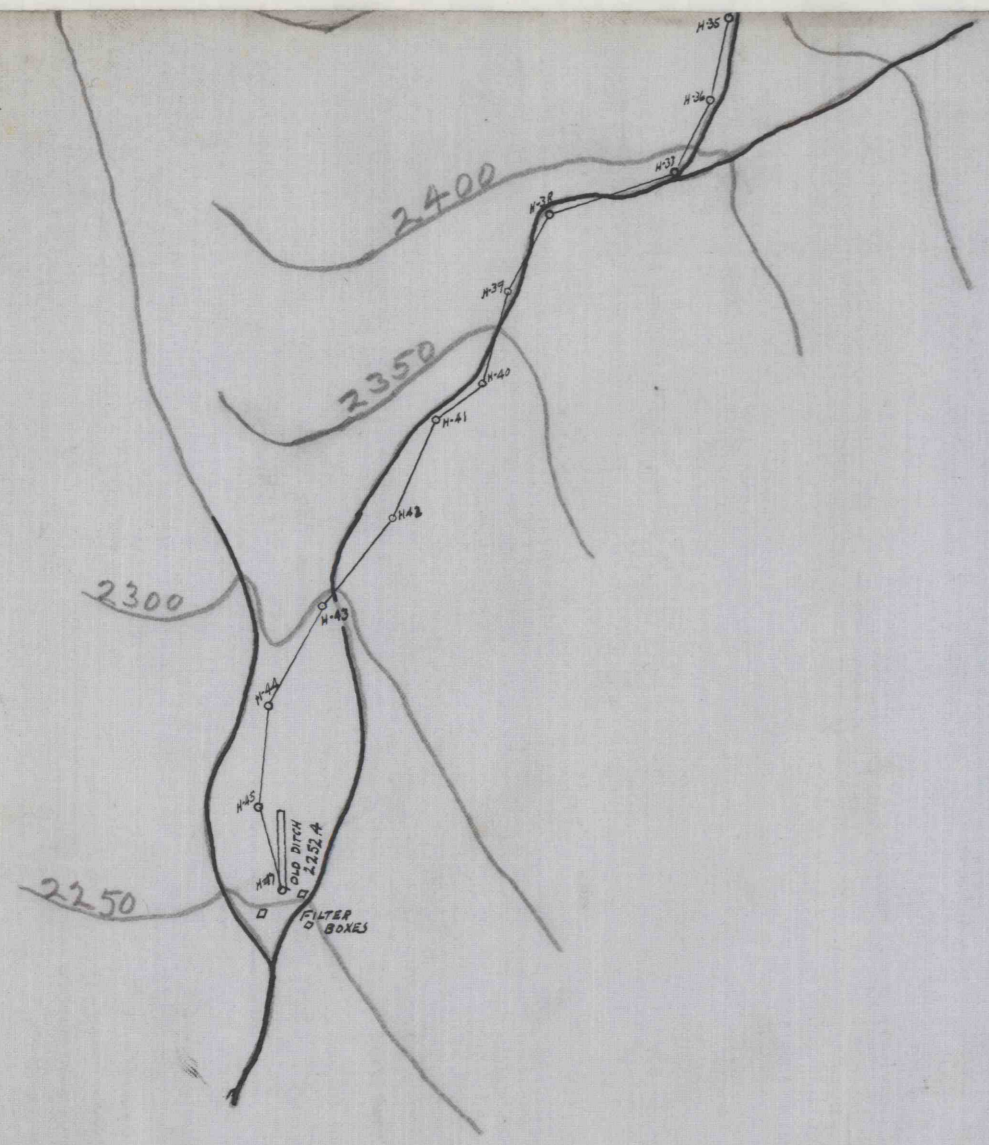

Note PITCH OF CLAY = 34.64%

66-2-2
Sheet 2

66-2-2
Sheet # 2