

# GEO. S. GOOD FIRE BRICK CO.

CURWENSVILLE, CLEARFIELD COUNTY, PA.

ENGINEERING DEPARTMENT

ENV. No.

SHEET No.


NORTH EAST CORNER OF GAME LANDS No. 89  
GALLAGHER TWP CLINTON CO. PENNA.

20-3-68

SCALE

SCALE 1"=1000 FT.

DATE JUNE 16, 1937

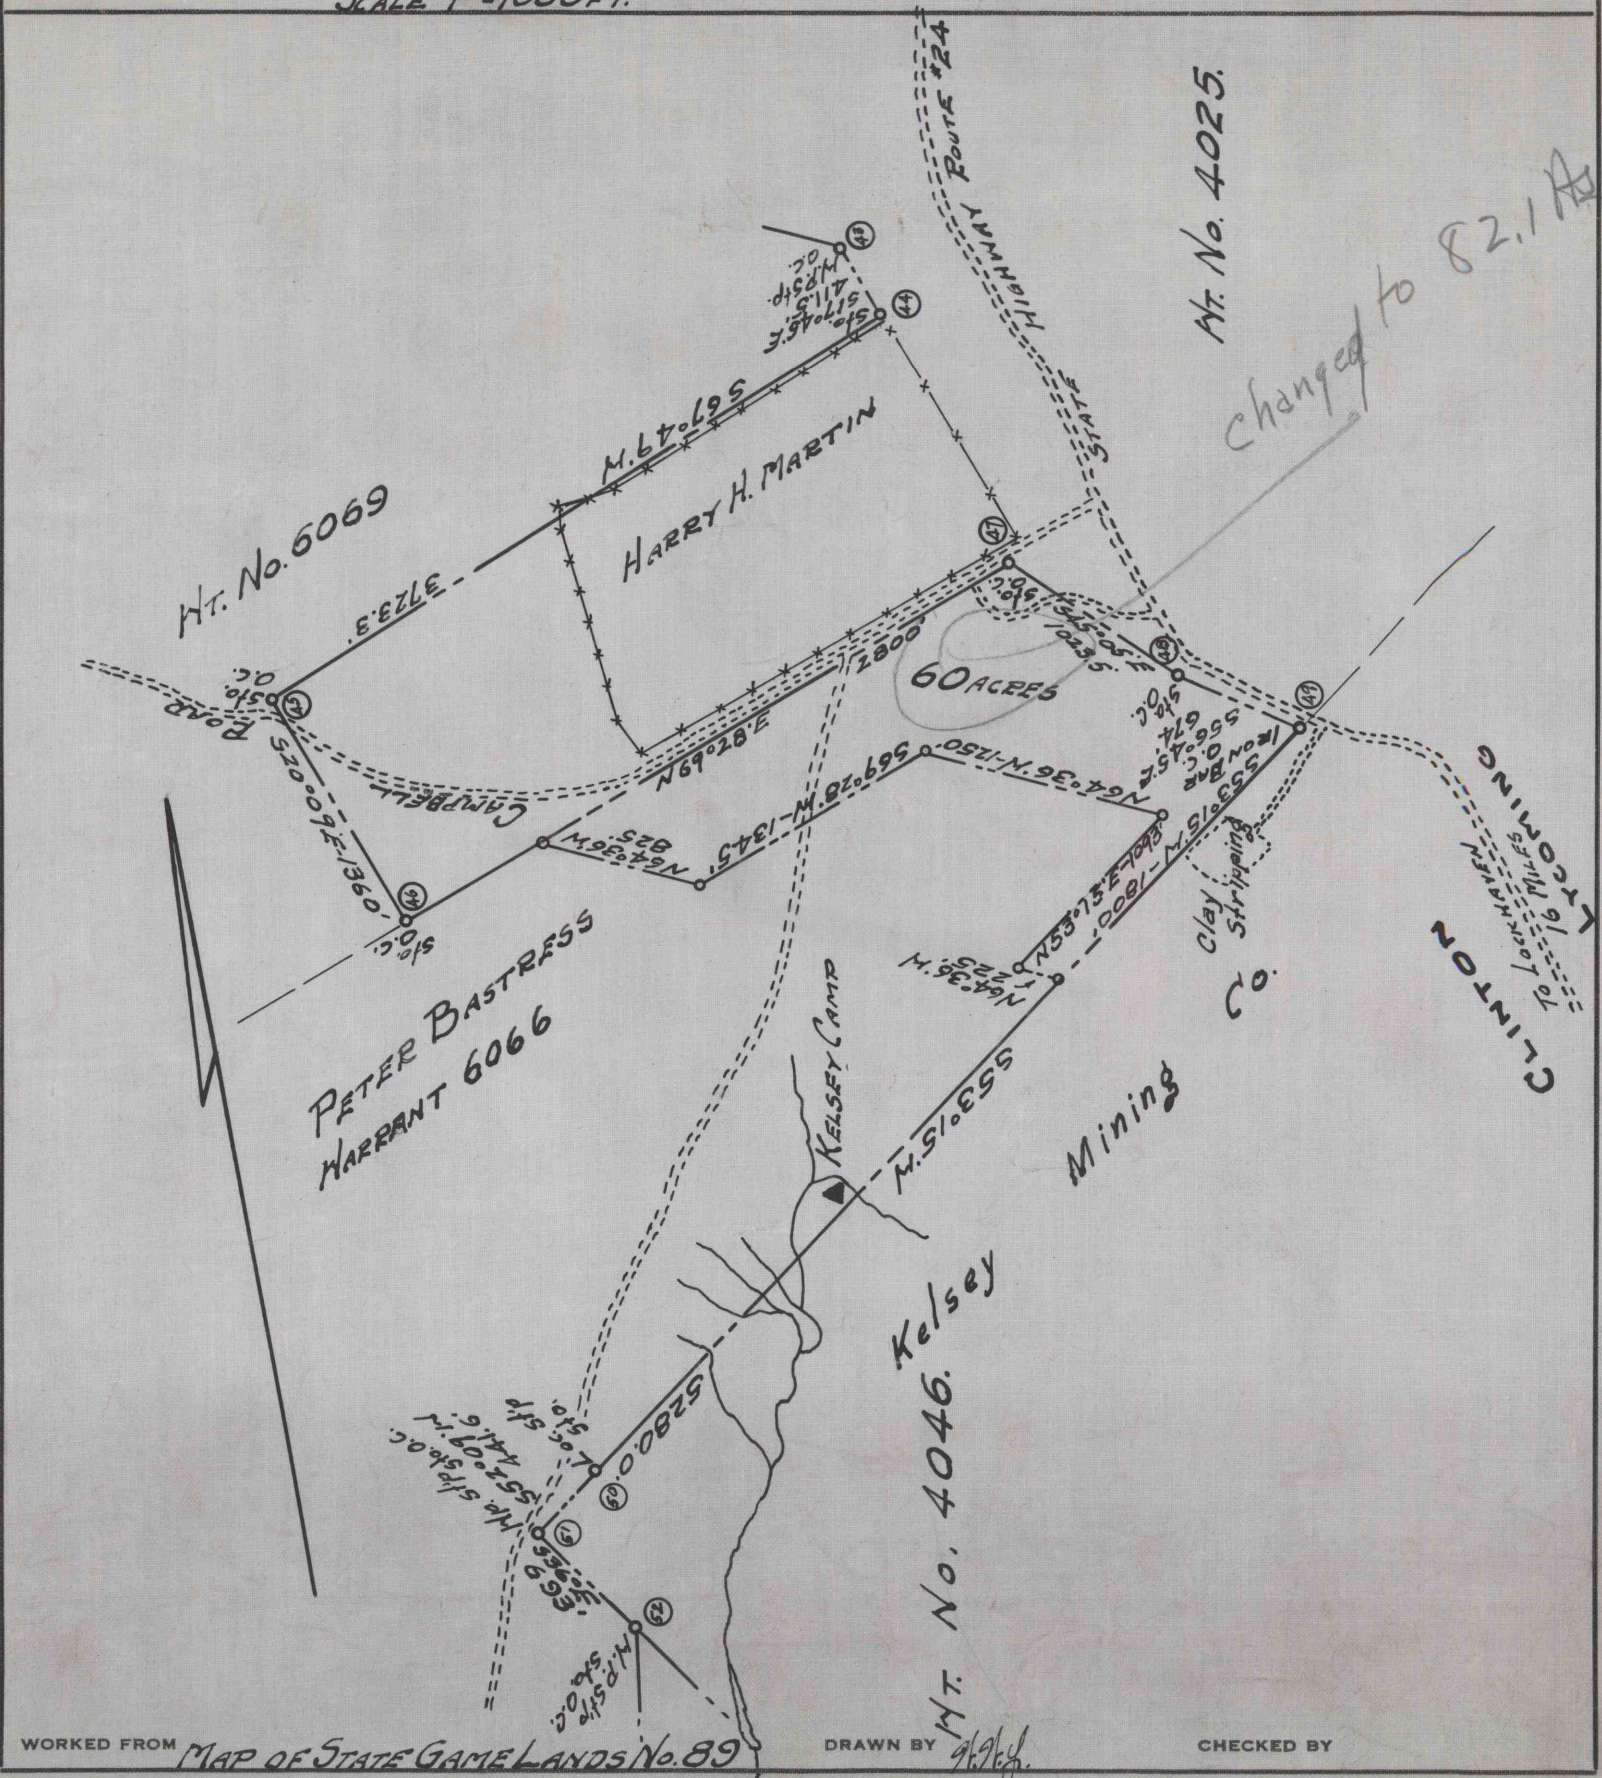

WORKED FROM MAP OF STATE GAME LANDS No. 89

DRAWN BY *[Signature]*

CHECKED BY