

WILLIAM HOCHSTETLER, ET AL

N88°-28'E

FRANKLIN TOWNSHIP ROAD - ROUTE No. 429

1315.0' ±

SR-30E

To STRASBURG

LESTER L. ANDERSON  
41.5 A±.

1.763 A± ±

TOP OF HIGHWALL  
BOTTOM OF HIGHWALL

SPOIL

N2°-30'W

1315.0'

S88°-28'W

1317.0'


WILBUR KORN'S

I, THE UNDERSIGNED, HEREBY CERTIFY THAT THIS MAP IS A CORRECT PRESENTATION OF THE AREA OF LAND AFFECTED BY THE STRIP MINING OF COAL UNDER LICENSE No. 4342, ON LAND OF LESTER L. ANDERSON, BY RAYMOND LAHMERS - NORTH HALF OF WEST HALF OF SECTION 11, TWP. 9, R3W. FRANKLIN TWP, TUSCARAWAS CO., OHIO; AND TO THE BEST OF MY KNOWLEDGE AND BELIEF, THIS MAP COMPLIES WITH THE REQUIREMENTS OF REGULATIONS 5 & 6 OF THE DIVISION OF RECLAMATION, AND THE PROVISIONS OF SECTION 1513.09 OF THE REVISED CODE OF OHIO.  
DATE: \_\_\_\_\_ SIGNED BY: \_\_\_\_\_

I, THE UNDERSIGNED MINE SUPERINTENDENT, \_\_\_\_\_ CERTIFY THAT THIS MAP, TO THE BEST OF MY KNOWLEDGE AND BELIEF REPRESENTS ALL OF THE AREA AFFECTED BY NARCO DURING THE PERIOD 11-X-62 TO 11-X-63, COVERED BY STRIP MINE LICENSE No. 4342.  
DATE: \_\_\_\_\_ SIGNED BY: \_\_\_\_\_  
SUBSCRIBED AND SWORN TO BEFORE ME AT THIS \_\_\_\_\_ DAY OF \_\_\_\_\_, 1964.  
SIGNED BY: \_\_\_\_\_ TITLE \_\_\_\_\_

NORTH AMERICAN REFRACTORIES CO.  
CLEVELAND, OHIO  
MAP SHOWING AREA AFFECTED BY LAHMER'S COAL STRIPPING ON L.L. ANDERSON  
NORTH HALF OF WEST HALF OF SECTION 11, TWP. 9, R3W  
FRANKLIN TOWNSHIP, TUSCARAWAS COUNTY, OHIO  
SCALE: 1" = 100 FT. DRAWN: J.R. HUDSON, JR. CHECKED: \_\_\_\_\_  
DATE: 6-22-64

INDEX No. 75-3-202

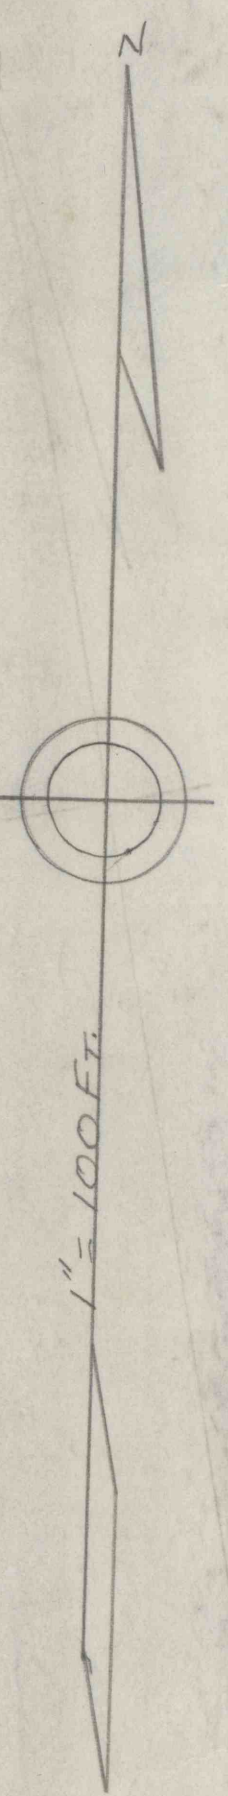

WILLIAM HOCHSTETLER, ET AL

To DUNDEE