


BERRINGS

MAGNETIC

3596

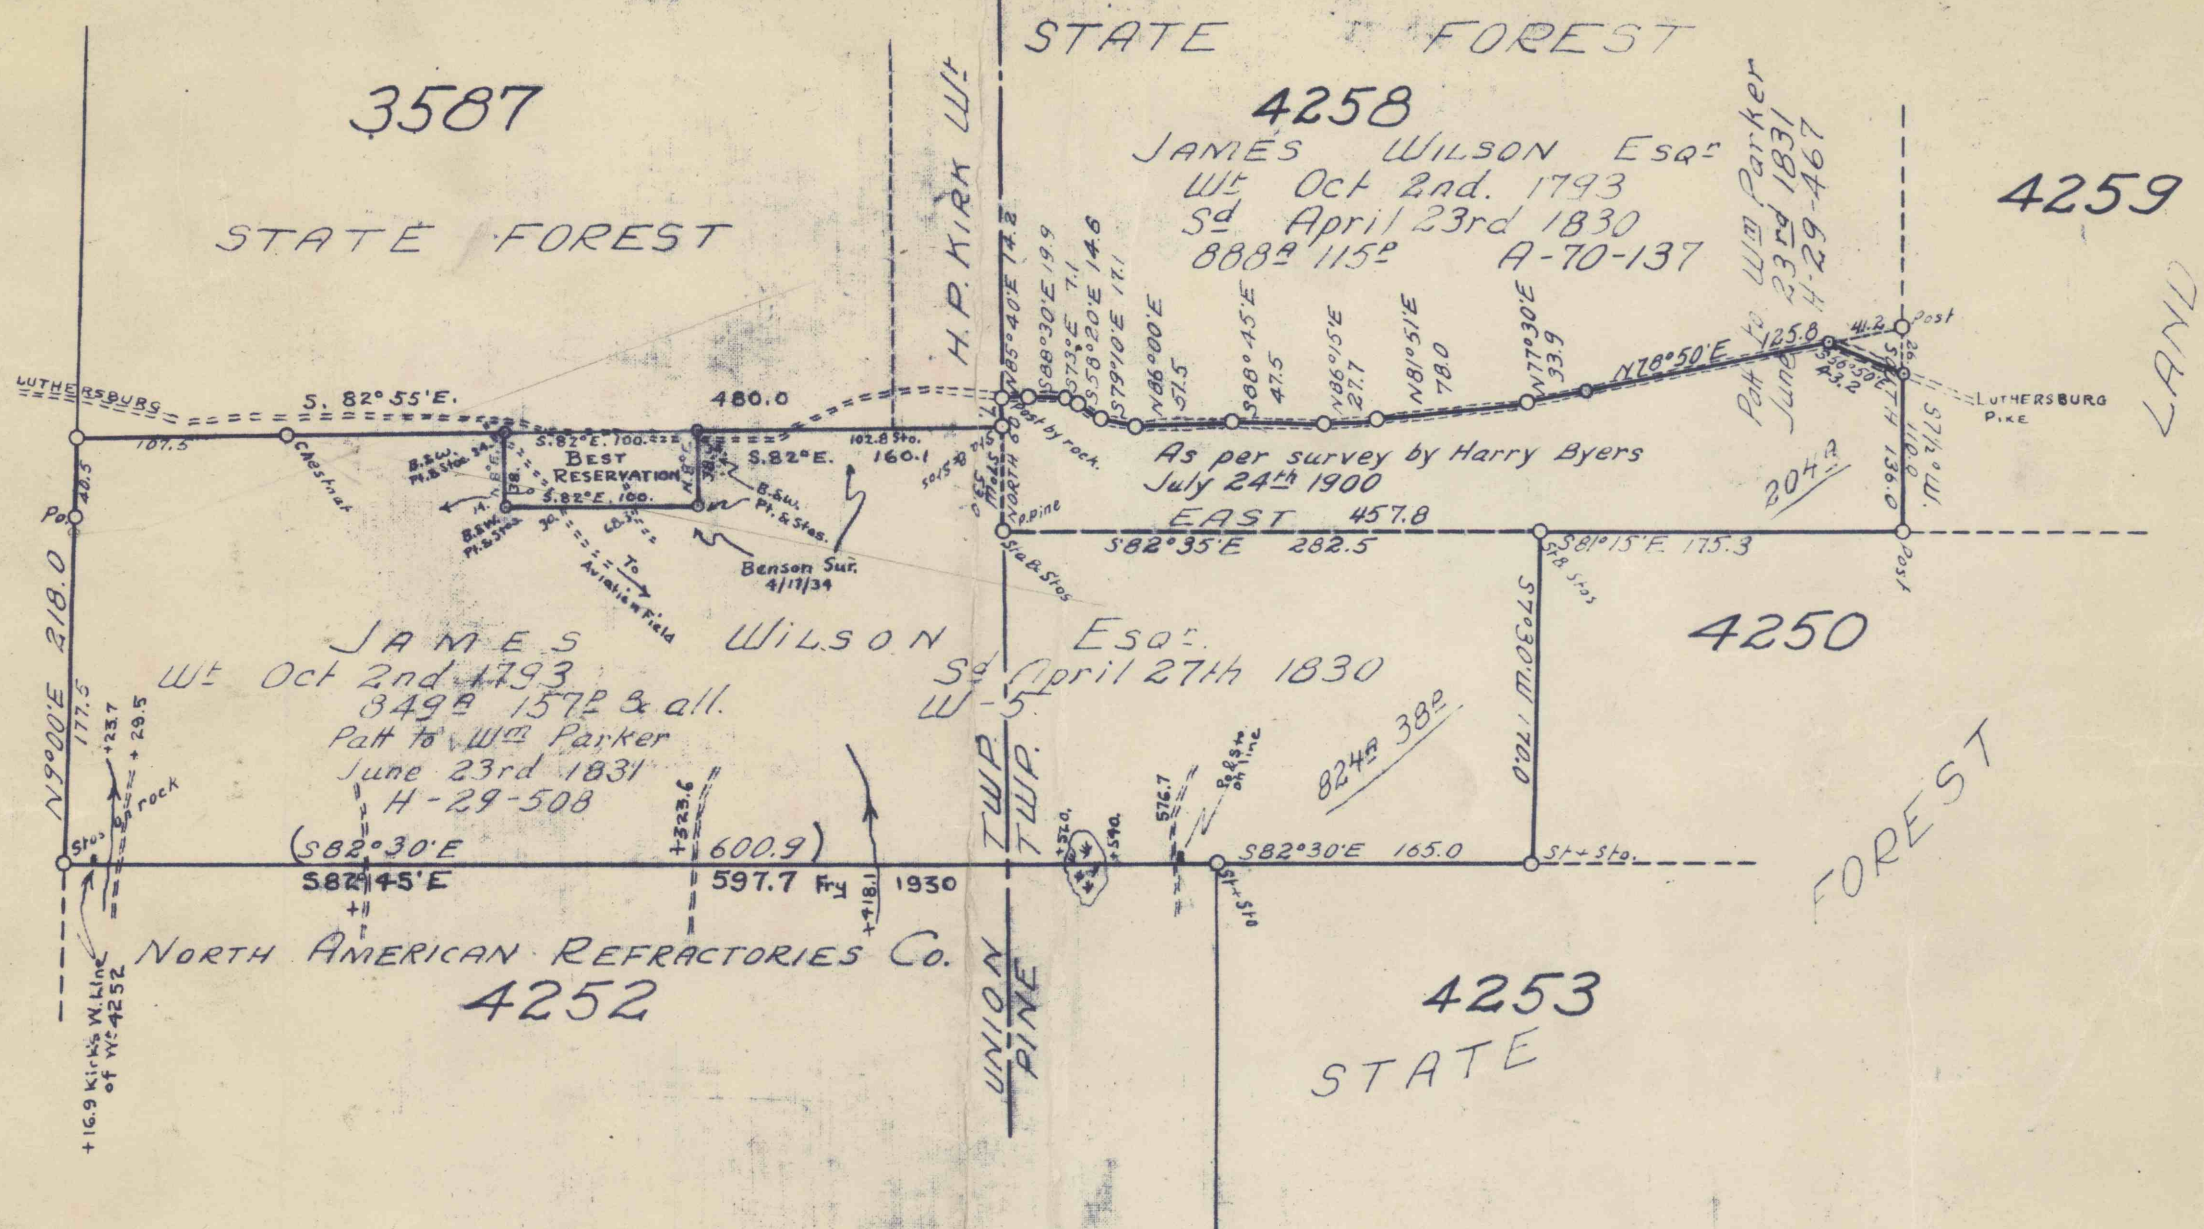

Deed dated - 12-31-29
 Recorded - 1-24-30
 V. 295 P. 362
 Encage - 1028 A. 38 P.
 Date Cert. - 1-29-30.

PENNSYLVANIA
 DEPARTMENT OF FORESTS AND WATERS
 HARRISBURG
 CLEARFIELD CO. UNION. AND PINE T.W.P.S.

HARBISON-WALKER PURCHASE

Surveyed Sept 28th 1929 E.D. Billotte
 Under direction of T.O. Bietsch
 Plotted Oct 30th 1929 O.L. Borke
 Traced Oct 31st 1929 O.L. Borke
 Checked Oct 31st 1929 T.O.B.
 Scale 1" = 100 rods

1544