


HANNAH THOMAS HEIRS  
42AS 143 PERCHES ±


LEVI THOMAS

PENN PUBLIC SERVICE CORP  
JOHNSTOWN PA  
MAP SHOWING LOCATION OF 22KV  
LINE ON THE PROPERTY OF  
HANNAH THOMAS HEIRS BLOOM TWP.  
CLEARFIELD COUNTY PA  
SCALE 1"=200' BY JUNE 7 1923  
APPROVED C.J.L

CIV.F-2529

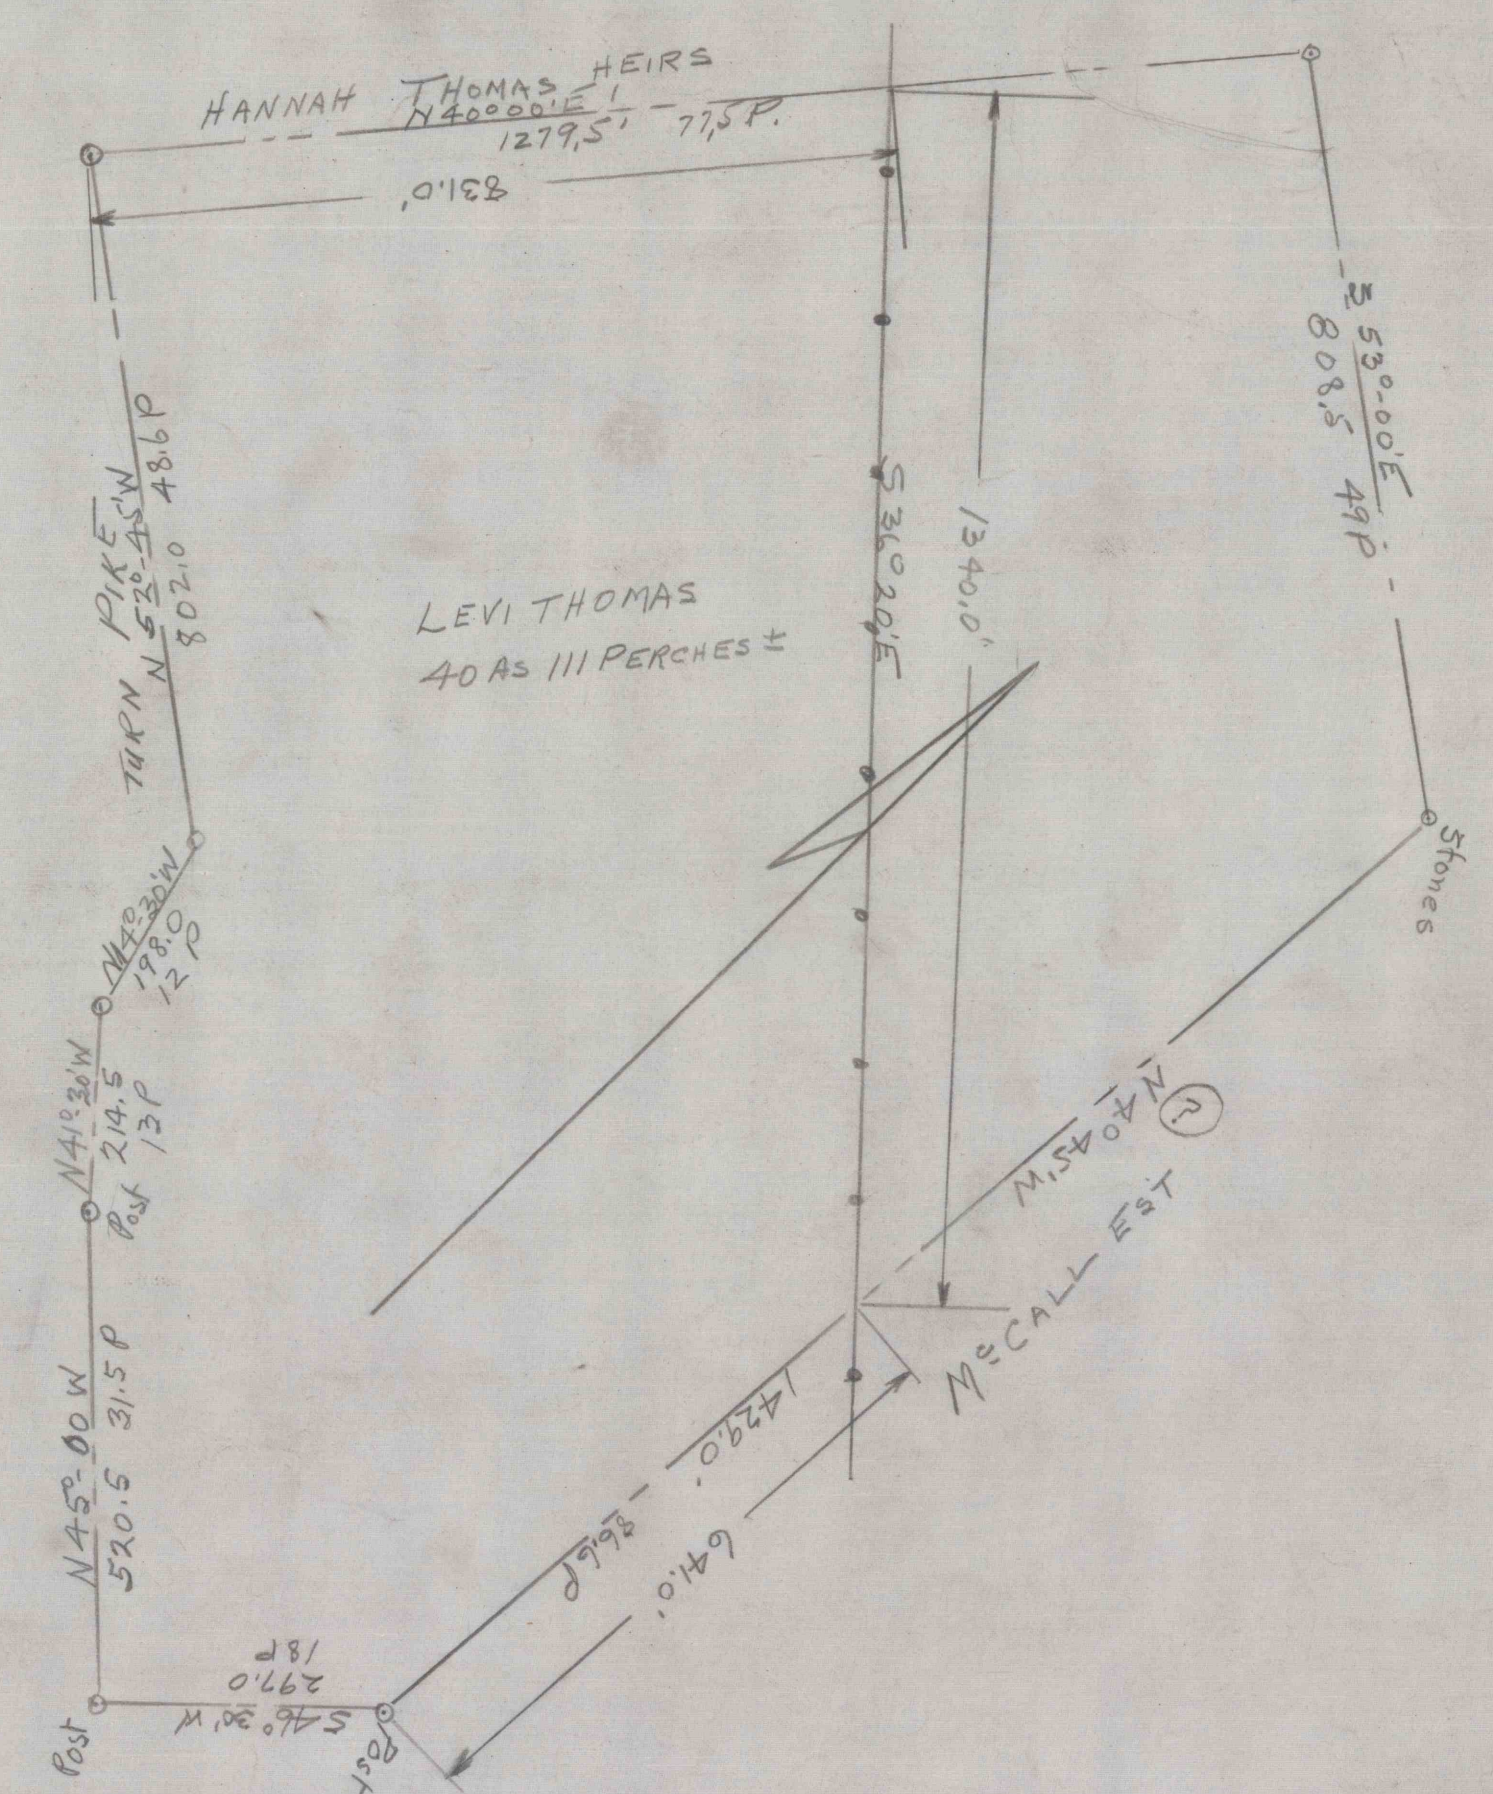

LEVI THOMAS  
40AS 111 PERCHES ±

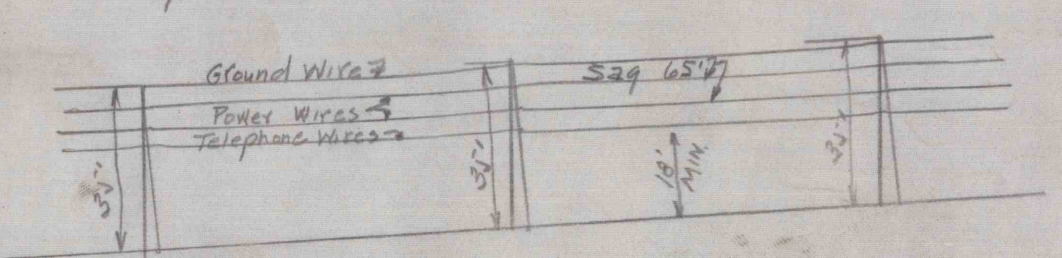

PENN PUBLIC SERVICE CORP  
JOHNSTOWN PA  
MAP SHOWING LOCATION OF 22KV  
LINE ON THE PROPERTY OF LEVI THOMAS  
IN BLOOM TOWNSHIP, CLFD CO. PA  
SCALE 1"=200' BY JUNE 7 1923  
APPROVED C.J.L

CIV.F 2528

<b>CRESCENT REFRACTORIES CO.</b>	
CURWENSVILLE, CLEARFIELD COUNTY, PA. ENGINEERING DEPARTMENT	
DRAWN	SCALE
CHECKED	DATE
REFERENCE	ORDER