


WOOLRICH

WOOLRICH

T R O X E L L

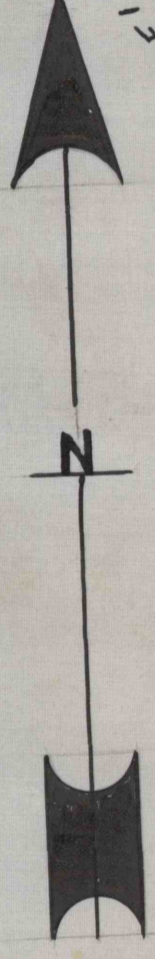

B.M. on Top Coping
West Side Concrete
Highway Bridge across
Smo run at Barrett
Station
Assumed EL. 500.00

TRACED FROM OLD PRINT BY K.R.B.

SCALE 1" = 250'

JUNE 28, 1949

No. 50-3-1174

No. 1
O 529.99

No. 7
O 567.64

No. 8
O 478.93
Top of Clay 12.5
9.0

No. 3
O 637.10
Top of Clay 10.3
4.4
478.4

No. 4
O 845.76
Top of Clay 7.3
13.6
551.56

No. 5
O 879.57
Top of Clay 16.0
4.0
52.07

No. 5
O 889.80

No. 6
O 874.76
Top of Clay 7.5
3.0
556.06

No. 1
O 590.60

No. 3
O 502.72

No. 4
O 733.62

No. 2
O 707.65

No. 6
O 898.68

Woolrich

PENNSYLVANIA

TO CLEARFIELD

TO TYRONE

RAIL ROAD

ROAD

ROAD

B.M. 500

Water Trough

20-3-1114

20-3-1114