


STATE ST.

WALNUT ST.

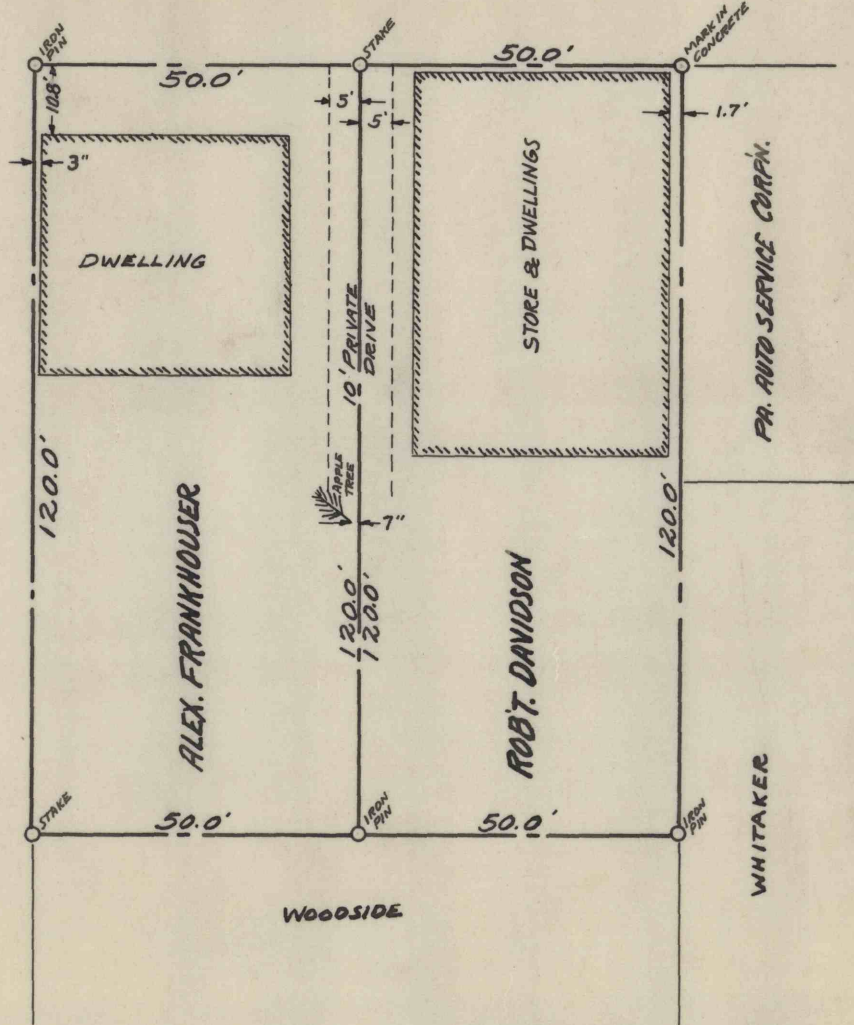

MAP OF LOTS

SURVEYED FOR

ALEX. FRANKHOUSER & ROBERT DAVIDSON

CURWENSVILLE BORO - CLEARFIELD CO. - PA.

MAY 31, 1946 - J.D. HAINES, JR. - SCALE 1"=30 FT.

BERN 01825

50-3-1136