

ENV. No. L1.

BICKFORD FIRE BRICK COMPANY

SHEET No. ~~50.~~

1122 FARMERS BANK BLDG., PITTSBURG, PA.

50-3-187.


ENGINEERING DEPARTMENT

Charles Hartzfeld Farm Pike Township, Clearfield Co., Pa.

SCALE 20 Pch = 1 In.

DATE

Resurveyed Jan. 5th, 1894.
Harry Byers Co., Sur.

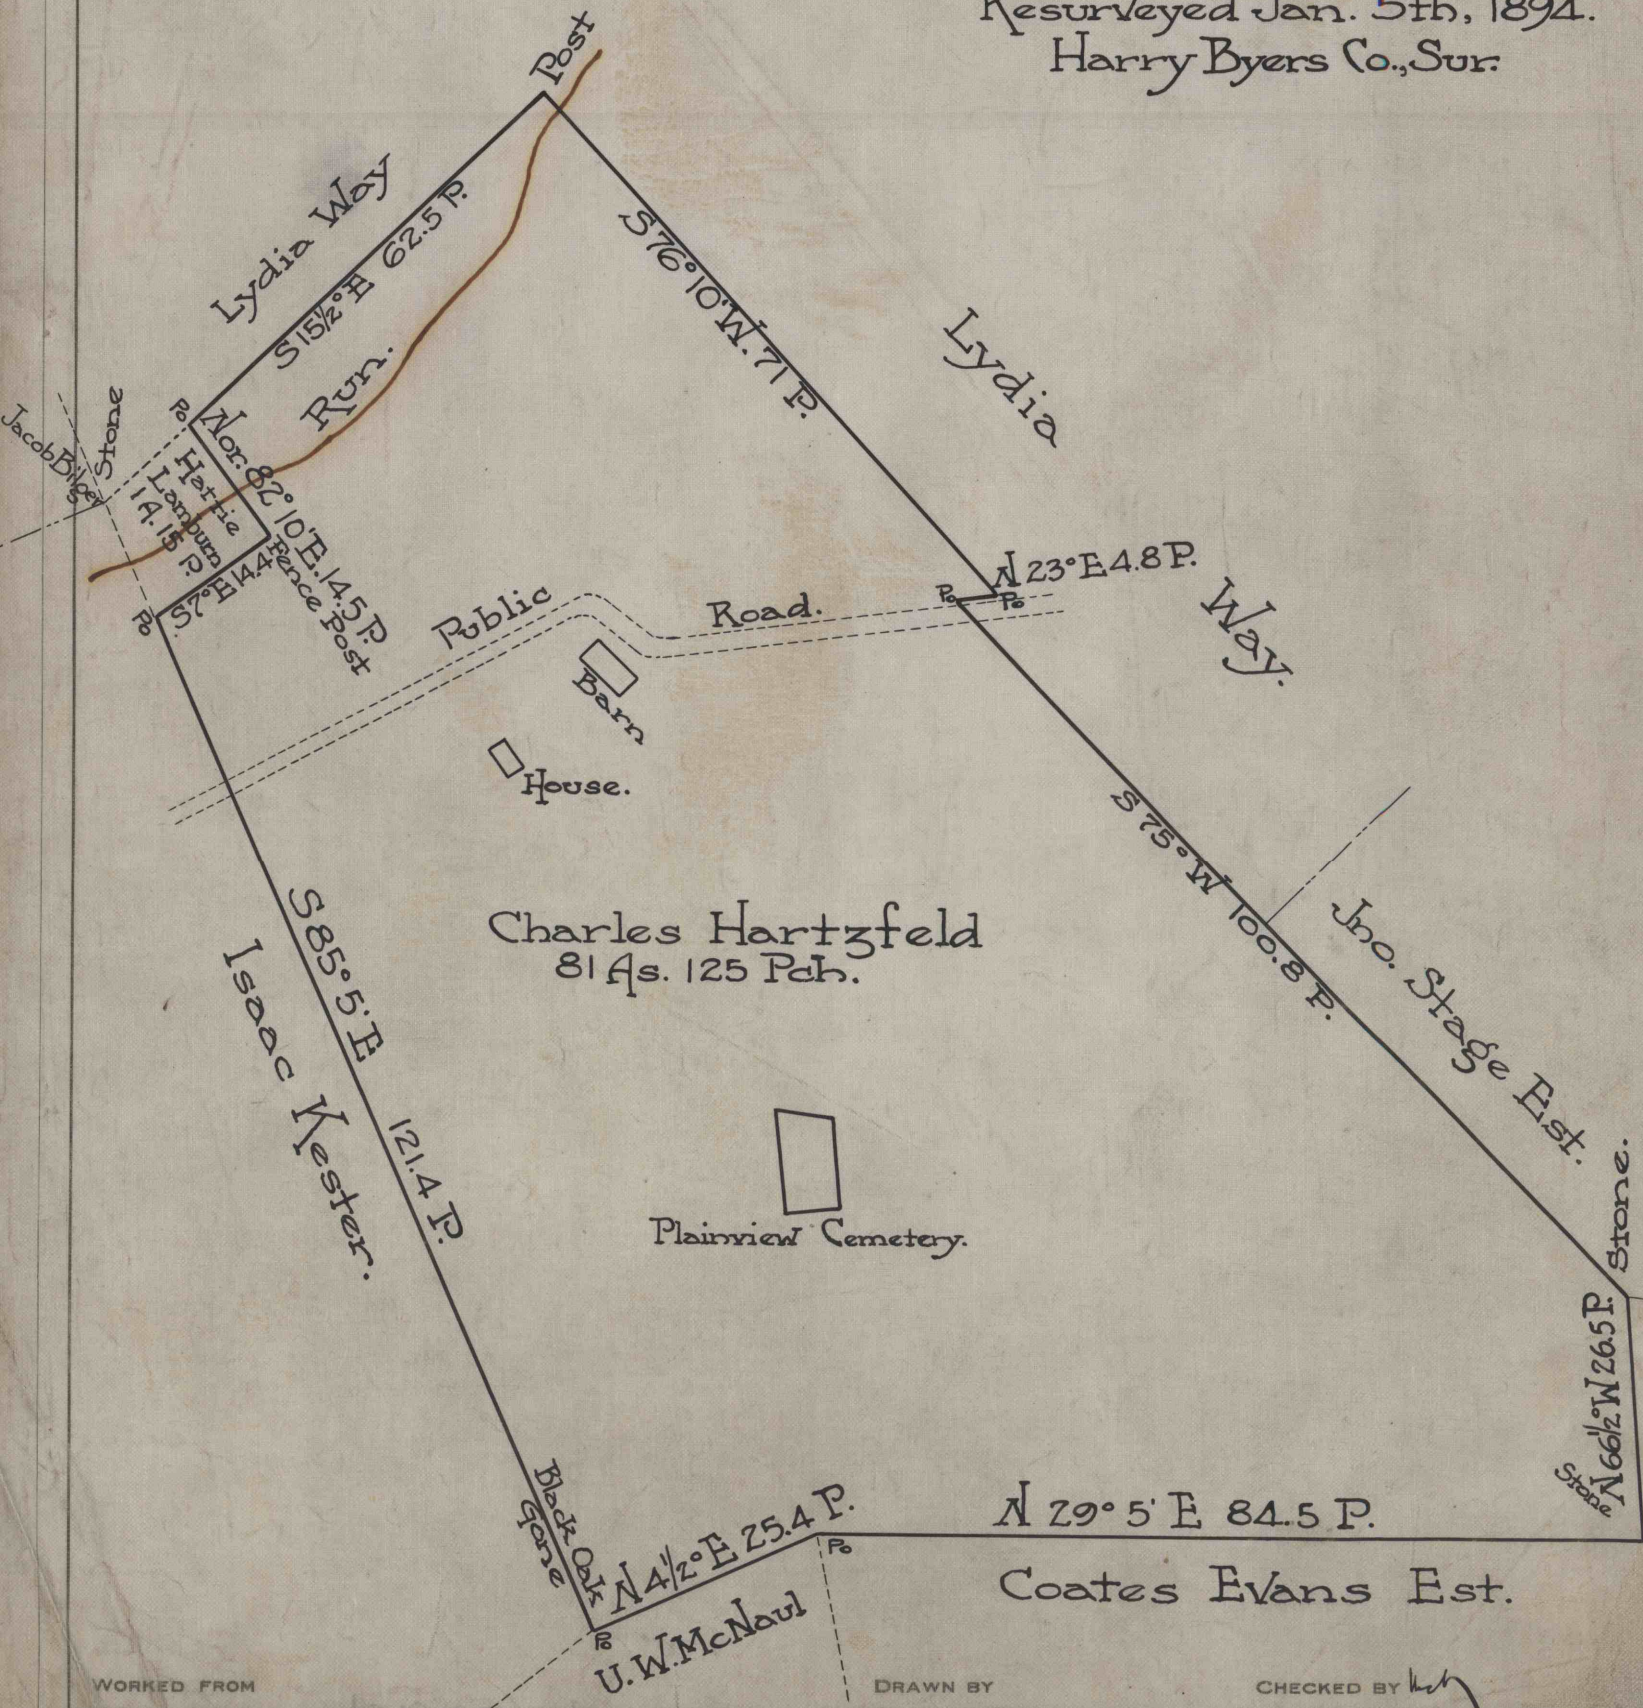

WORKED FROM

DRAWN BY

CHECKED BY *hcb*