

REFERENCE DATA

GEO. S. GOOD FIRE BRICK CO.

CURWENSVILLE, CLEARFIELD COUNTY, PA.

ENGINEERING DEPARTMENT

PROPERTY OF

NORTH AMERICAN REFR. CO.

LOCATED IN

NORTH BEND, CLINTON CO., PA.


ENV. No.

SHEET No.

INDEX 25-3-12

SCALE 1" = 400 Ft.

DATE Aug. 29, 1936.

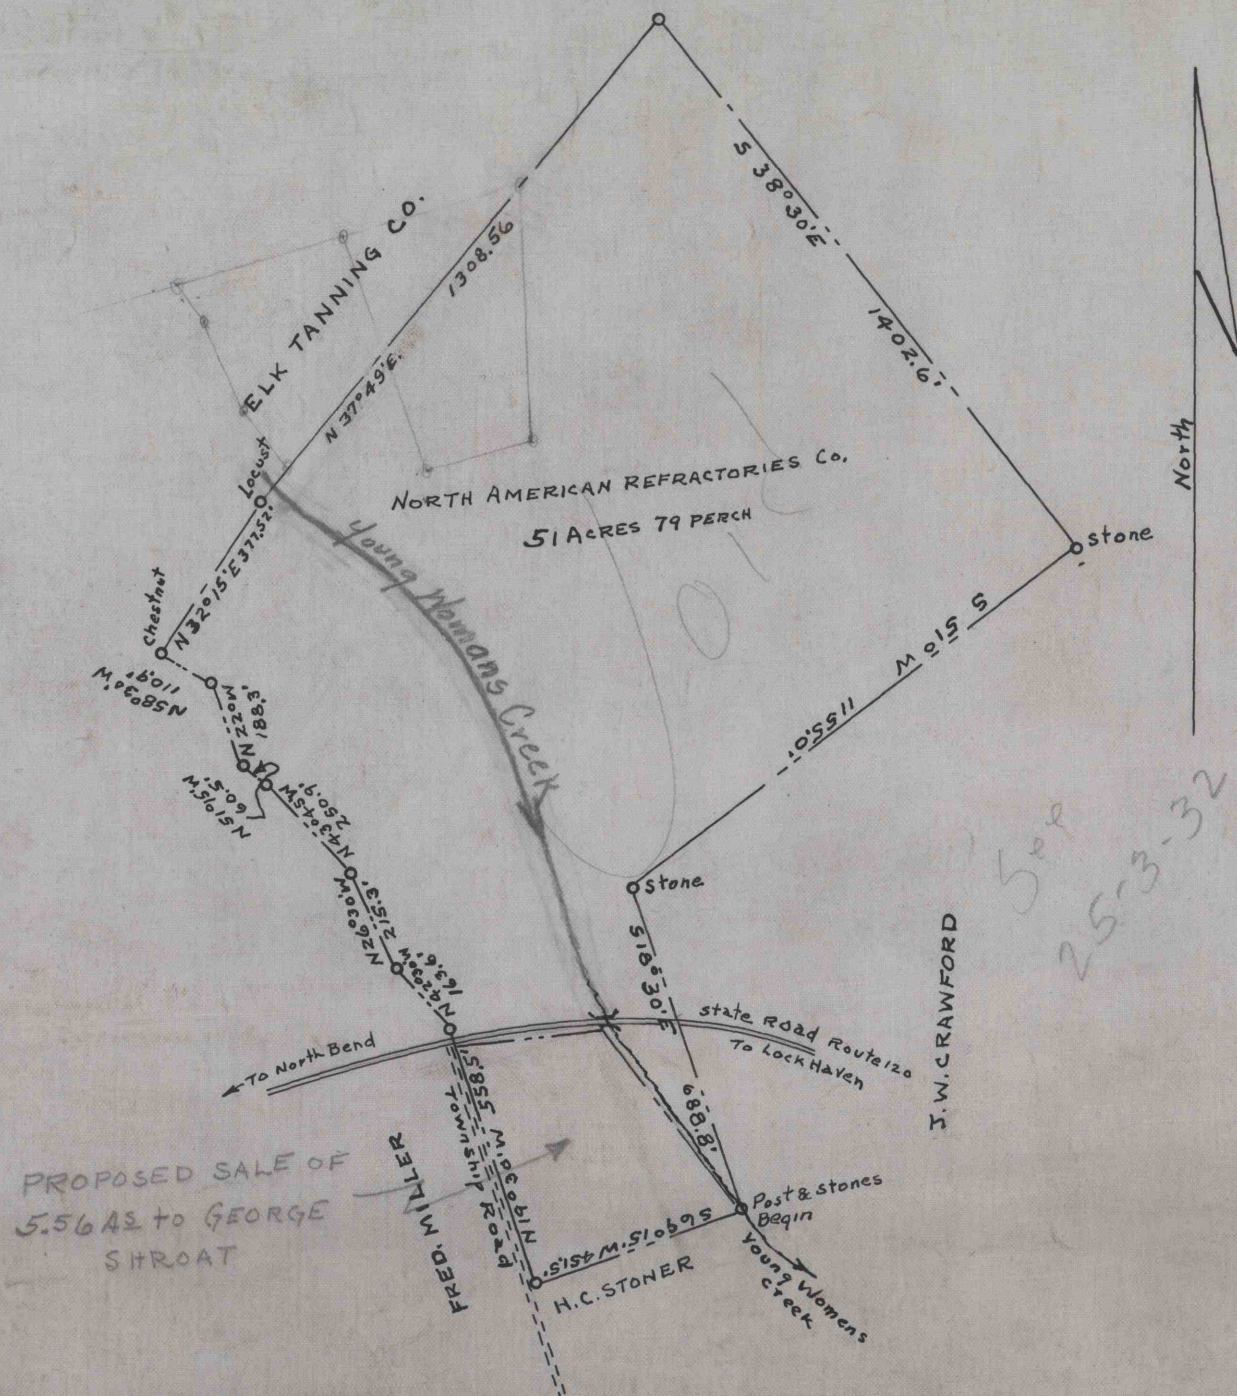

See
25-3-32

PROPOSED SALE OF
5.56 AC. TO GEORGE
SHROAT

WORKED FROM Deed Fred Miller Oct. 1, 1913

DRAWN BY R.F.H., Jr.

CHECKED BY R.J.L.

Recorded at Lock Haven, Deed Book 89 Page 290