

NORTH AMERICAN REFRACTORIES CO.

1012 NATIONAL CITY—EAST 6TH BUILDING

CLEVELAND 14, OHIO


ENV. No. 55-3-168
SHEET No.

MAP SHOWING JOSEPH KIRK PROPERTY LINES

SCALE 1" = 400'

DATE 4-25-55

SURVEYED: BY M.W.D., W.M., & F.H.
LINES PAINTED
IRON PIN CORNERS SET
DATE: 4-20-55

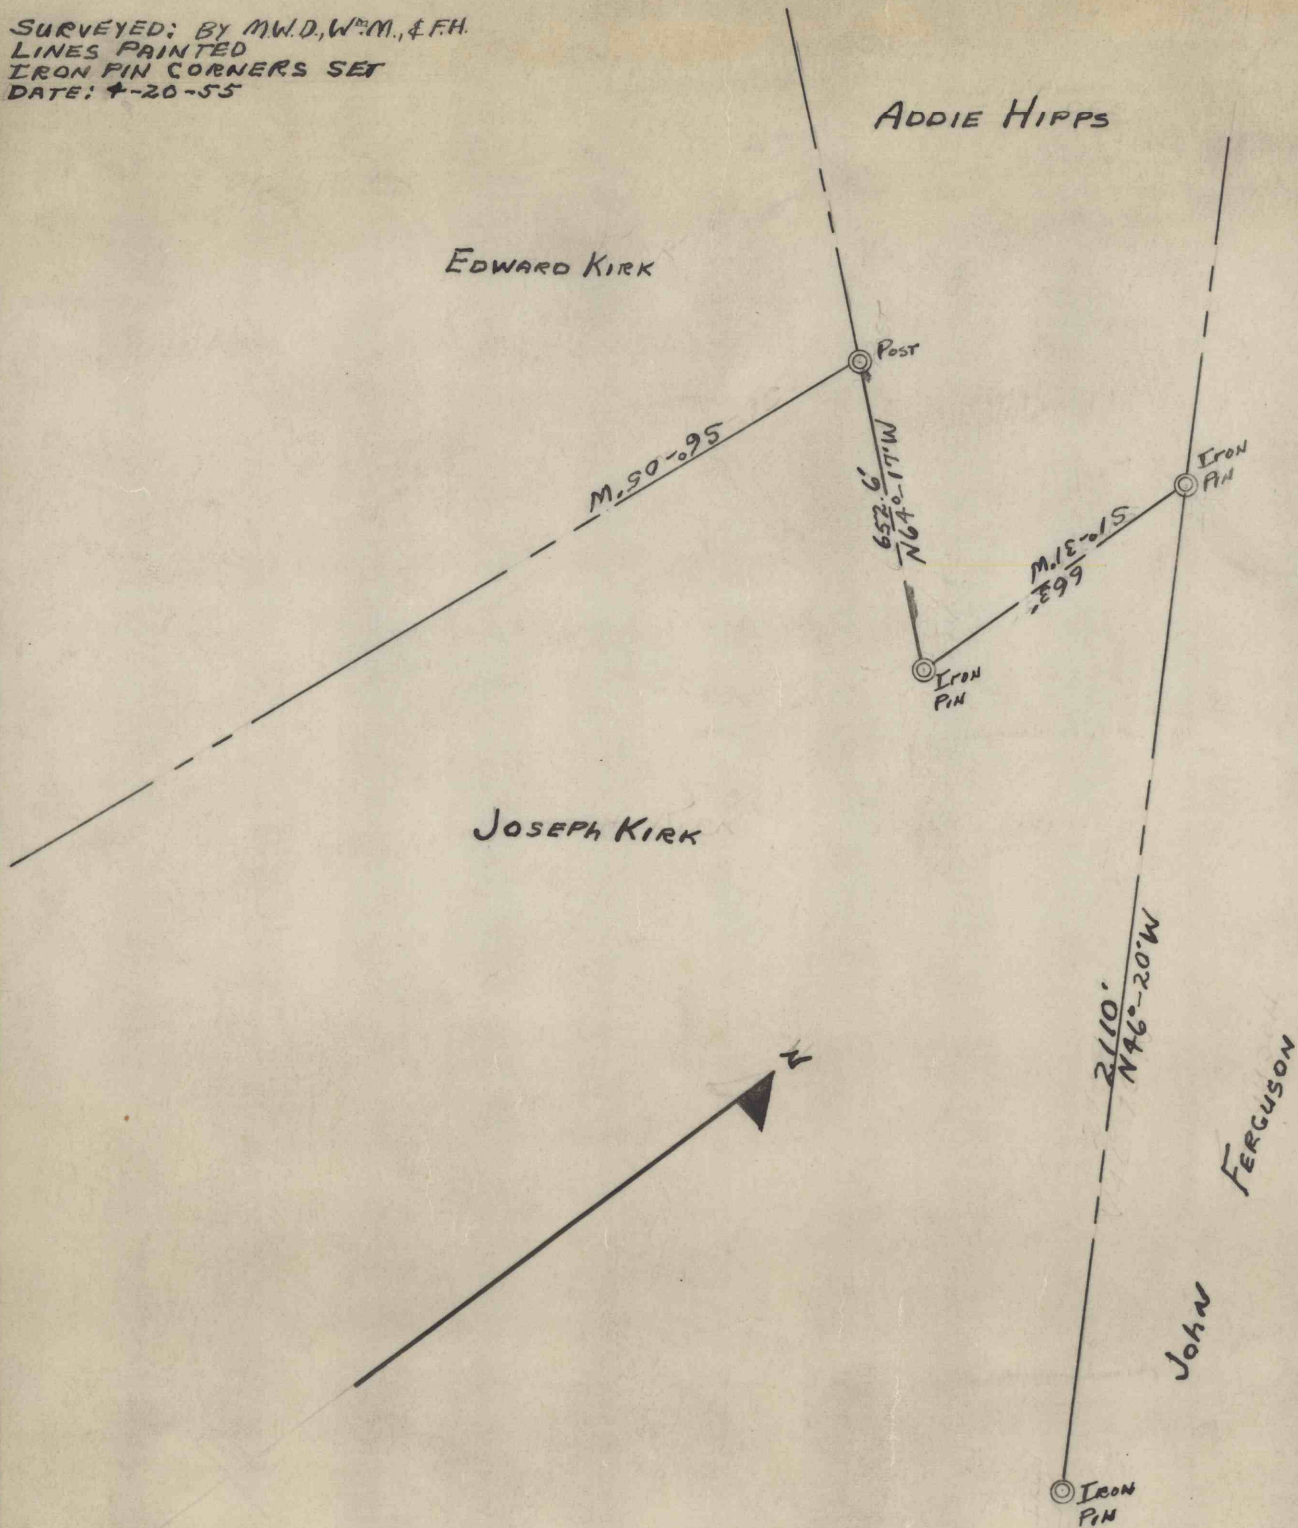

REVISION

DRAWN M.W.D.

CHECKED

REFERENCE: SURVEY - BOOK #257 - Page 36 thru 42