


B. R. & P. RAILROAD.
SIDING. To DuBois. →

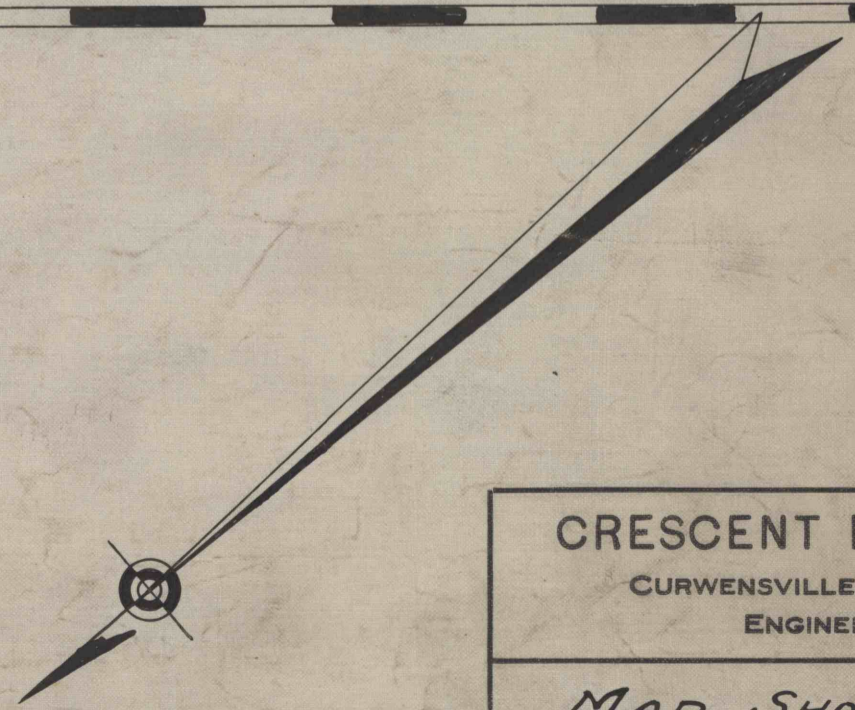

CRESCENT REFRACTORIES CO.
CURWENSVILLE, CLEARFIELD COUNTY, PA.
ENGINEERING DEPARTMENT

MAP SHOWING WATER LINE
ON CRESCENT ADDITION

DRAWN H.S.C. SCALE 1"=50' 50-3-78
CHECKED DATE 1-11-19 1046-1
REFERENCE 1031-I ORDER