


BURGOON'S DEED

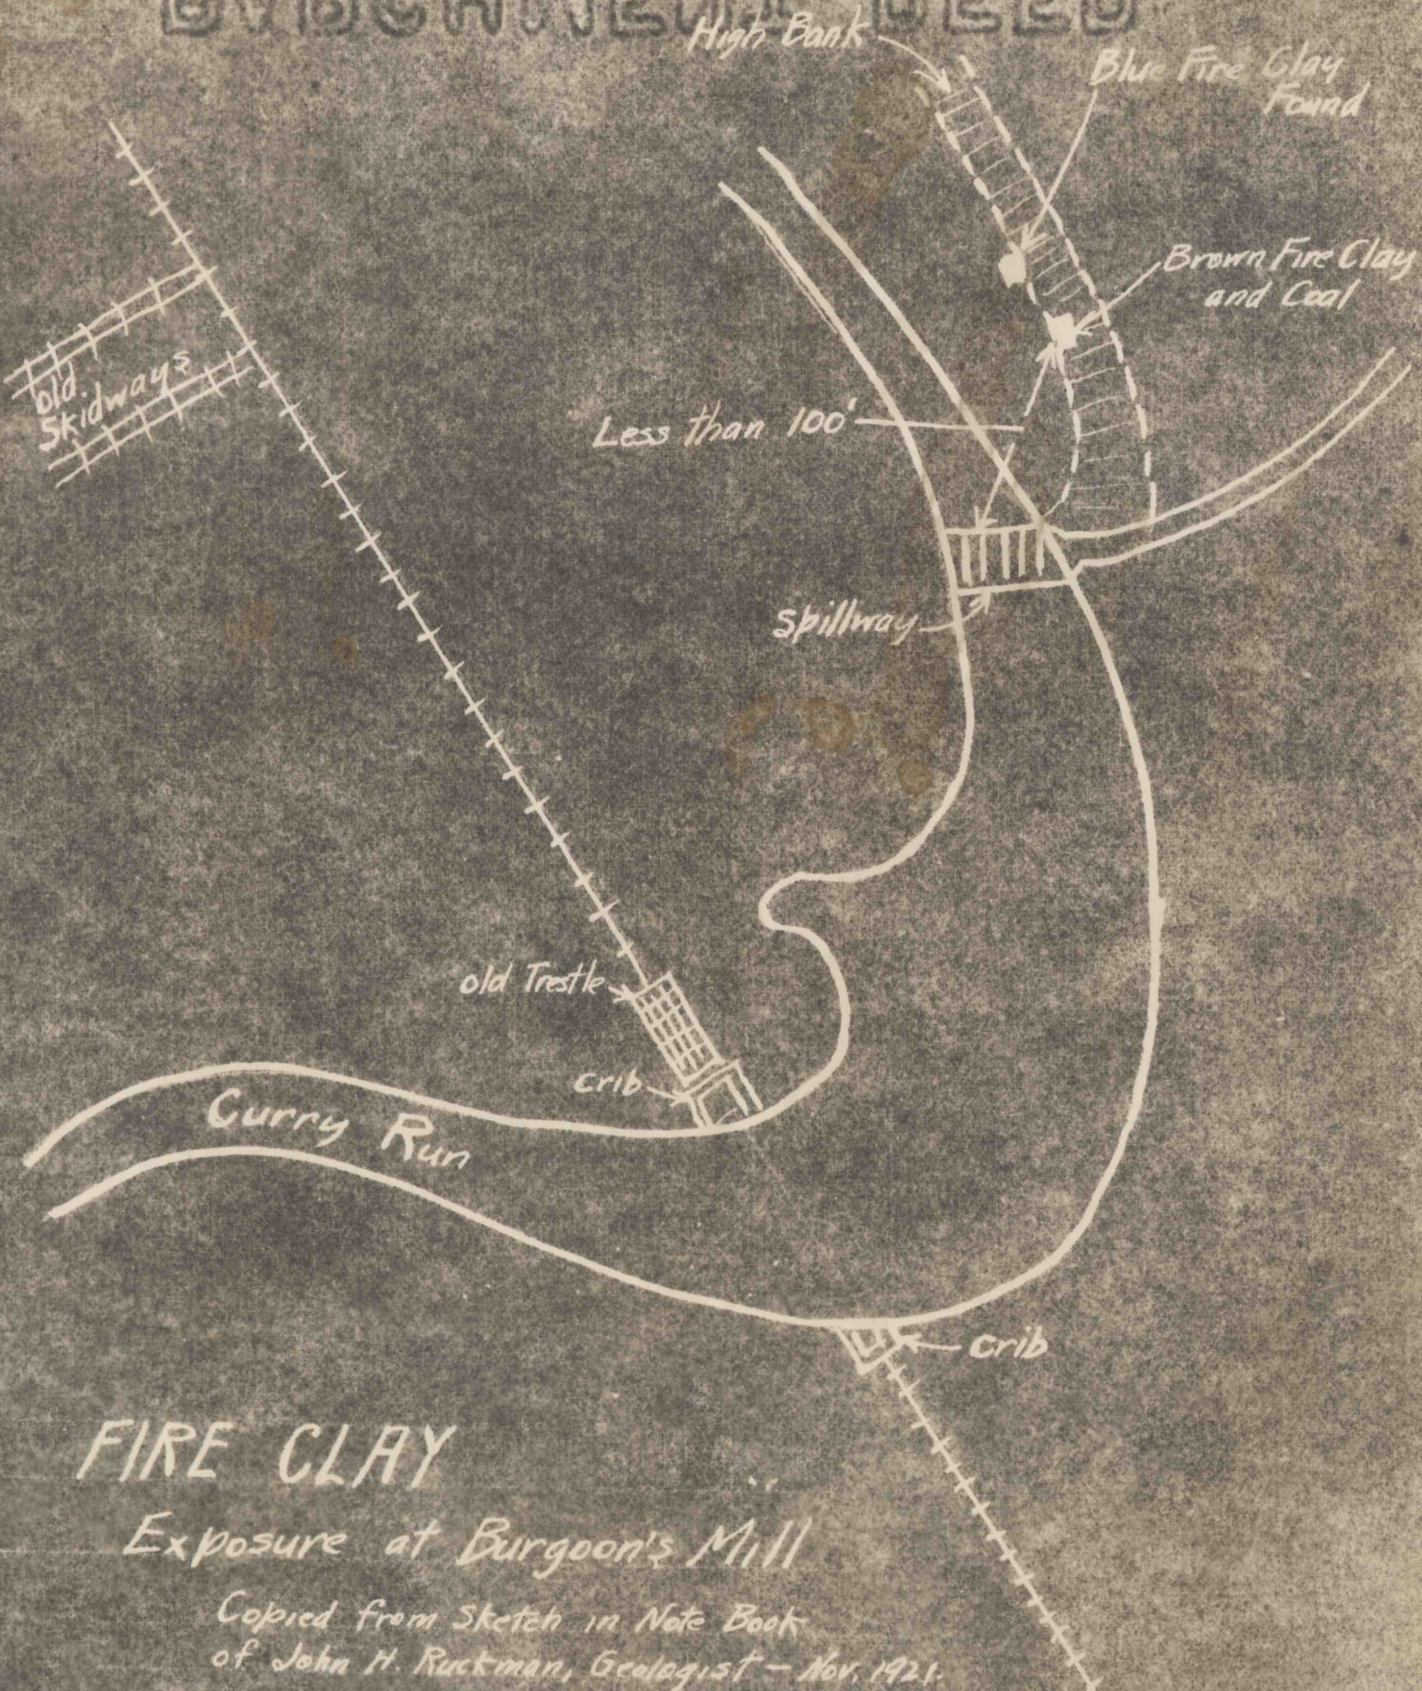

FIRE CLAY

Exposure at Burgoon's Mill

Copied from Sketch in Note Book
of John H. Ruckman, Geologist - Nov. 1921.