

REFERENCE DATA

CRESCENT REFRACTORIES CO.

CURWENSVILLE, CLEARFIELD COUNTY, PA.

ENGINEERING DEPARTMENT


LITTLE ANDERSON CREEK BRANCH RAILROAD ALIGNMENT  
OF CURVE AT OLD MILL DAM AS FOUND-11-24-19.

ENV. NO. L1

SHEET NO. 138  
503328

SCALE 1"=100'

DATE 11-25-19

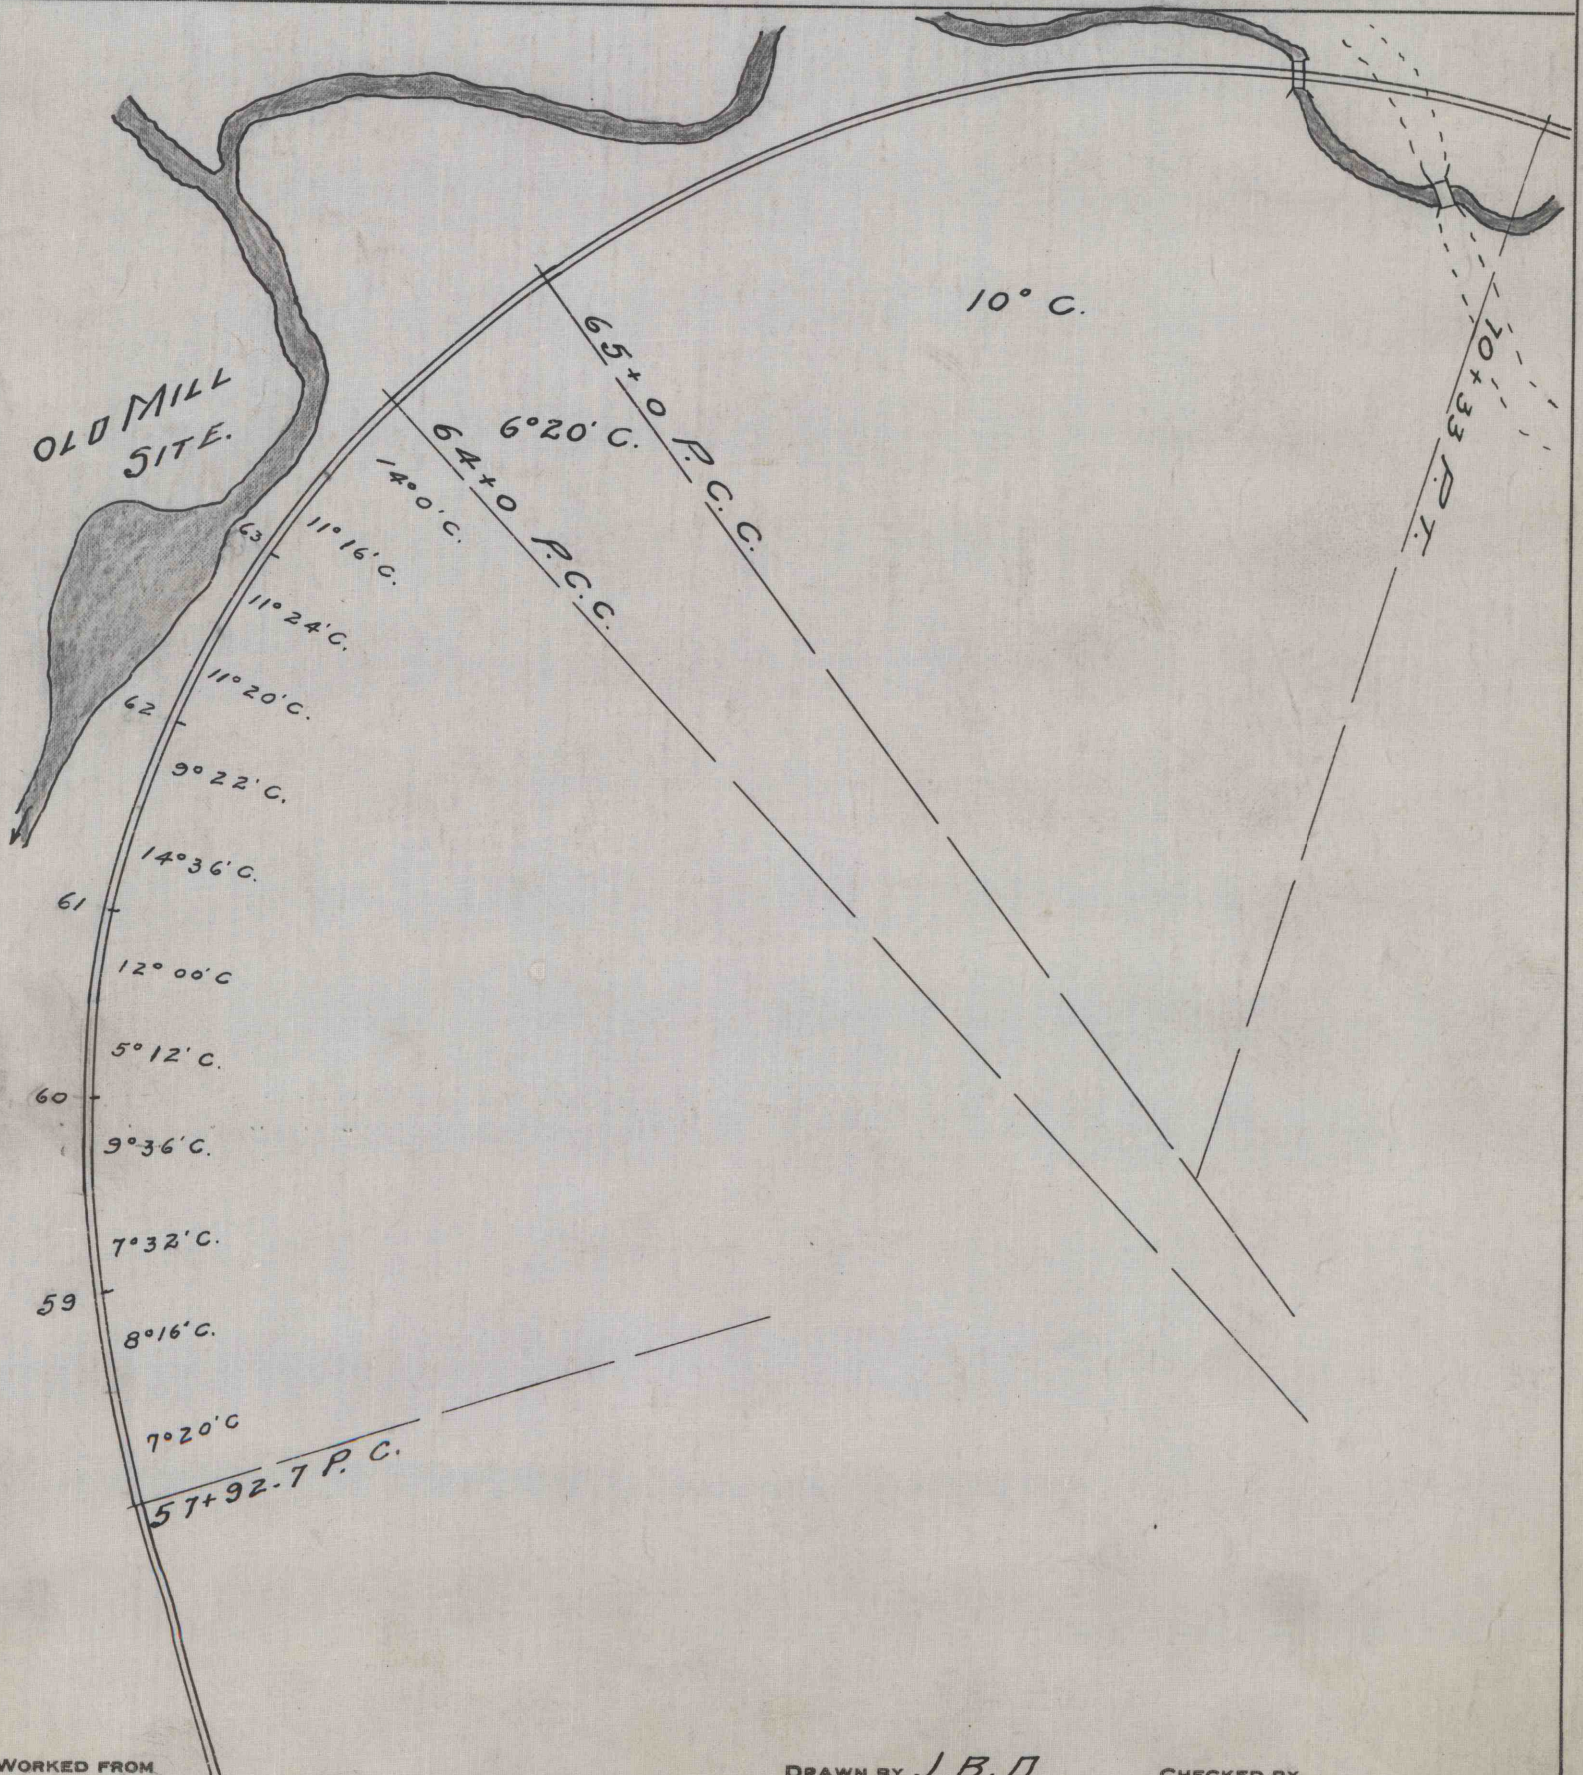

WORKED FROM

DRAWN BY J. B. D.

CHECKED BY