


65-3-12

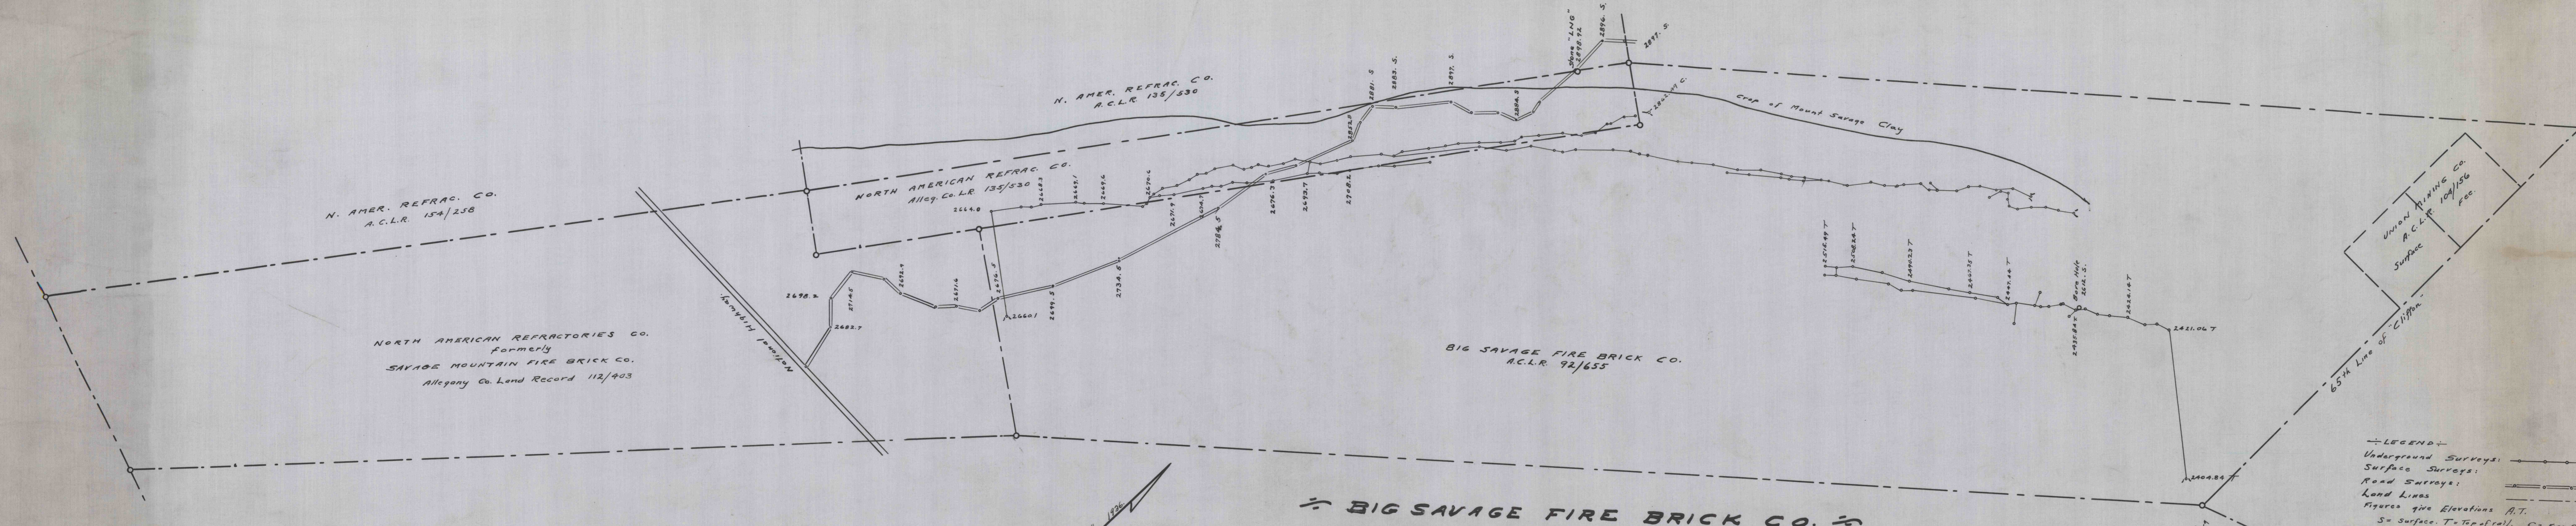

NORTH AMERICAN REFRATORIES CO.
formerly
SAVAGE MOUNTAIN FIRE BRICK CO.
Allegany Co. Land Record 112/403

BIG SAVAGE FIRE BRICK CO.
A.C.L.R. 92/655

BIG SAVAGE FIRE BRICK CO.

PROPERTIES OF
BIG SAVAGE FIRE BRICK CO.
AND
NORTH AMERICAN REFRATORIES CO.
in Allegany Co. Maryland

Scale: 400' = 1"

June 1936.

F. Ernest Brackett
Cumberland Md.

Traced From B/p 9/17/37 JEA.

LEGEND:
Underground Surveys: —○—○—
Surface Surveys: —●—●—
Road Surveys: —▬—▬—
Land Lines: ————
Figures give Elevations A.T.
S = Surface. T = Top of rail. C = Fire Clay.