


FINAL SURVEY	DATE
SURVEYED	BY
PLOTTED	
TEMPLATE	
NOTE BOOK	
AREAS CHECKED	

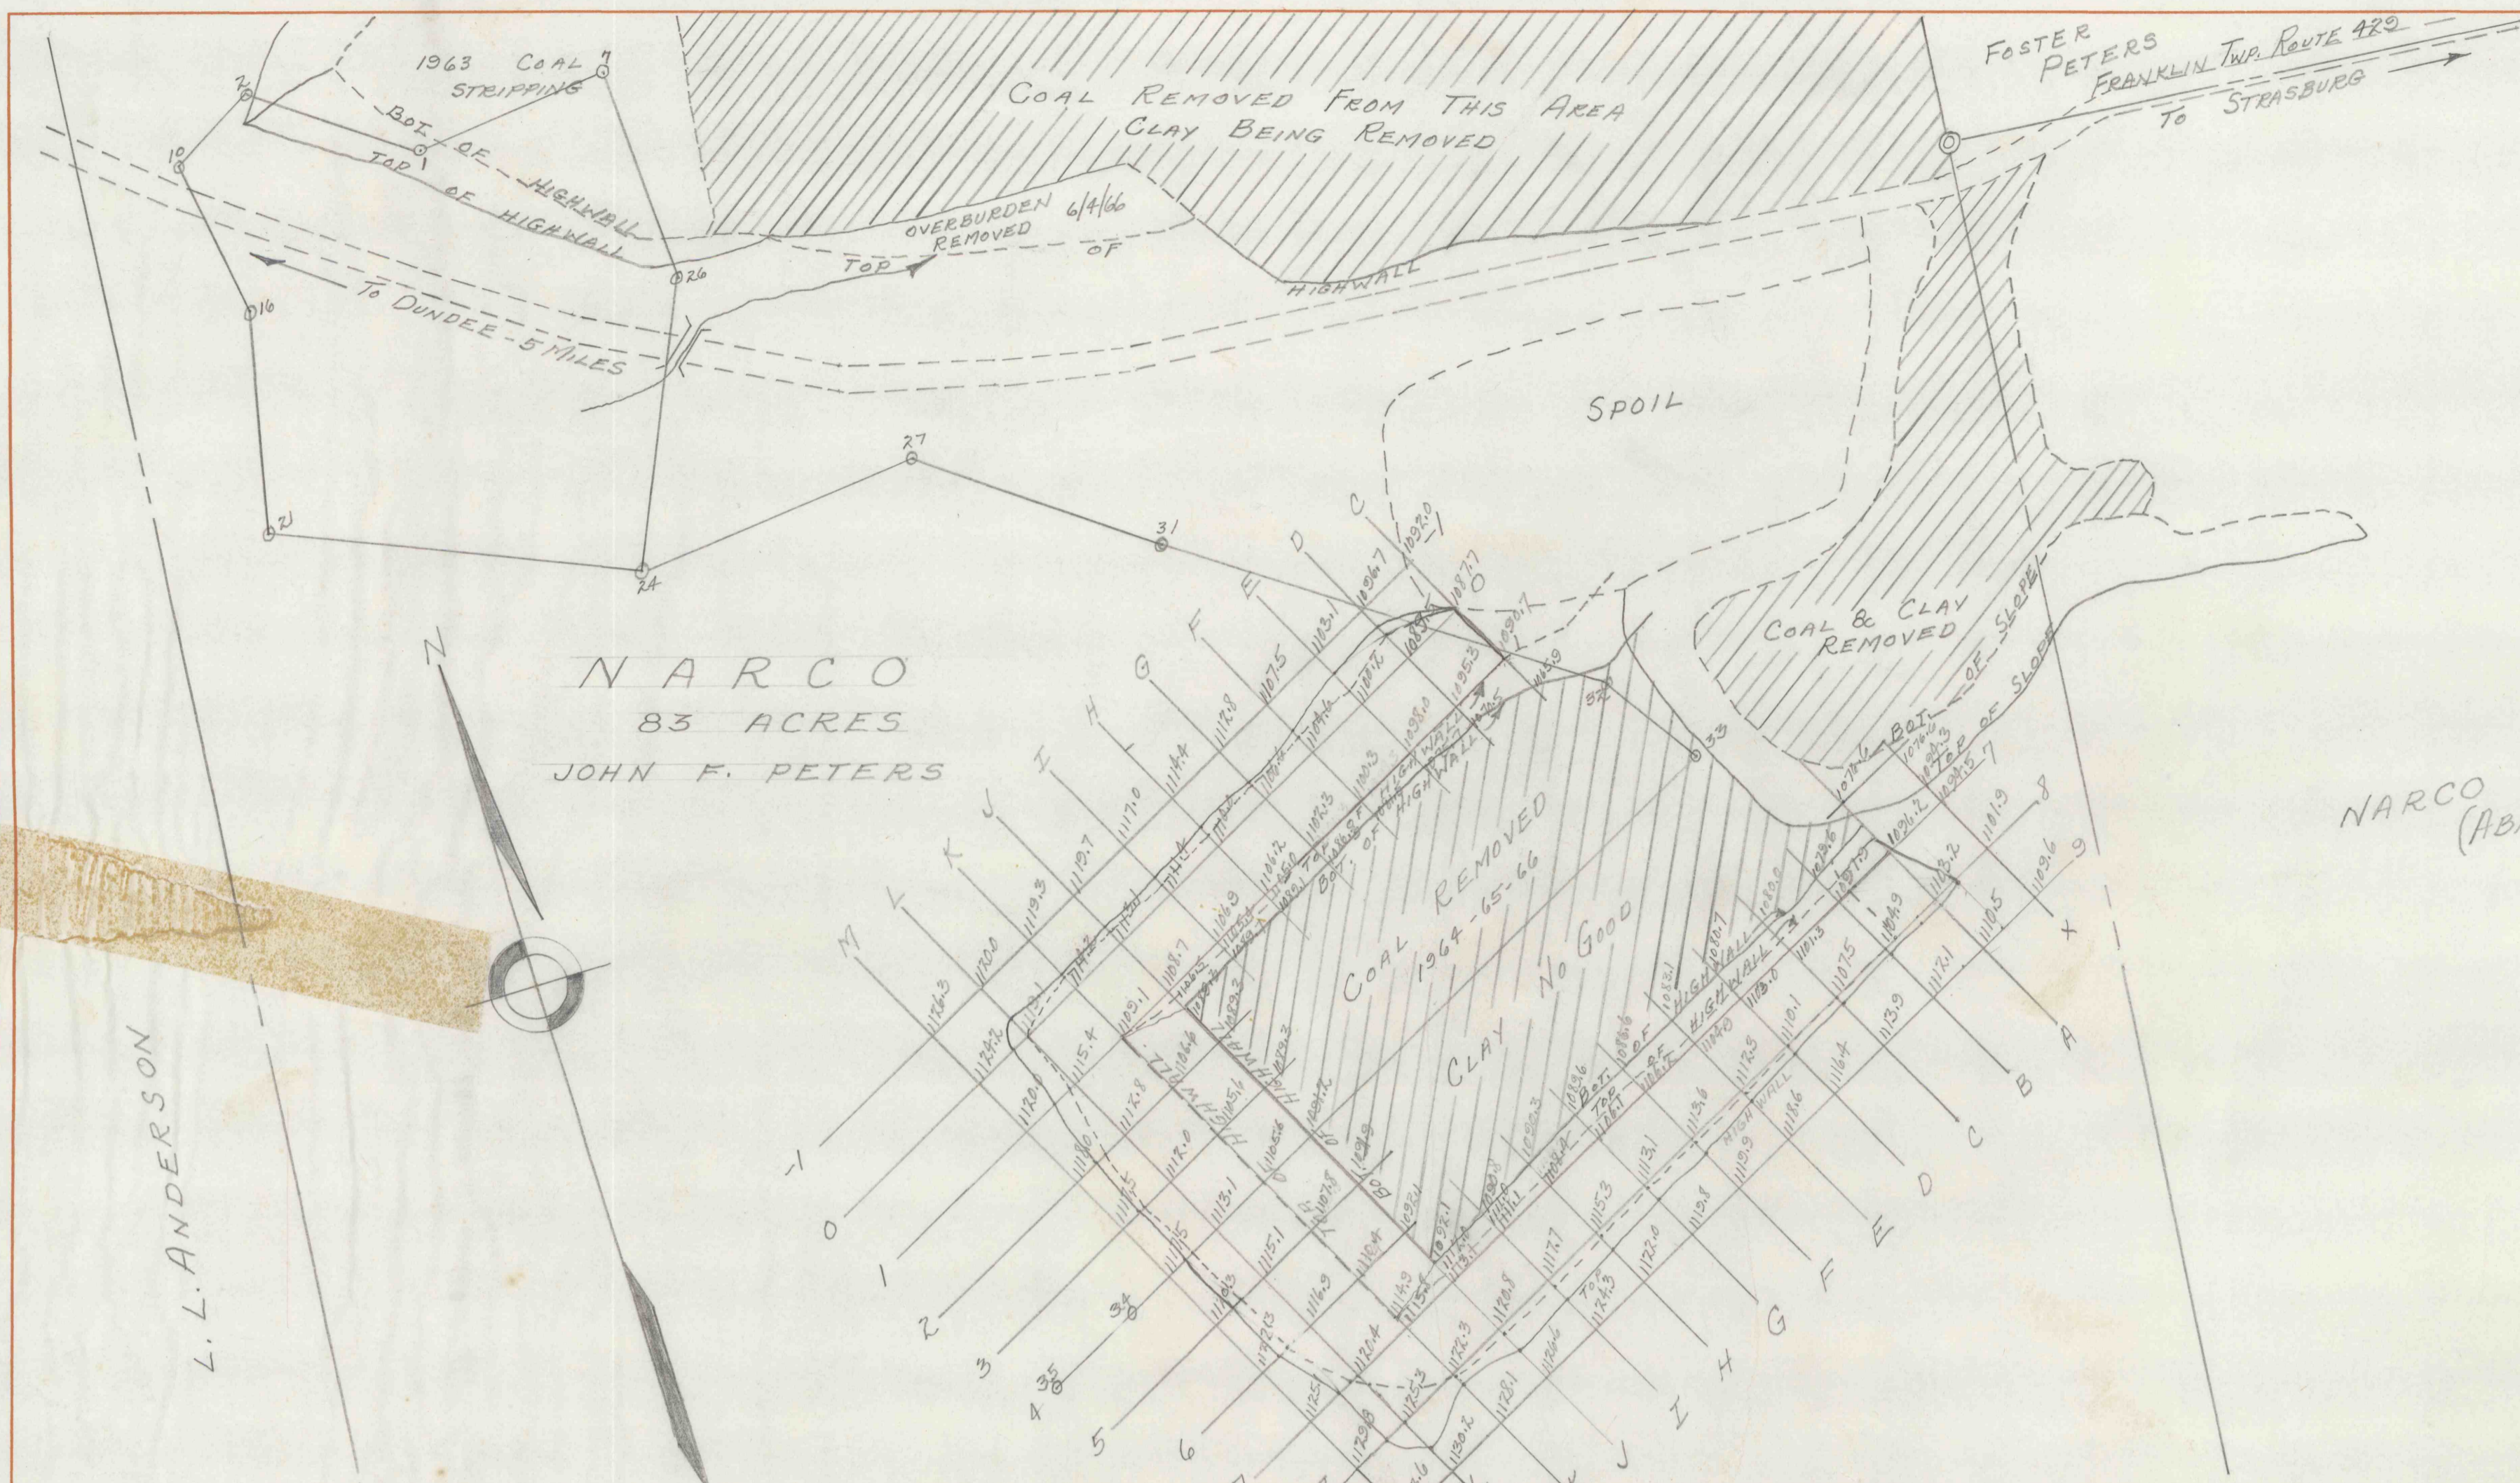

NORTH AMERICAN REFRACTORIES CO.
CLEVELAND, OHIO



PLAN AND CROSS SECTIONS FOR 1966
COAL STRIPPING - PETERS 83 A^c TRACT
FRANKLIN TOWNSHIP - TUSCARAWAS COUNTY - OHIO

SCALE: PLAN: 1"=100 FT. - CROSS SECTIONS - HOR. - 1"=10 FT.; VER. - 1"=10 FT.

DRAWN: G.C.H.A. SURVEYED: JUNE 21-22, 1966 NB No. 15, PGS. 42-47.

INDEX No. 75-3-242

ORIGINAL SURVEY	DATE
SURVEYED	BY
PLOTTED	
TEMPLATE	
NOTE BOOK	
AREAS CHECKED	

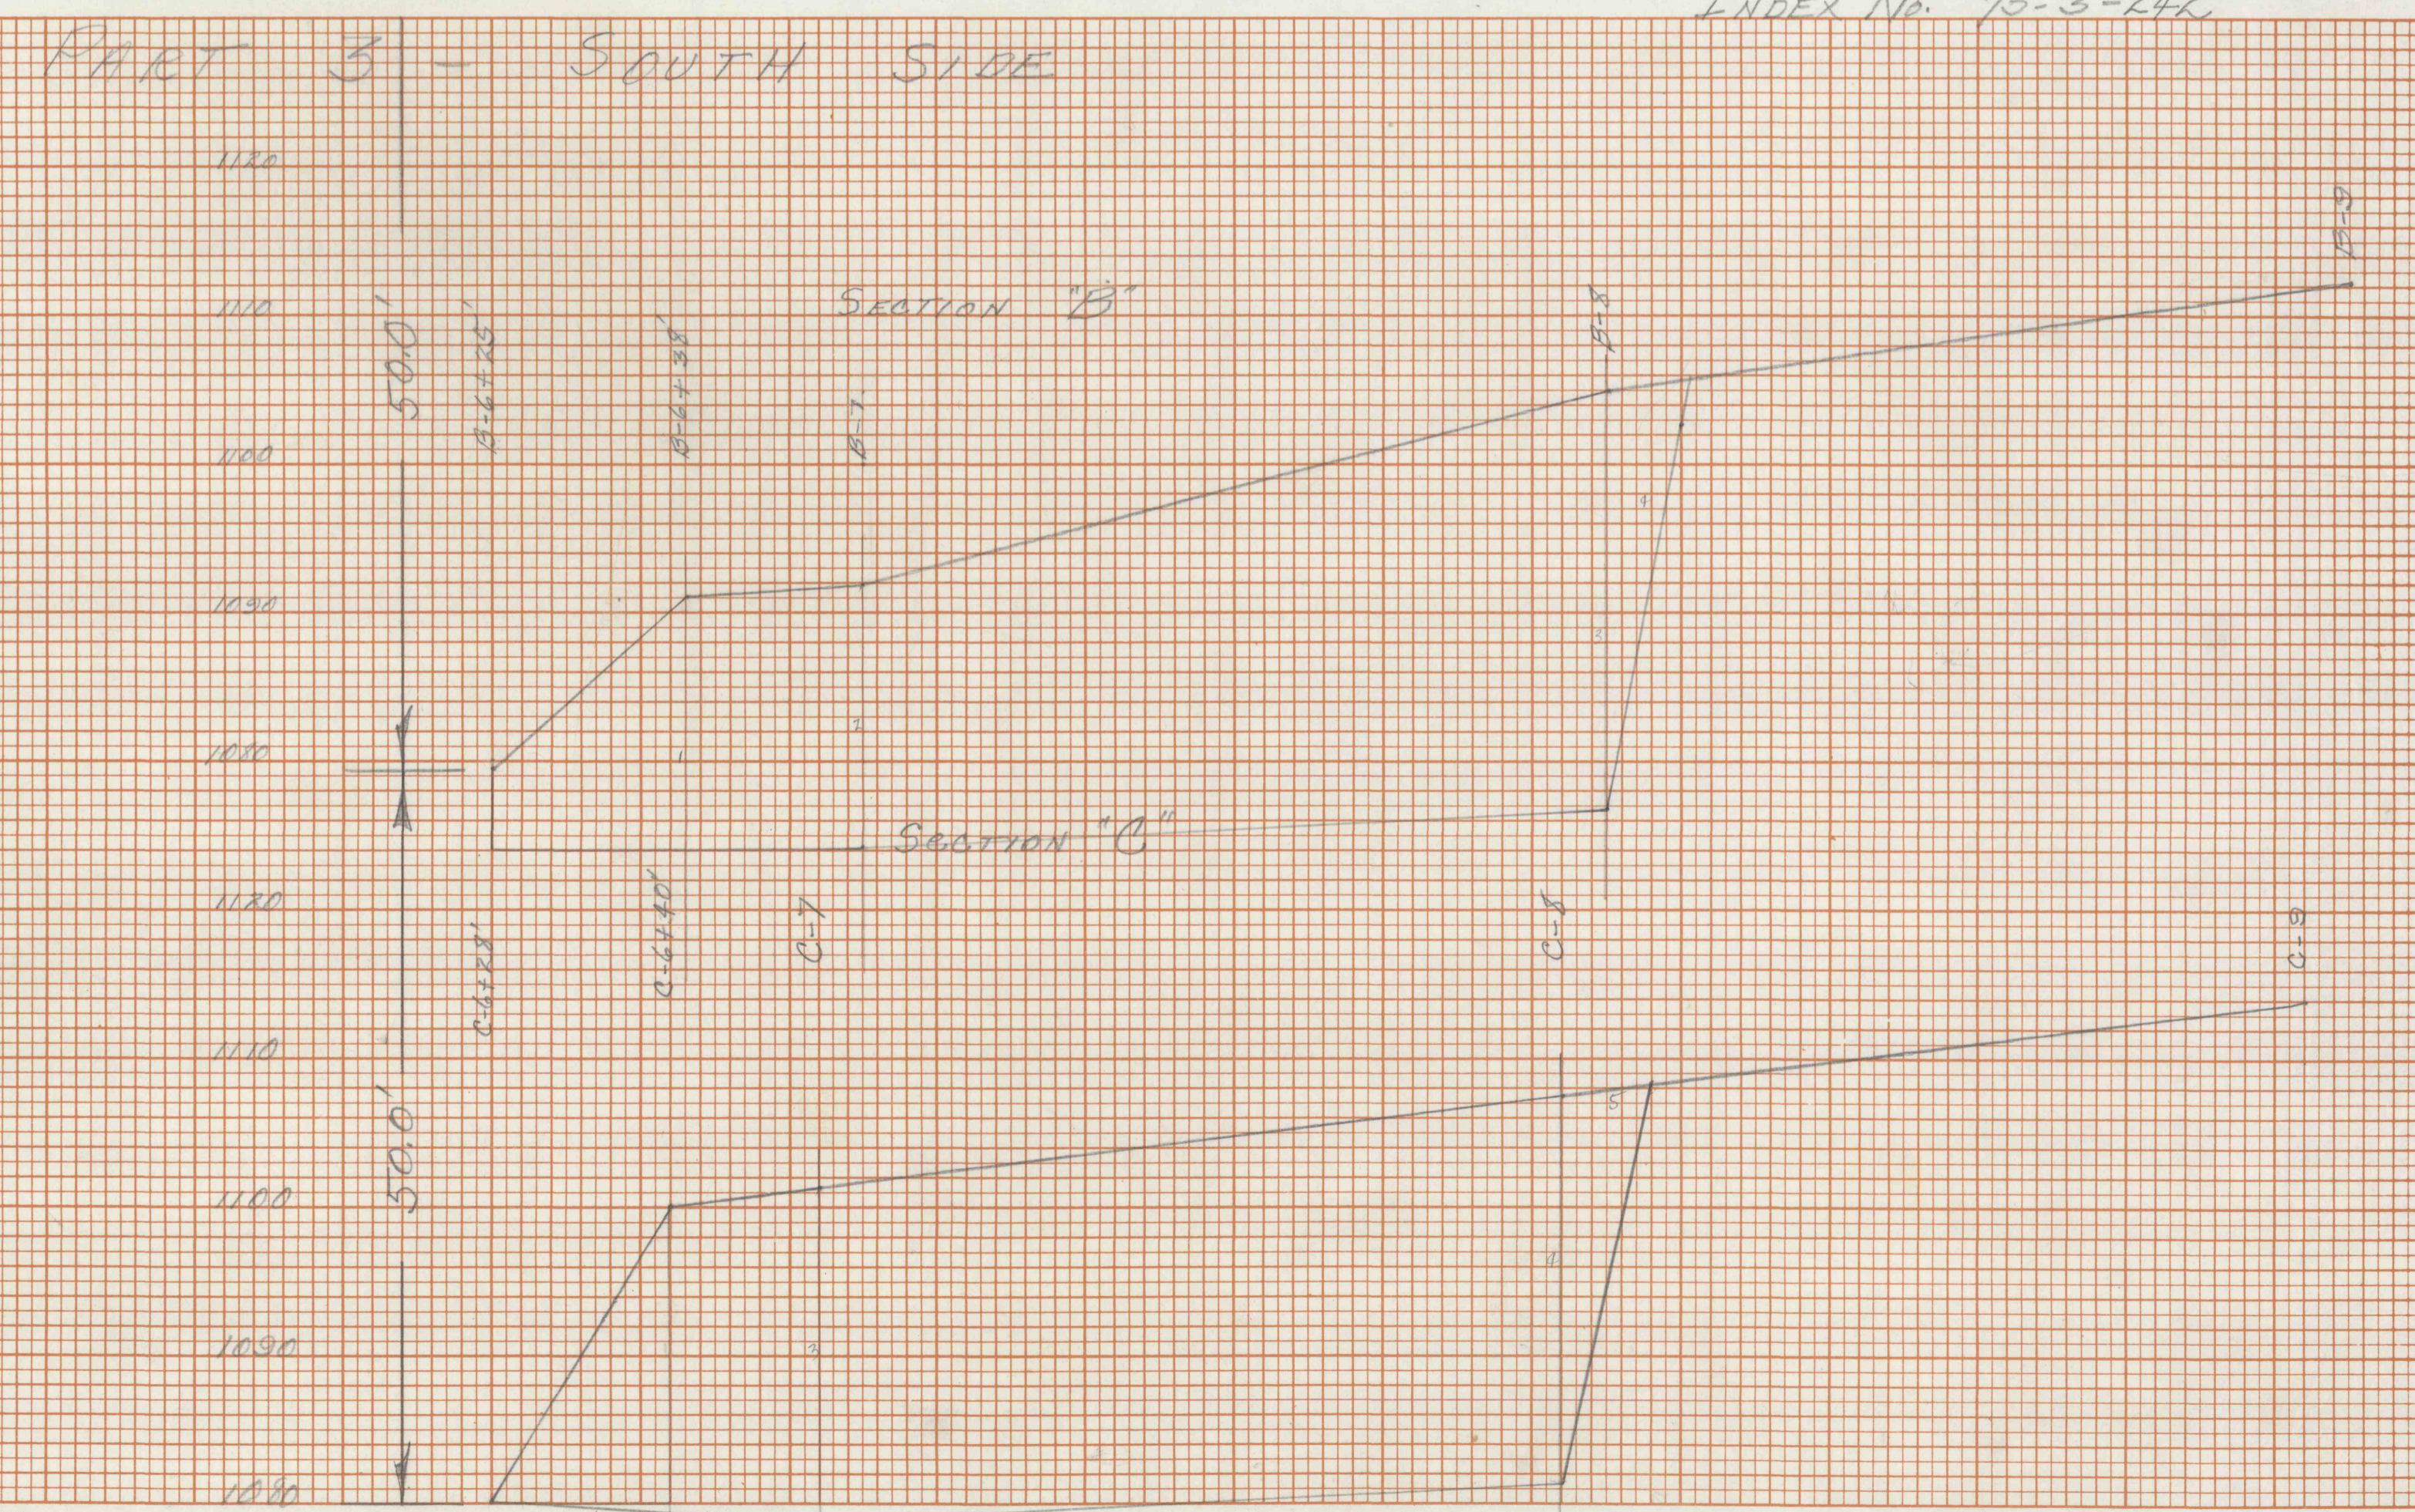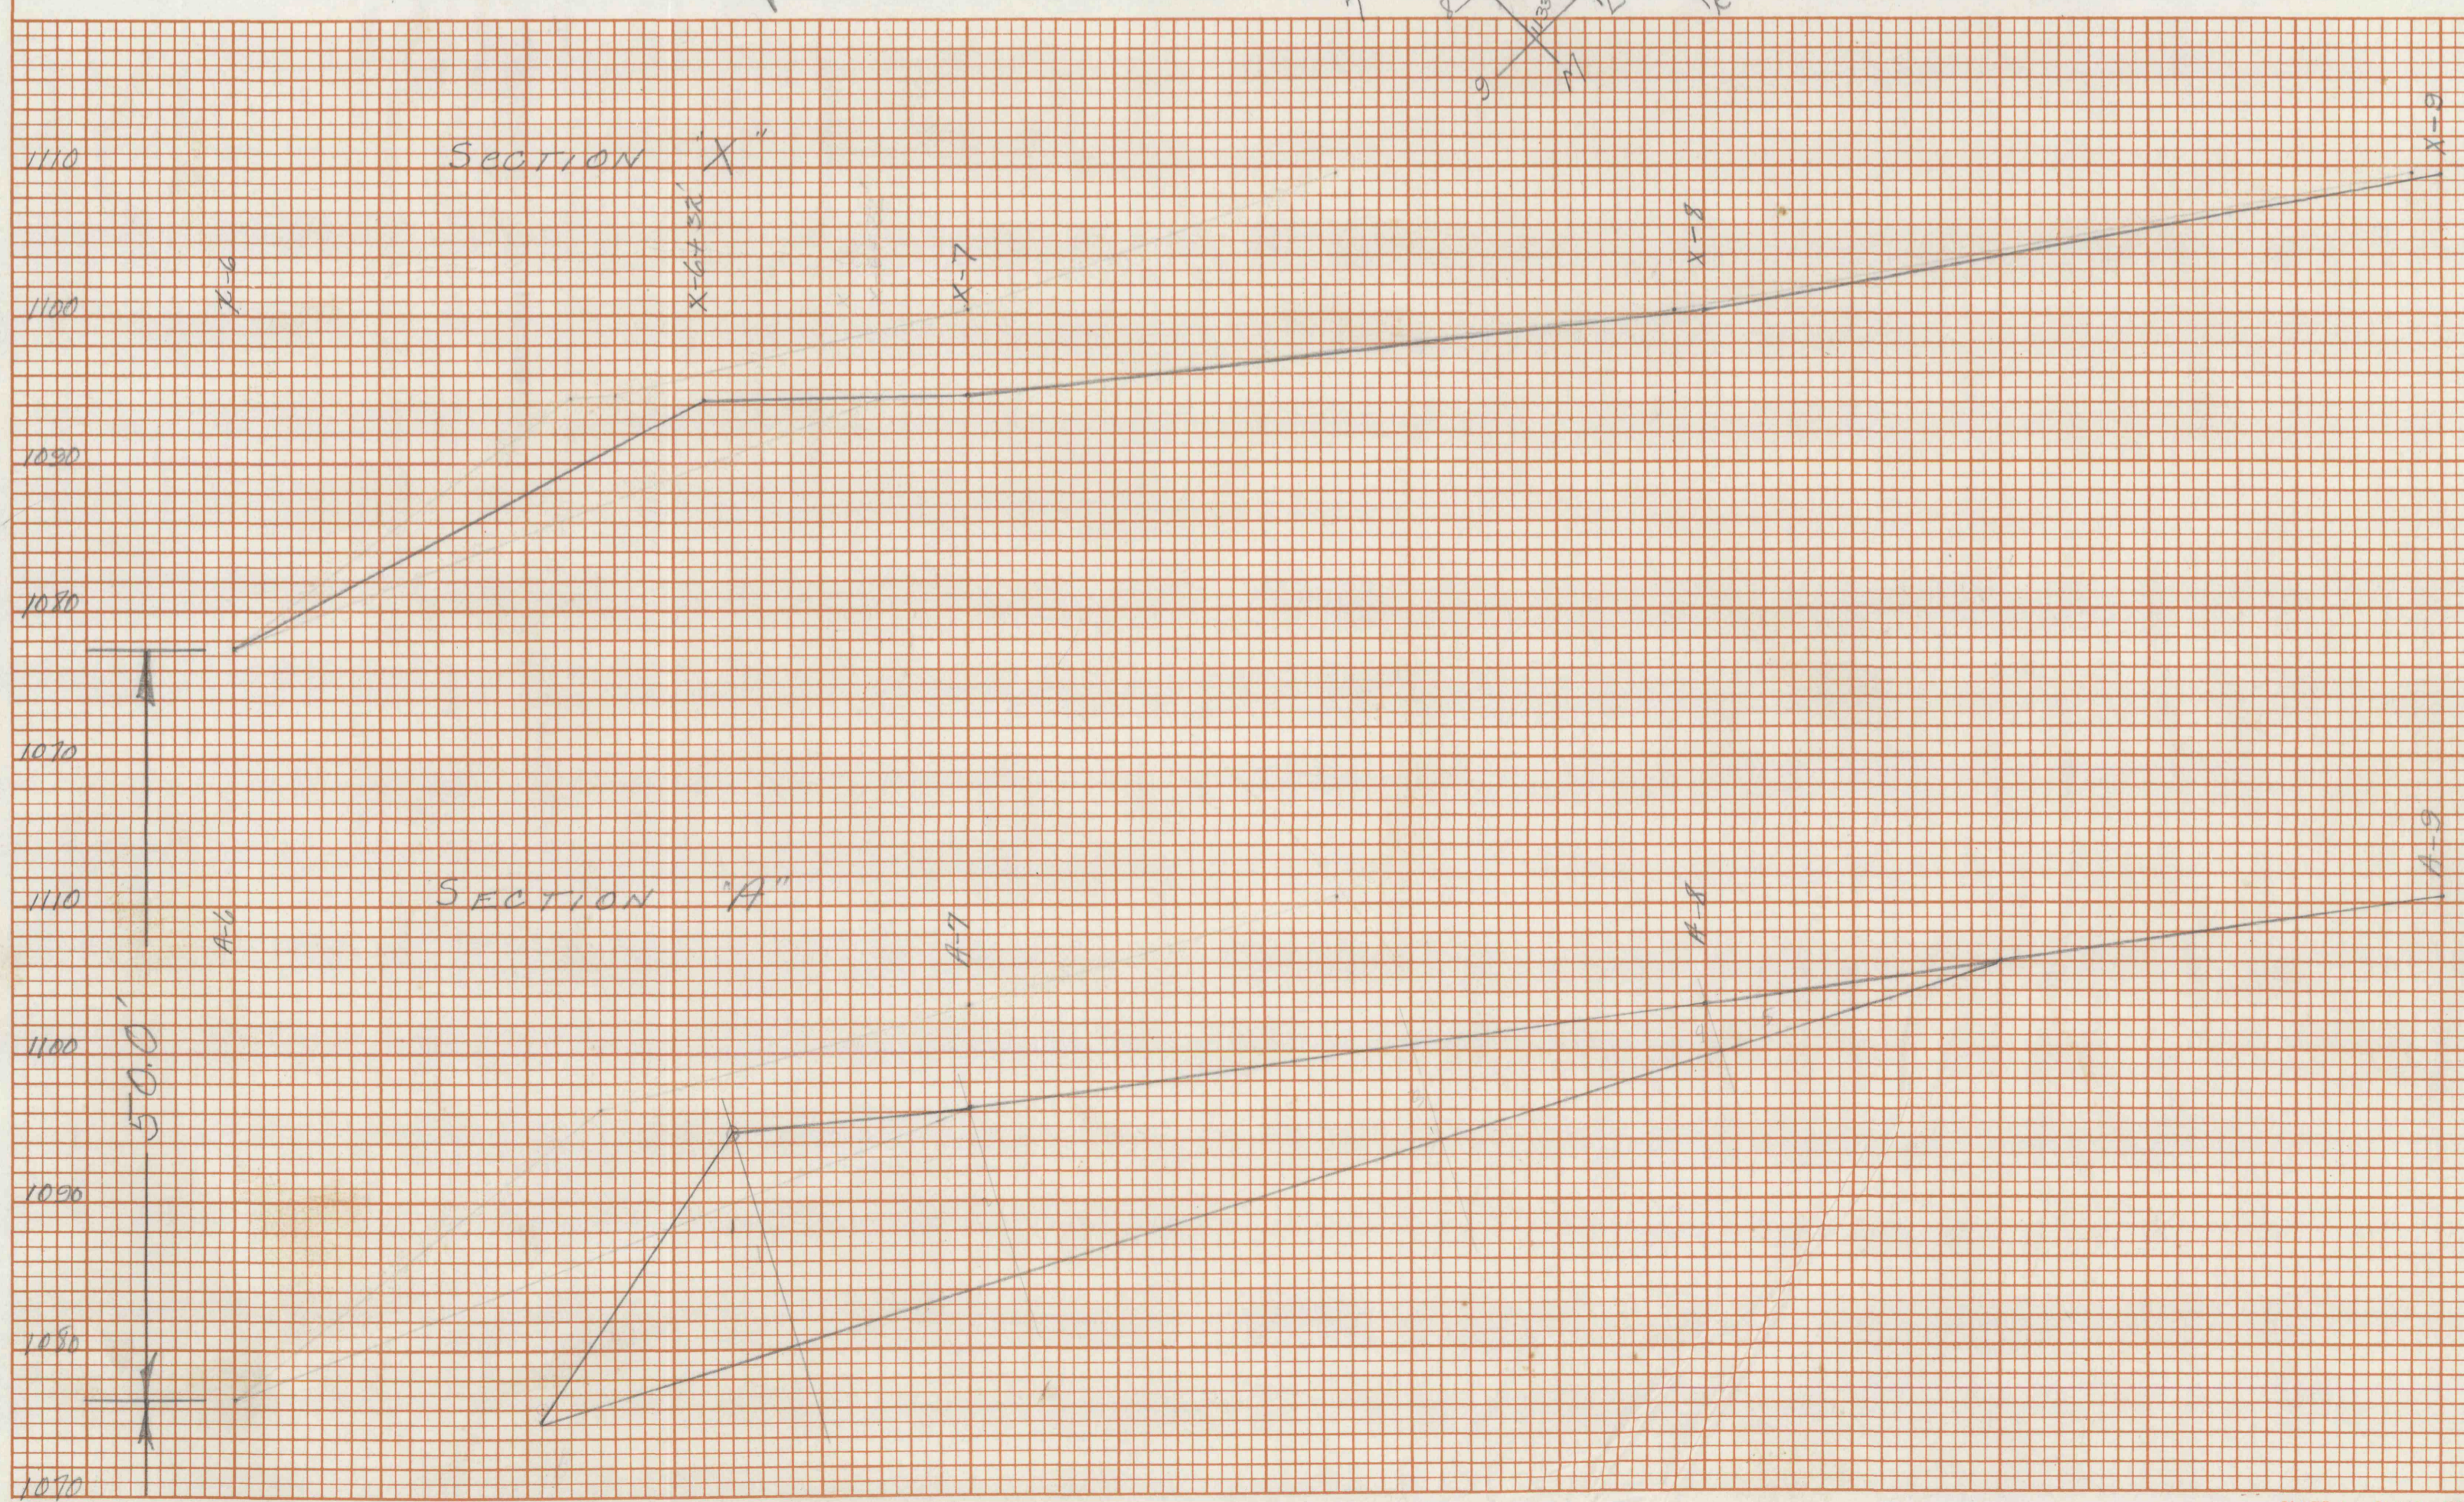

15-111-0151