

WILLIAM HOSTETLER (NARCO) HOSTETLER 1A. TRACT (NARCO) - BERNHARDT


LESTER L. ANDERSON

JOHN F. PETERS - 83A ± NARCO COAL & CLAY LEASE

NORTH AMERICAN REFRACTORIES CO. PLAN & CROSS-SECTIONS FOR 1963 COAL STRIPPING - JOHN F. PETERS FRANKLIN TOWNSHIP, TUSCARAWAS COUNTY, OHIO SCALE: PLAN: 1" = 50 FT; CROSS SECTIONS: HOR: 1" = 10 FT; VER: 1/2" = 10 FT DRAWN: TRACED: DATE:

EDWARD A. PETERS

INDEX No. 75-3-100

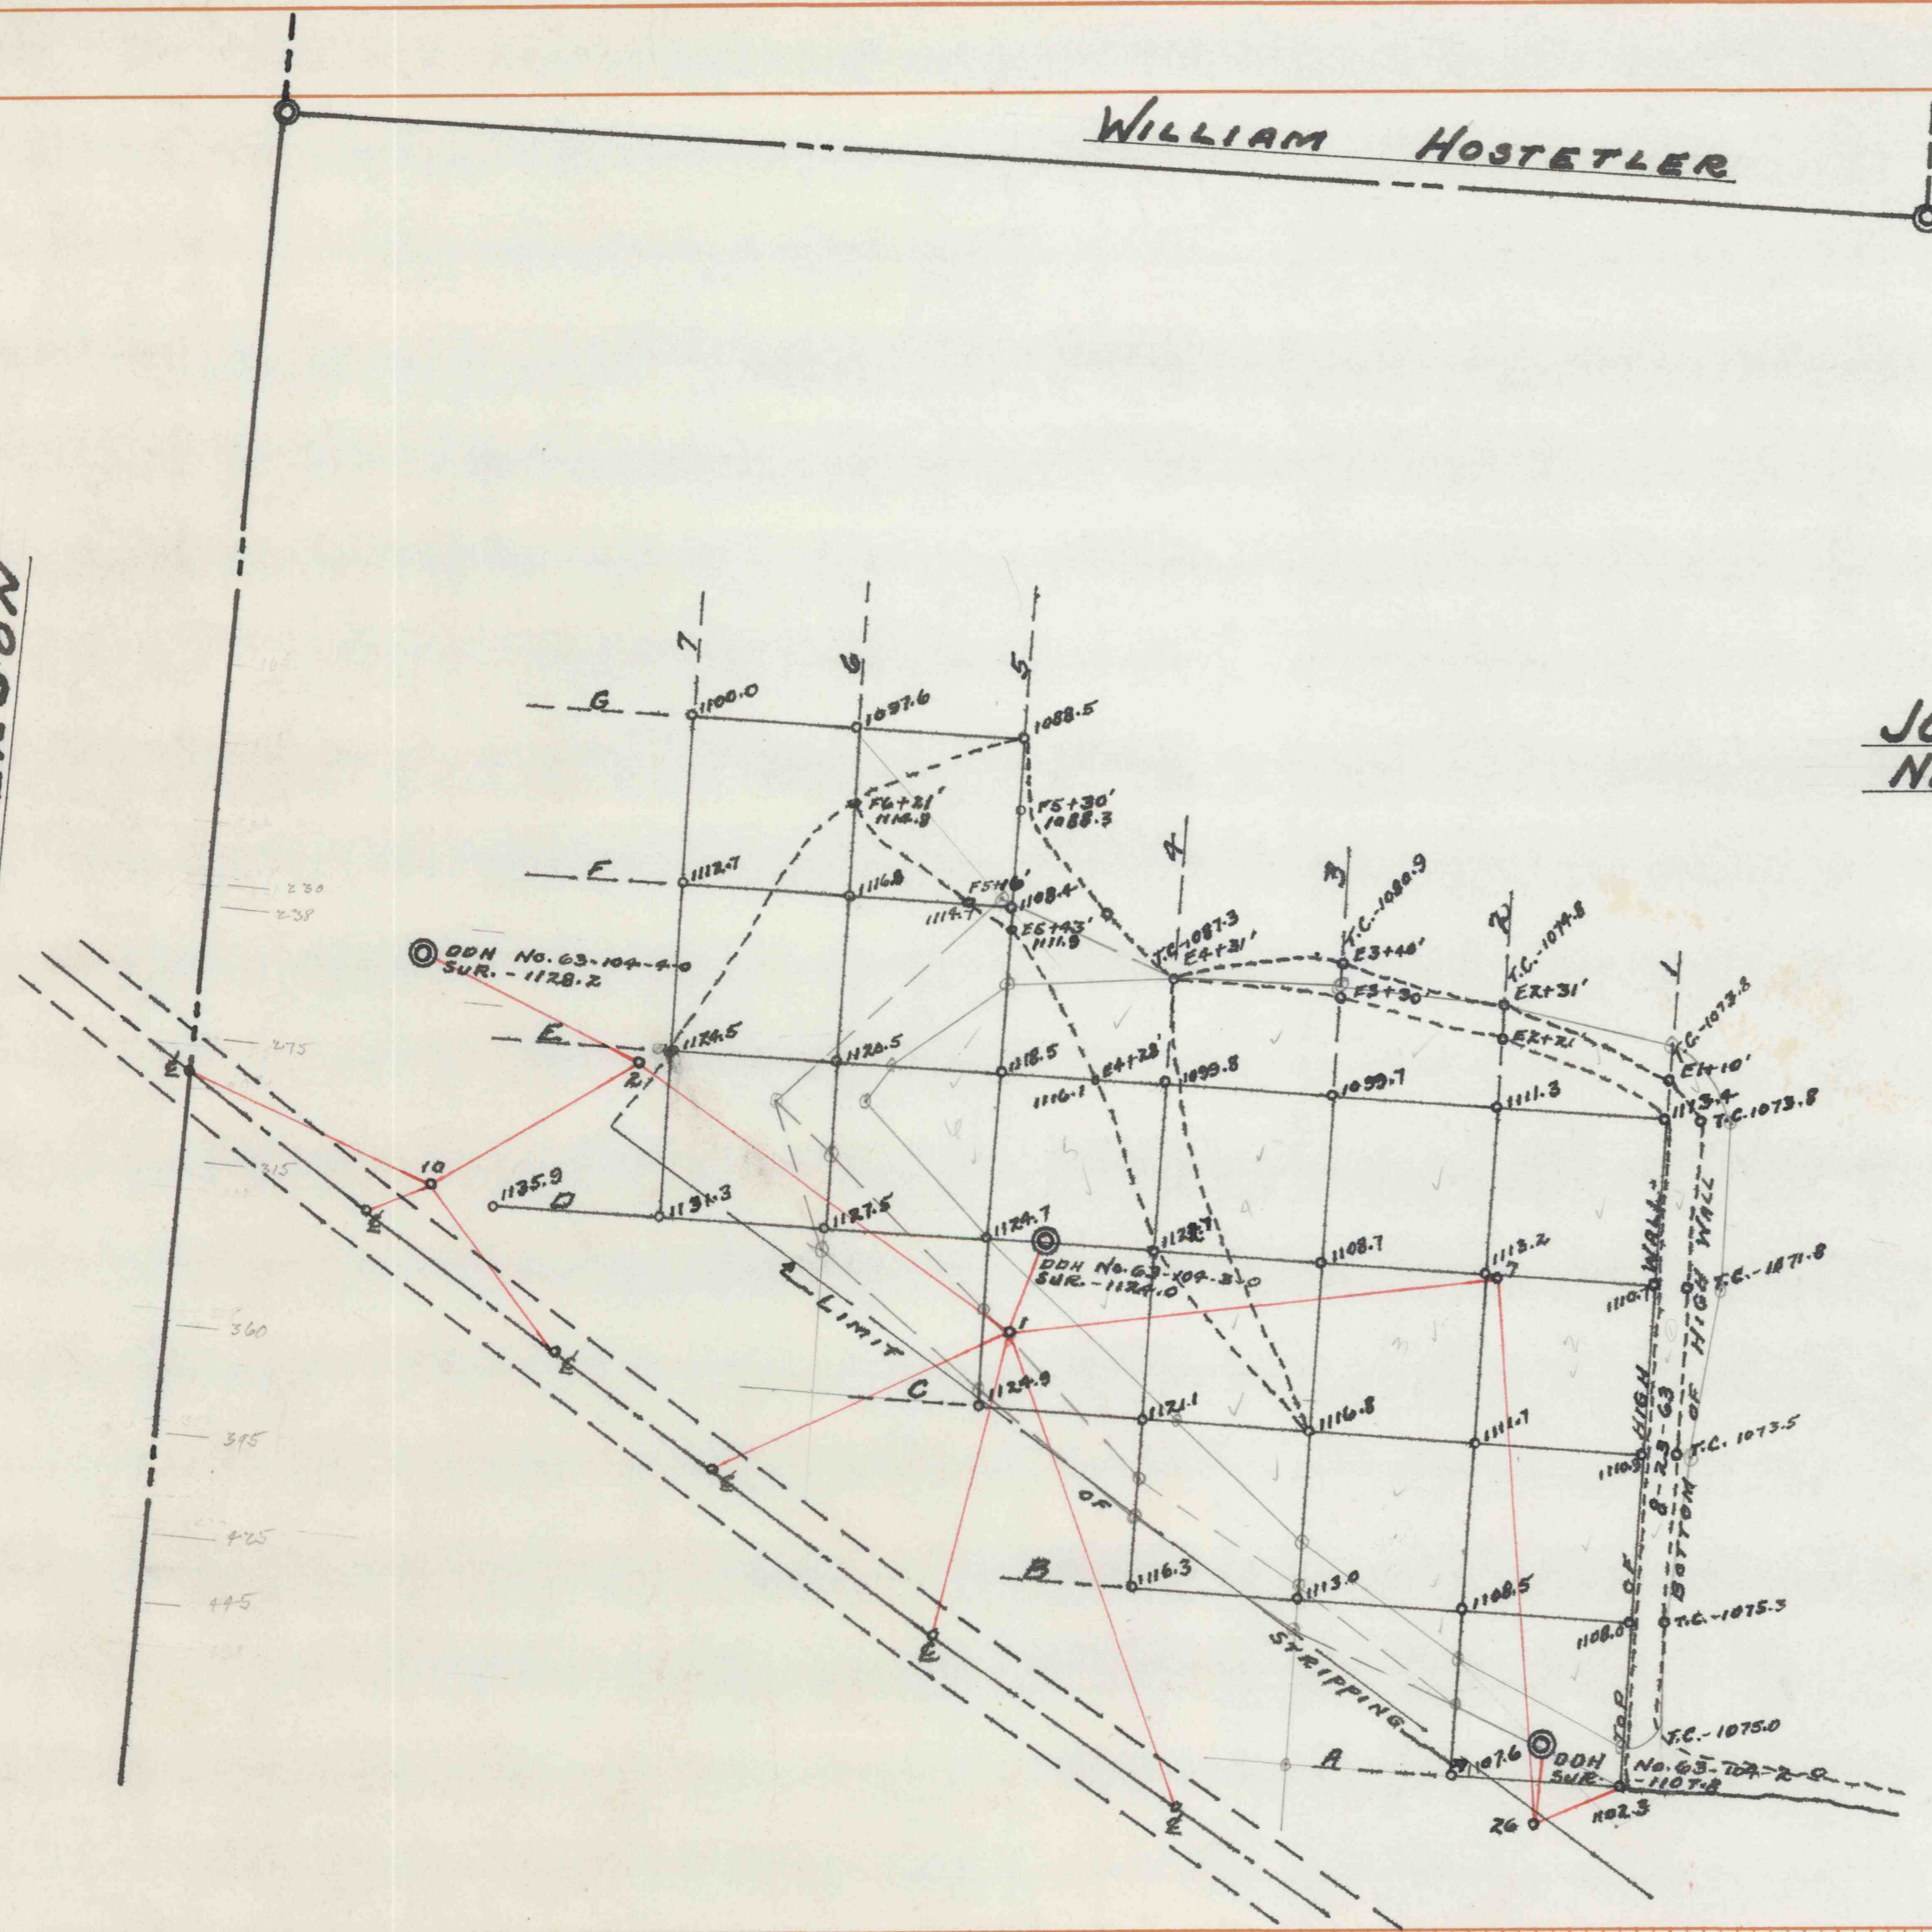

DATE	
BY	
FINAL SURVEY	
SURVEY PLOTTED	
NOTE BOOK	
AREAS CHECKED	

DATE	
BY	
ORIGINAL SURVEY	
SURVEY PLOTTED	
NOTE BOOK	
AREAS CHECKED	

