

BUMBARGER


CHARLES I WOLF

WILLIAM BANNER

JACOB PETERS

N

SCALE 1" = 100'

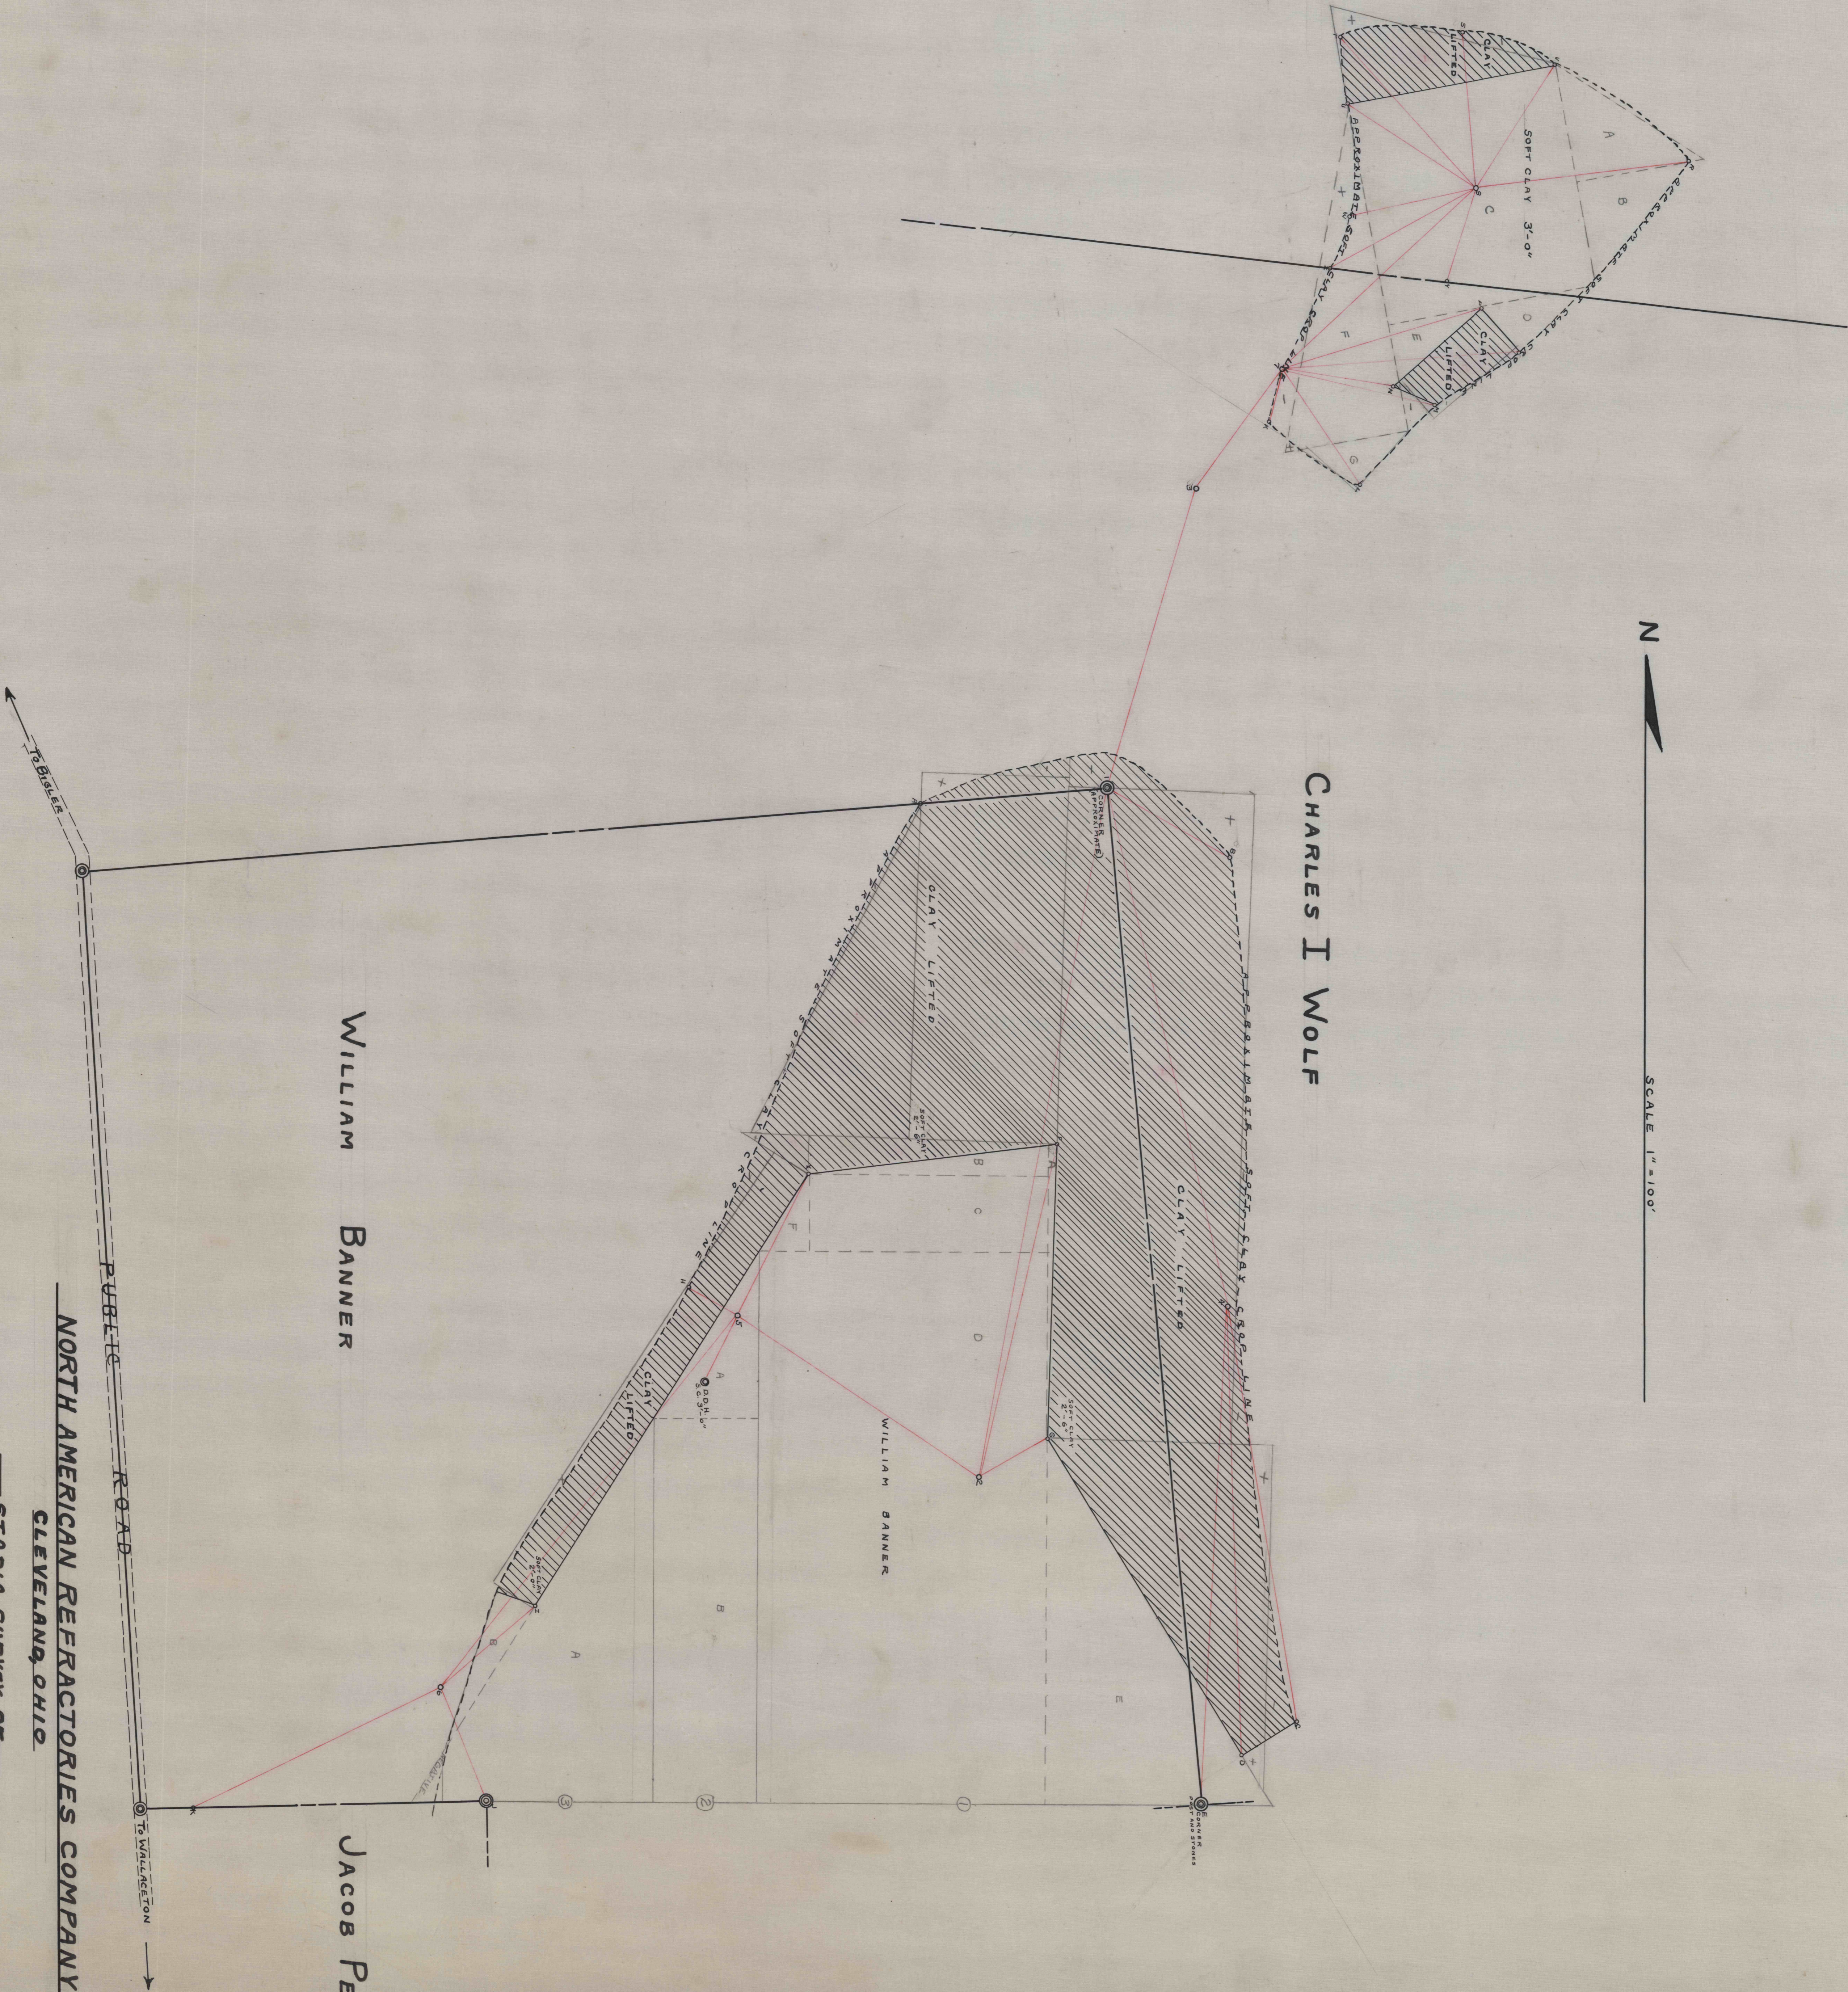

NORTH AMERICAN REFRATORIES COMPANY  
CLEVELAND, OHIO

STADIA SURVEY OF  
WENDELL TURNER STRIPPING

BOGGS TOWNSHIP AND WALLACE TON BOROUGH  
CLERKFIELD COUNTY, PA.

SCALE 1" = 100' SEPT 30, 1952 INDEX NO. - 50-3-1244

DRAWN OR TRACED OR APPROVED F.C.M.