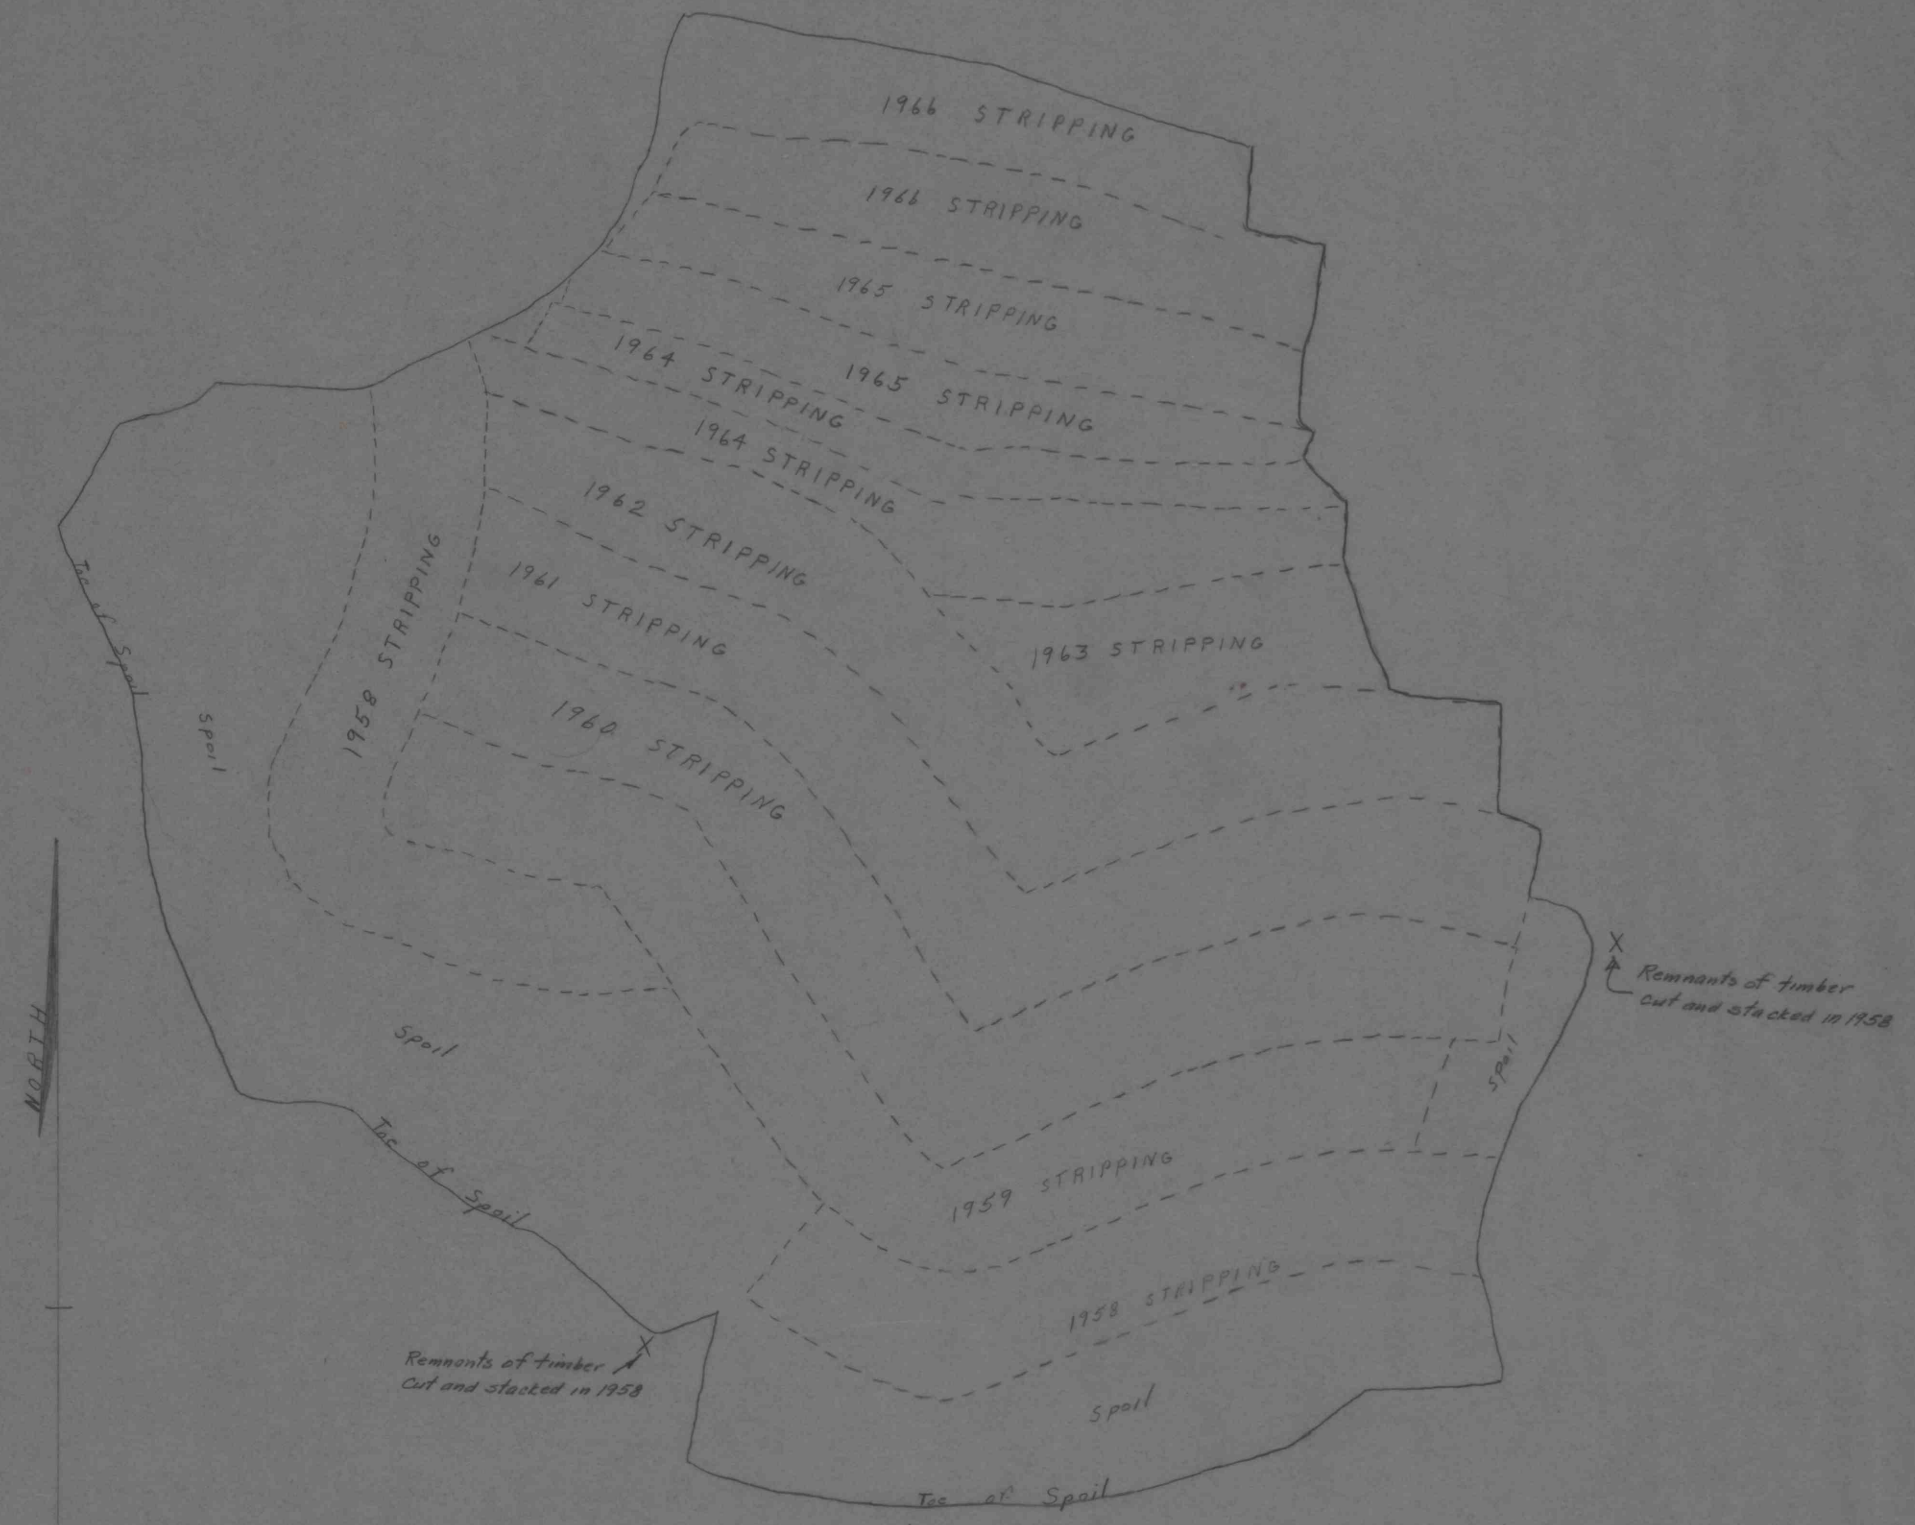

NORTH AMERICAN REFRACTORIES COMPANY

CLEVELAND 14, OHIO

MAP SHOWING

P+N CLAY STRIPPING

LOCATED NEAR

DENTS RUN, BENEZETTE TWP. ELK CO. PENNA.

SCALE 1" = 100'

DRAWN: E.R.S. 1-4-67 APPROVED: J.D.N.Jr. 1/5/67

Index No. 50-3-1614