


FINAL SURVEY	SURVEYED	DATE
NOTE BOOK	PLOTTED	BY
NO.	TEMPLATE	
	AREAS CHECKED	

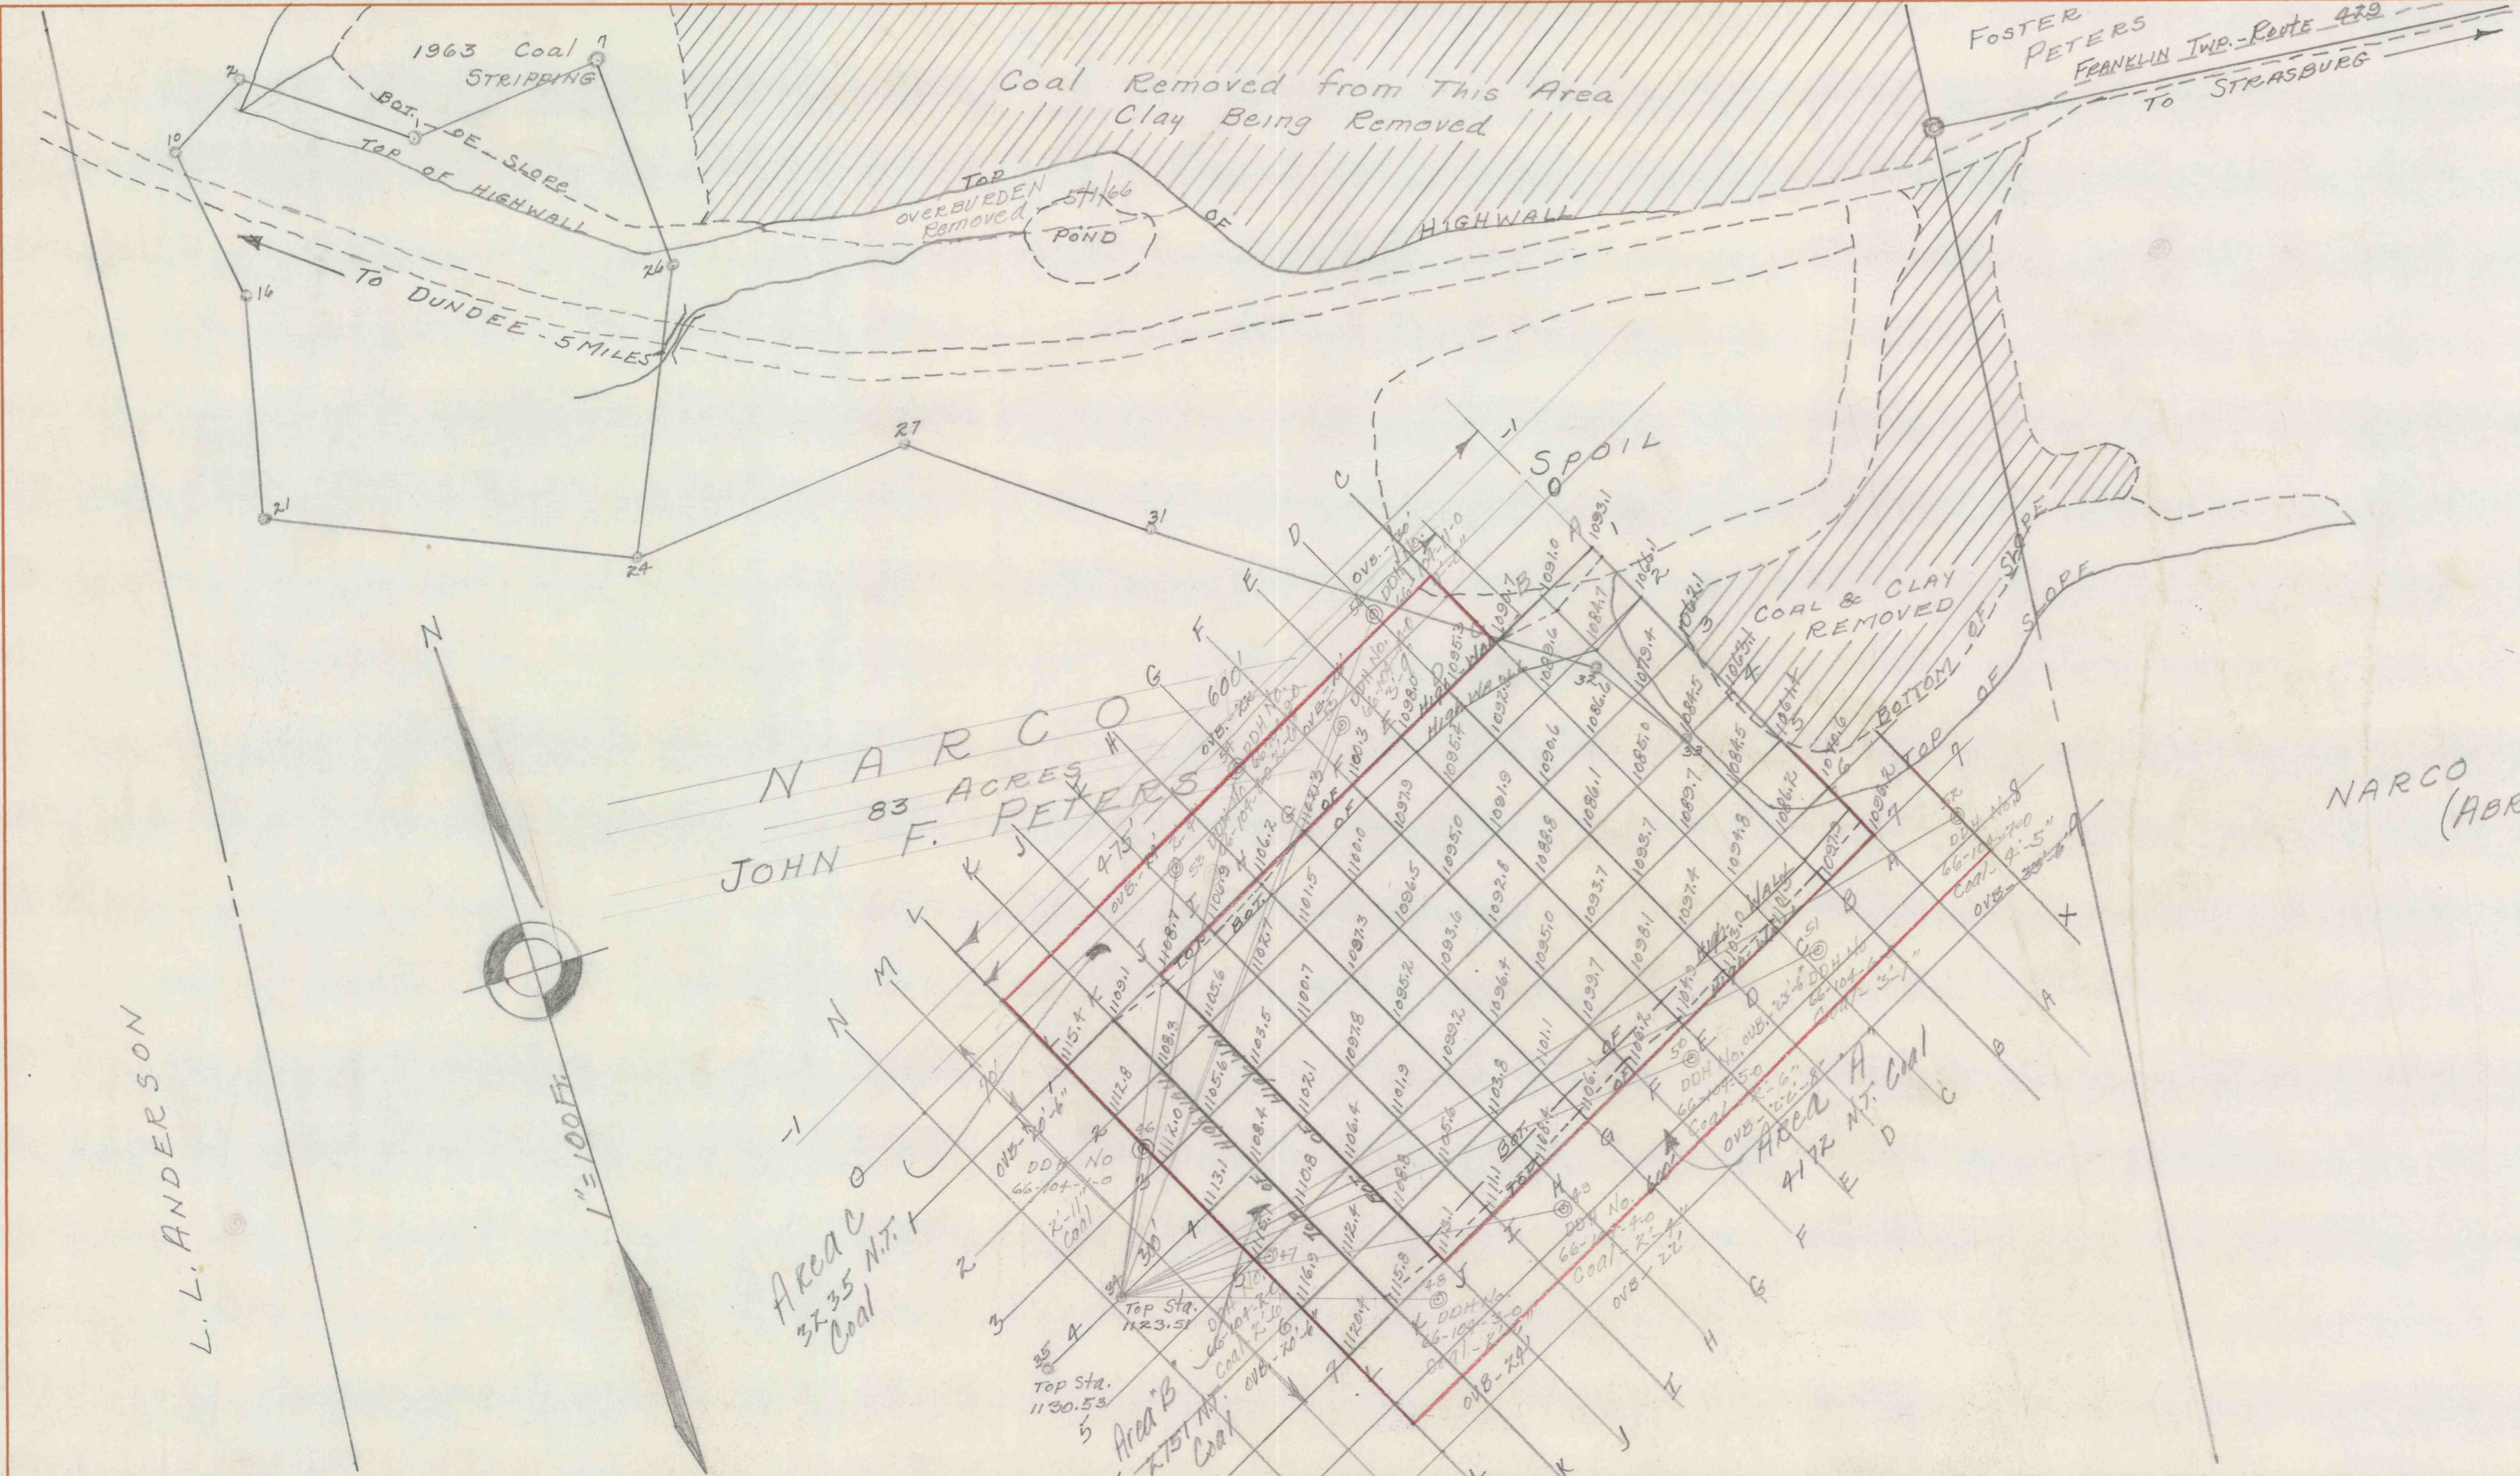

NARCO COAL & CLAY LEASE
(ABRAHAM GARBER)

NORTH AMERICAN REFRACTORIES CO.
CLEVELAND, OHIO

PLAN AND CROSS SECTIONS FOR 1964
COAL STRIPPING - PETERS 83 A. TRACT
FRANKLIN TOWNSHIP - TUSCARAWAS COUNTY - OHIO
SCALES: PLAN: 1" = 100 FT. - CROSS SECTIONS - HOR. - 1" = 20 FT. VER. - 1" = 10 FT.
DRAWN: J. R. H. Jr. SURVEYED: JUNE 17-18, 1964 JULY 1, 1964

INDEX No. 75-3-20A

ORIGINAL SURVEY	SURVEYED	DATE
NOTE BOOK	PLOTTED	BY
NO.	TEMPLATE	
	AREAS CHECKED	

