


SCALE 1"=20'




FINAL SURVEY SURVEYED, PLOTTED, AND CHECKED BY: DATE: NOTE BOOK NO. AREAS CHECKED.

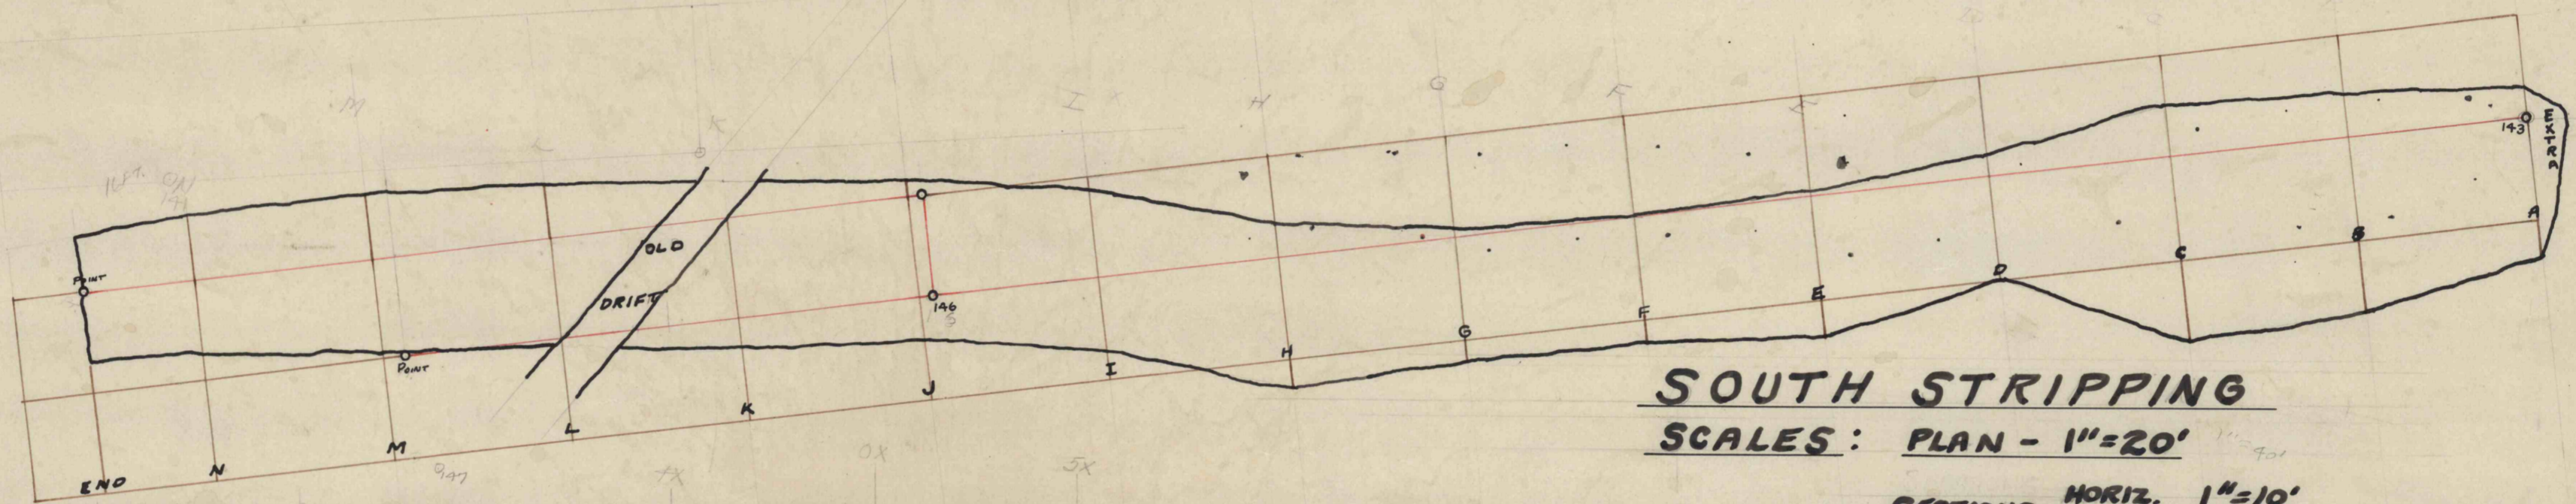

SOUTH STRIPPING
 SCALES: PLAN - 1"=20'

SECTIONS - HORIZ. 1"=10'
 VERT. 1"=10'

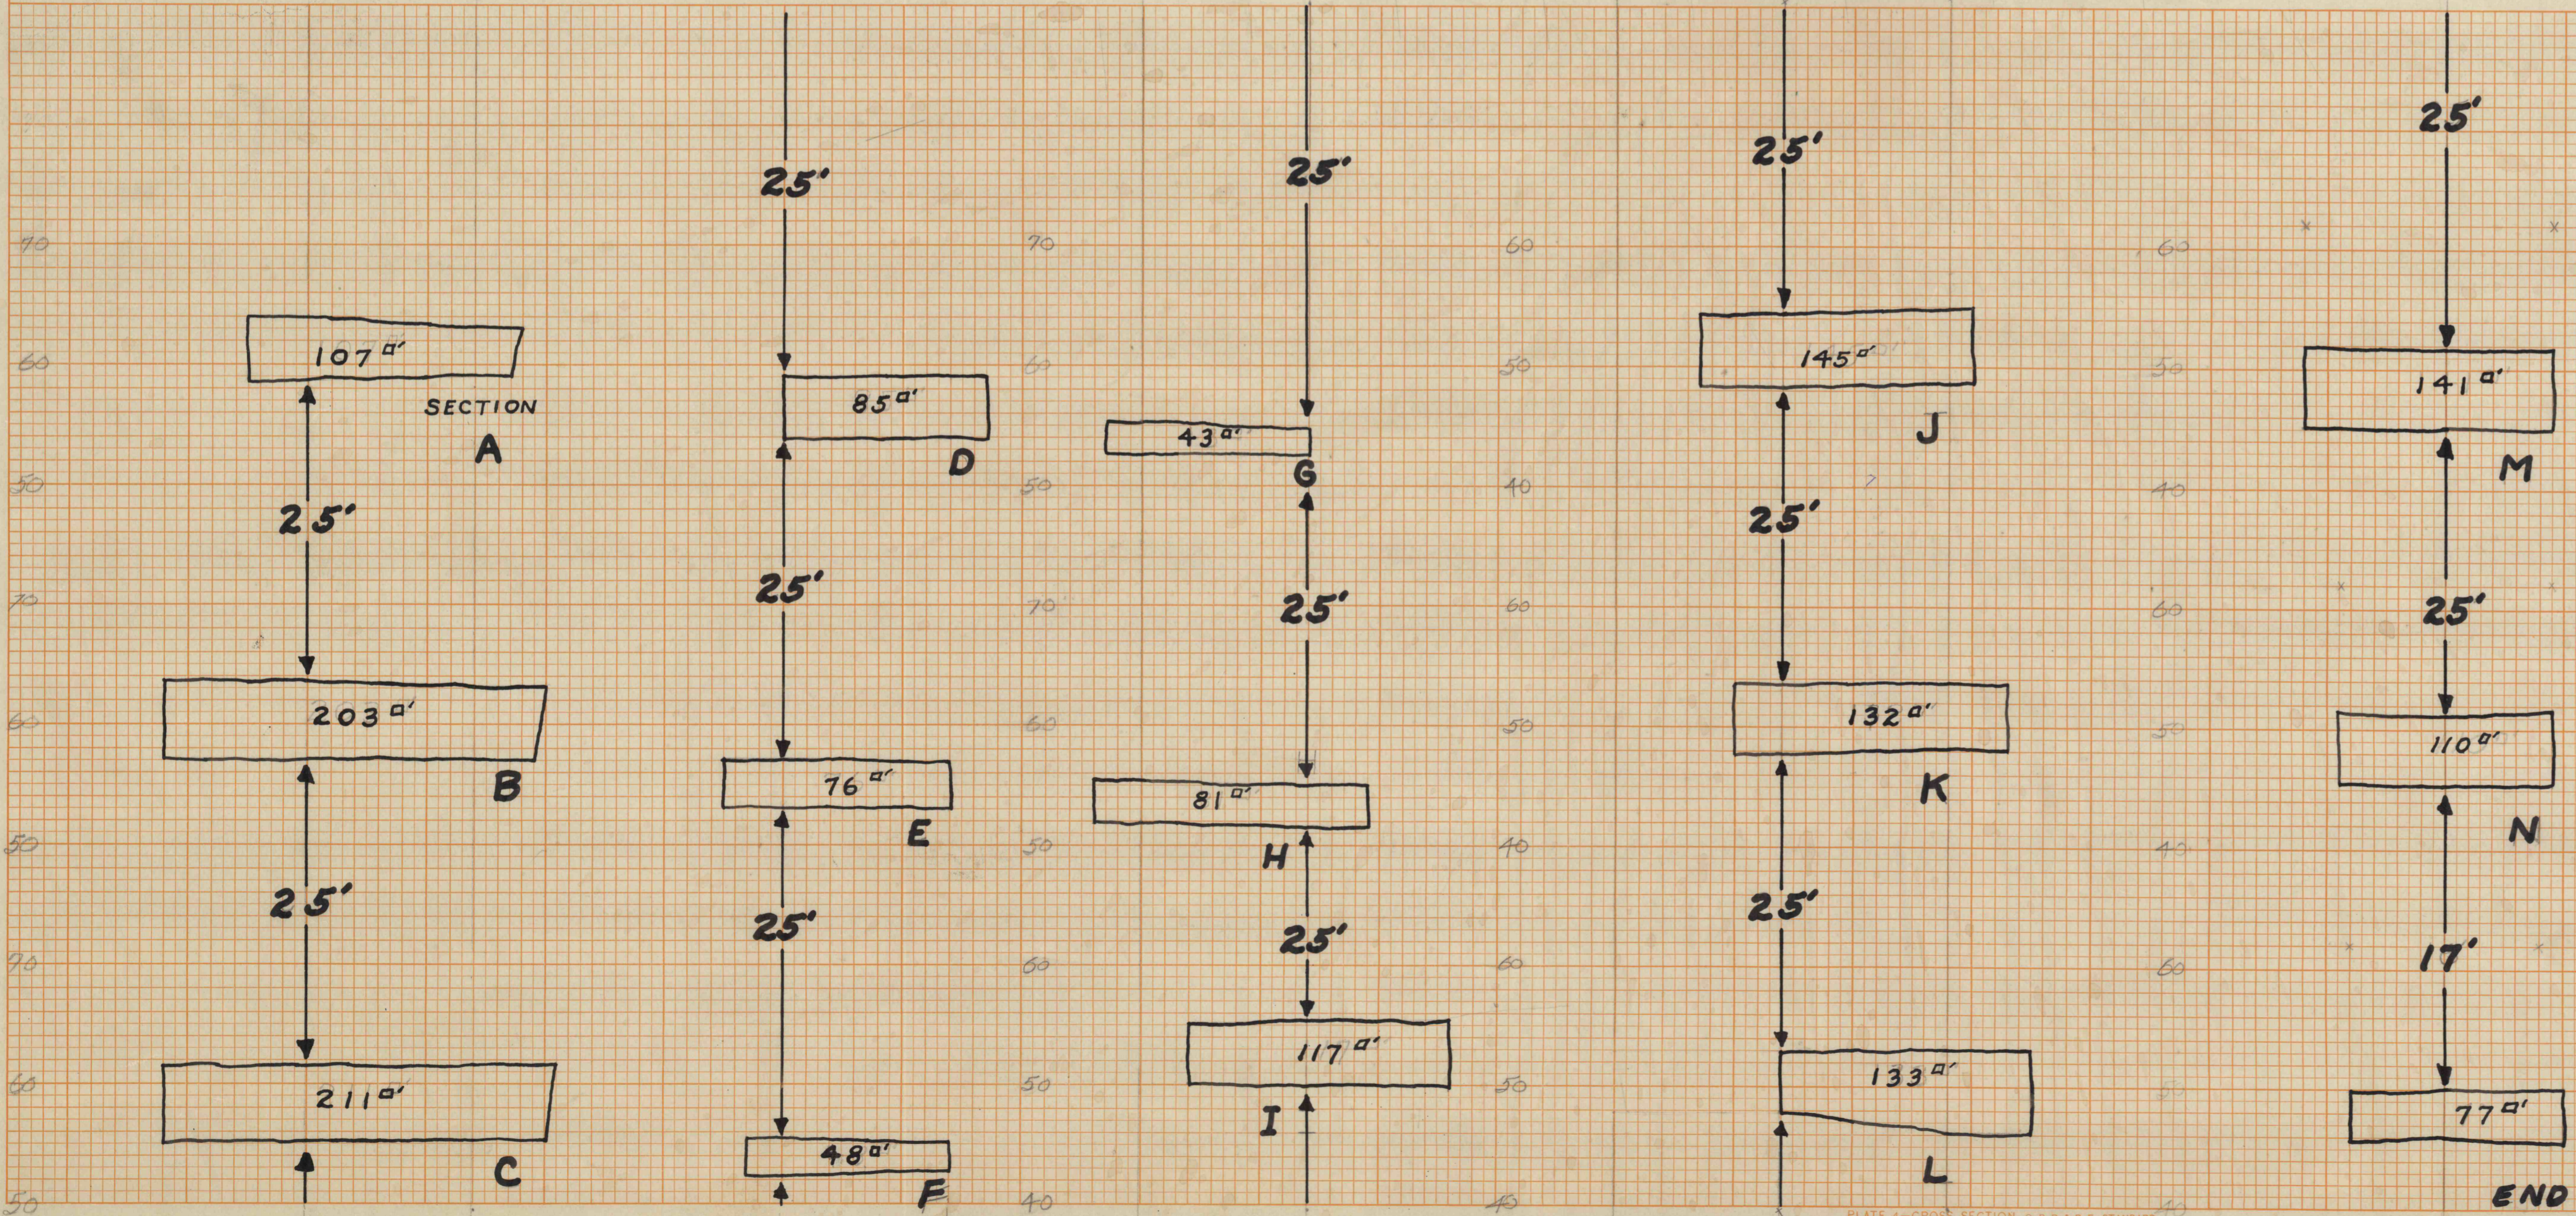

39,640 CU. FT. VOLUME SECTIONS A TO END INC.
 + 428 CU. FT. VOLUME - EXTRA - SECTION A x 4'
 40,068
 - 1,680 CU. FT. VOLUME - OLD DRIFT 5x10x20
 38,388 CU. FT. X 155#/CU. FT. (SPECIFIC GRAVITY OF THIS CLAY) = 2,975 NET TONS

ORIGINAL SURVEY SURVEYED, PLOTTED, AND CHECKED BY: DATE: NOTE BOOK NO. AREAS CHECKED.