



21-5-50  
21-5-50

FINAL SURVEY	SURVEYED	DATE
NOTE BOOK	PLOTTED	BY
AREAS CHECKED	TEMPERATURE	
NO.	AREAS CHECKED	

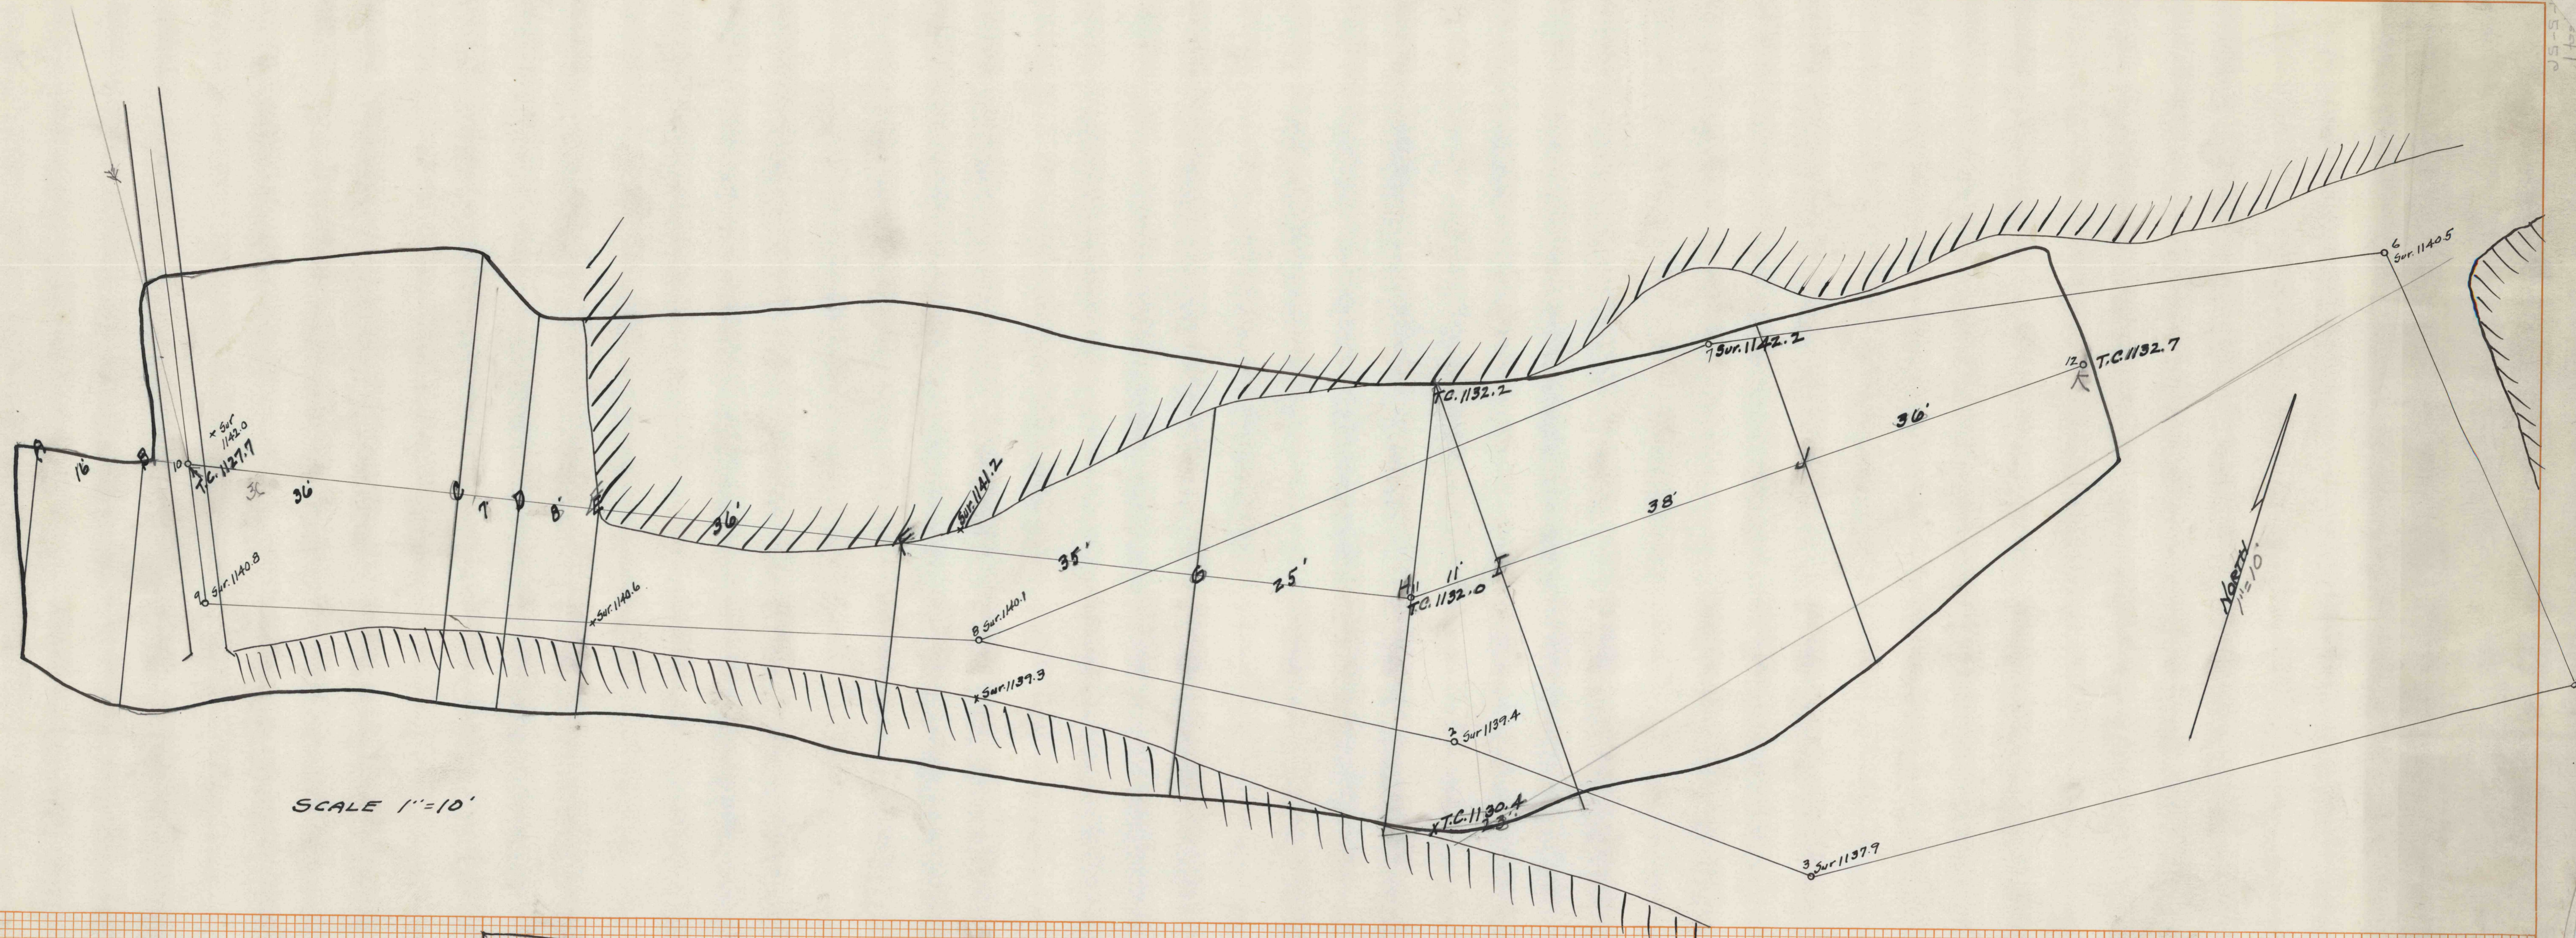

SCALE 1"=10'

ORIGINAL SURVEY	SURVEYED	DATE
NOTE BOOK	PLOTTED	BY
AREAS CHECKED	TEMPERATURE	
NO.	AREAS CHECKED	

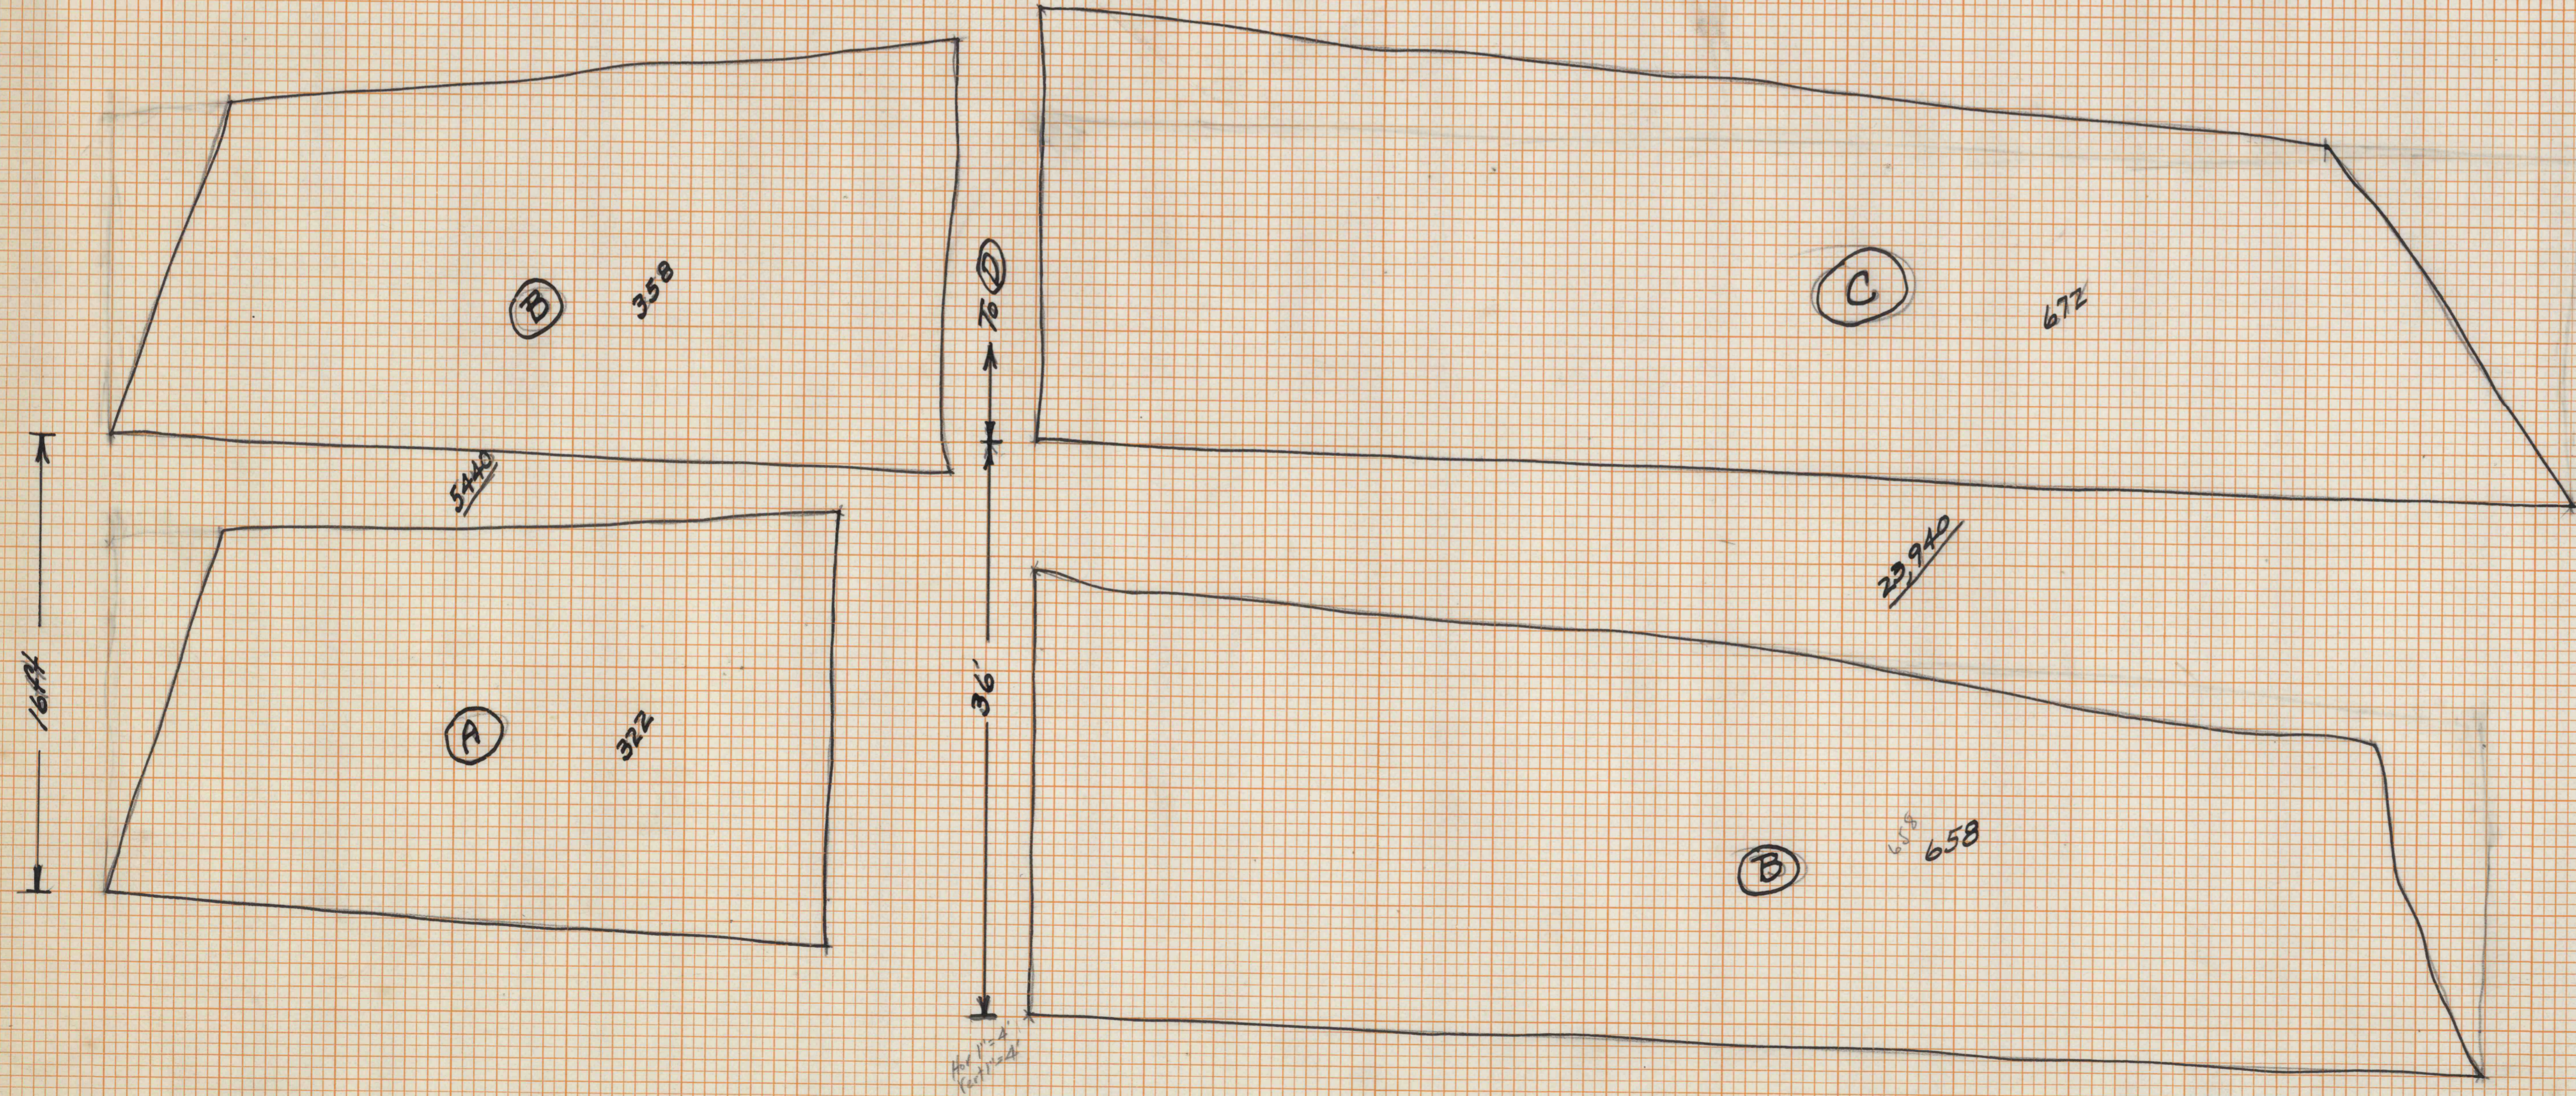

North American Refractories Co.  
**DRUCKER**  
**1941 STRIPPING**  
 SCALE { Plan 1"=10'  
 X Section (Hor. 1"=4'  
 Vert. 1"=4'

*J. P. H.*

21-5-50  
21-5-50

Sheet #1