

MOUNTAIN

SOUTH

WOMELSDORF WATER CO.

N.A.R.CO.

17A 109 P.


THOMAS W. REID

L. R. VALENTINE
AND
J. H. MAYS

NOTE: NO IDENTIFICATION
OF THESE CORNERS.

NEWMANTOWN WATER CO.

D.D.M. 53-123-1
El. Sur. 1003.95
D.D.H. 53-123-2
El. Sur. 1004.11

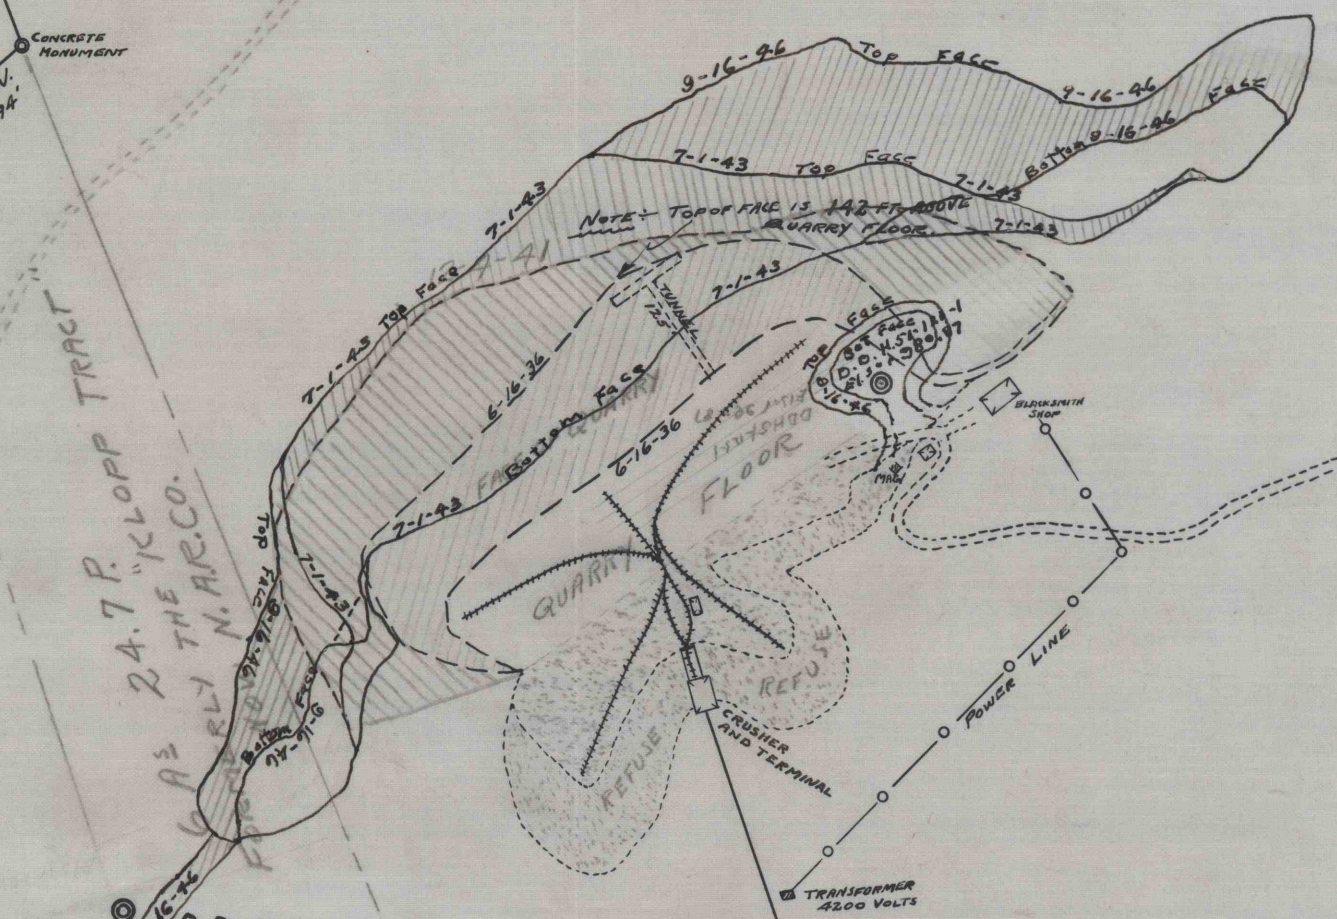


Proposed Powder Magazine
11' x 9'

N.A.R.CO.

124 A^s 18.71 P.

JACOB J. POFFENBERGER

C. K. MATTHEW

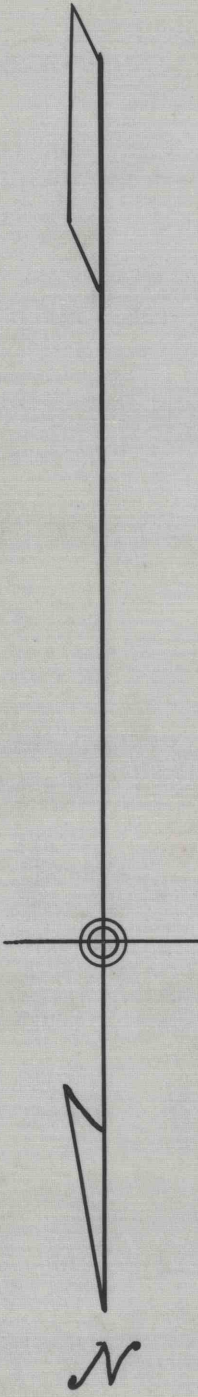

NOTE -
PROPERTY LINES OF 124 ACRE TRACT WERE
BLAZED AND PAINTED RED JULY 1, 1936.
J.P.H.

N.A.R.CO.
25A 6095 P.

VALLEY

LEBANON

NORTH AMERICAN REFRACTORIES CO.
CLEVELAND, OHIO.

MAP OF LANDS
OF
NORTH AMERICAN REF. CO.
AT THE 'WOMELSDORF PLANT'
MILL CREEK TWP. - LEBANON CO. PA.

SURVEYED - JUNE 1936. J.P.H.
MAPPED - JUNE 25, 1936. J.P.H.
SCALE: 1" = 200 FT.
INDEX - 18-3-2-50