
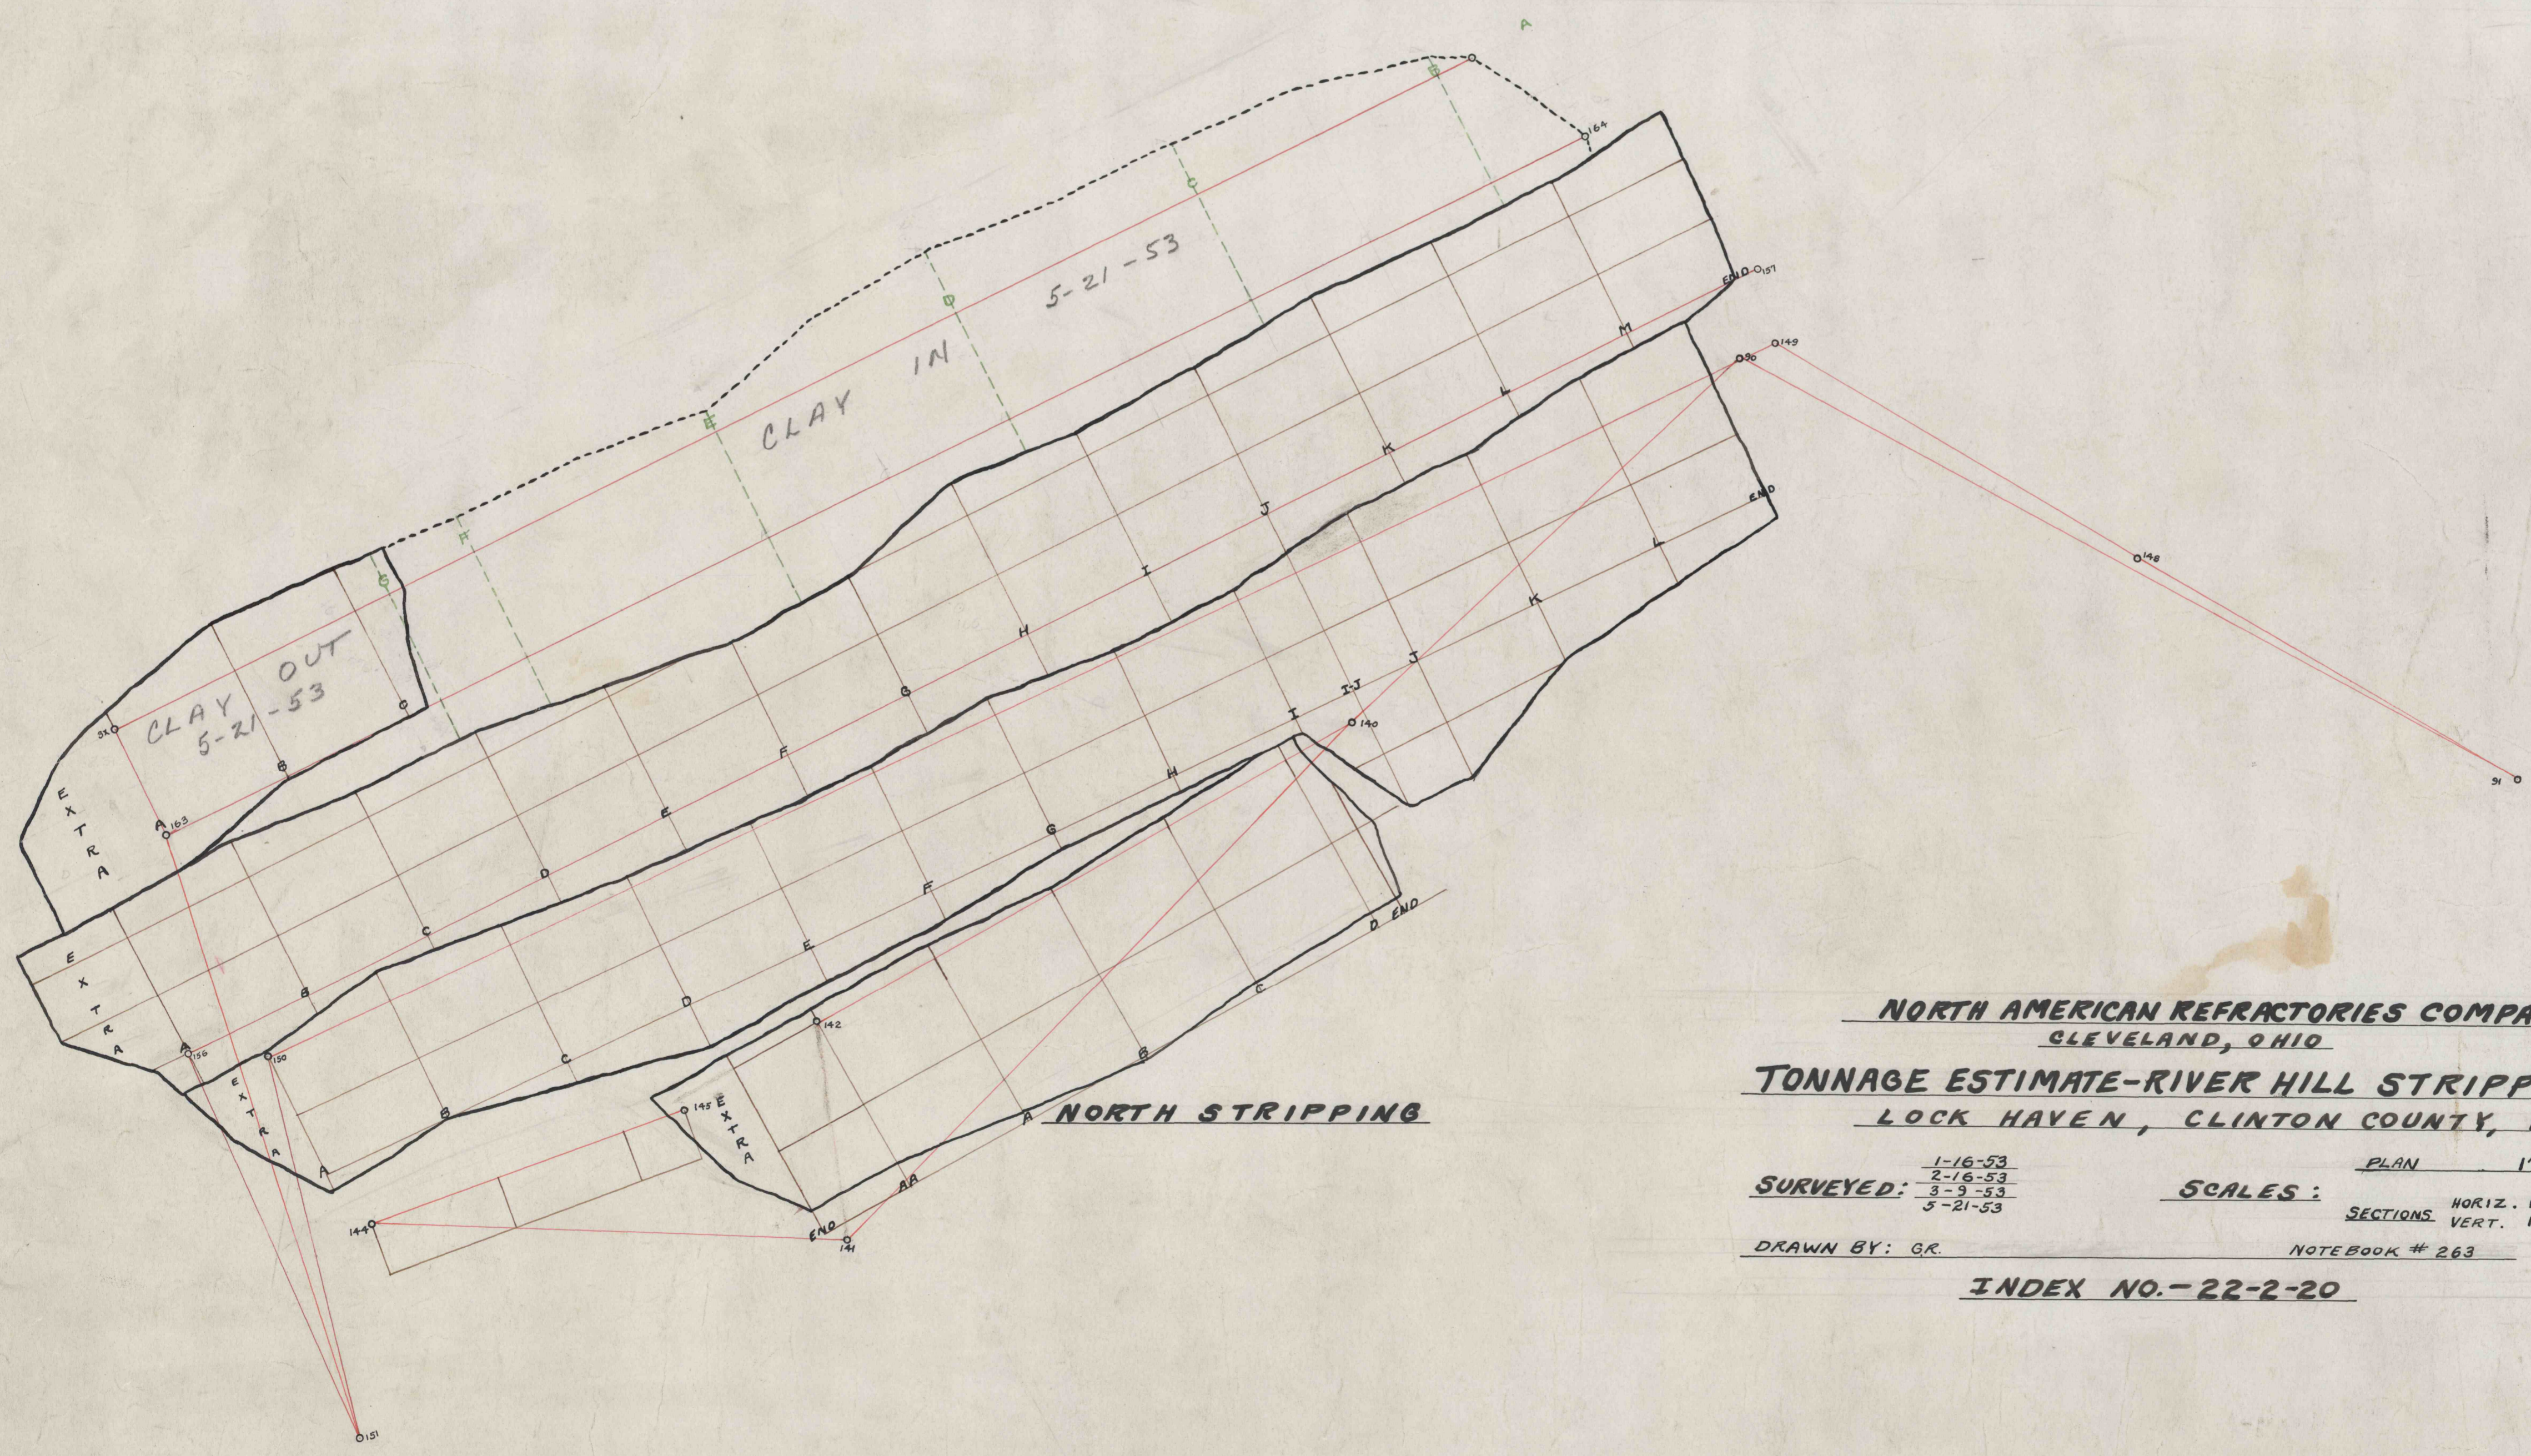


SCALE 1"=20'

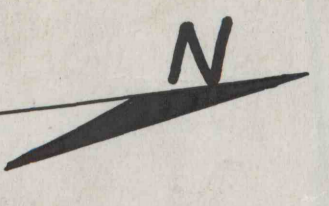

NORTH AMERICAN REFRACTORIES COMPANY
CLEVELAND, OHIO
TONNAGE ESTIMATE-RIVER HILL STRIPPING
LOCK HAVEN, CLINTON COUNTY, PA.

SURVEYED: 1-16-53
 2-16-53
 3-9-53
 5-21-53

SCALES: PLAN 1"=20'
 SECTIONS HORIZ. 1"=10'
 VERT. 1"=10'

DRAWN BY: G.R. **NOTEBOOK #** 263

INDEX NO.-22-2-20