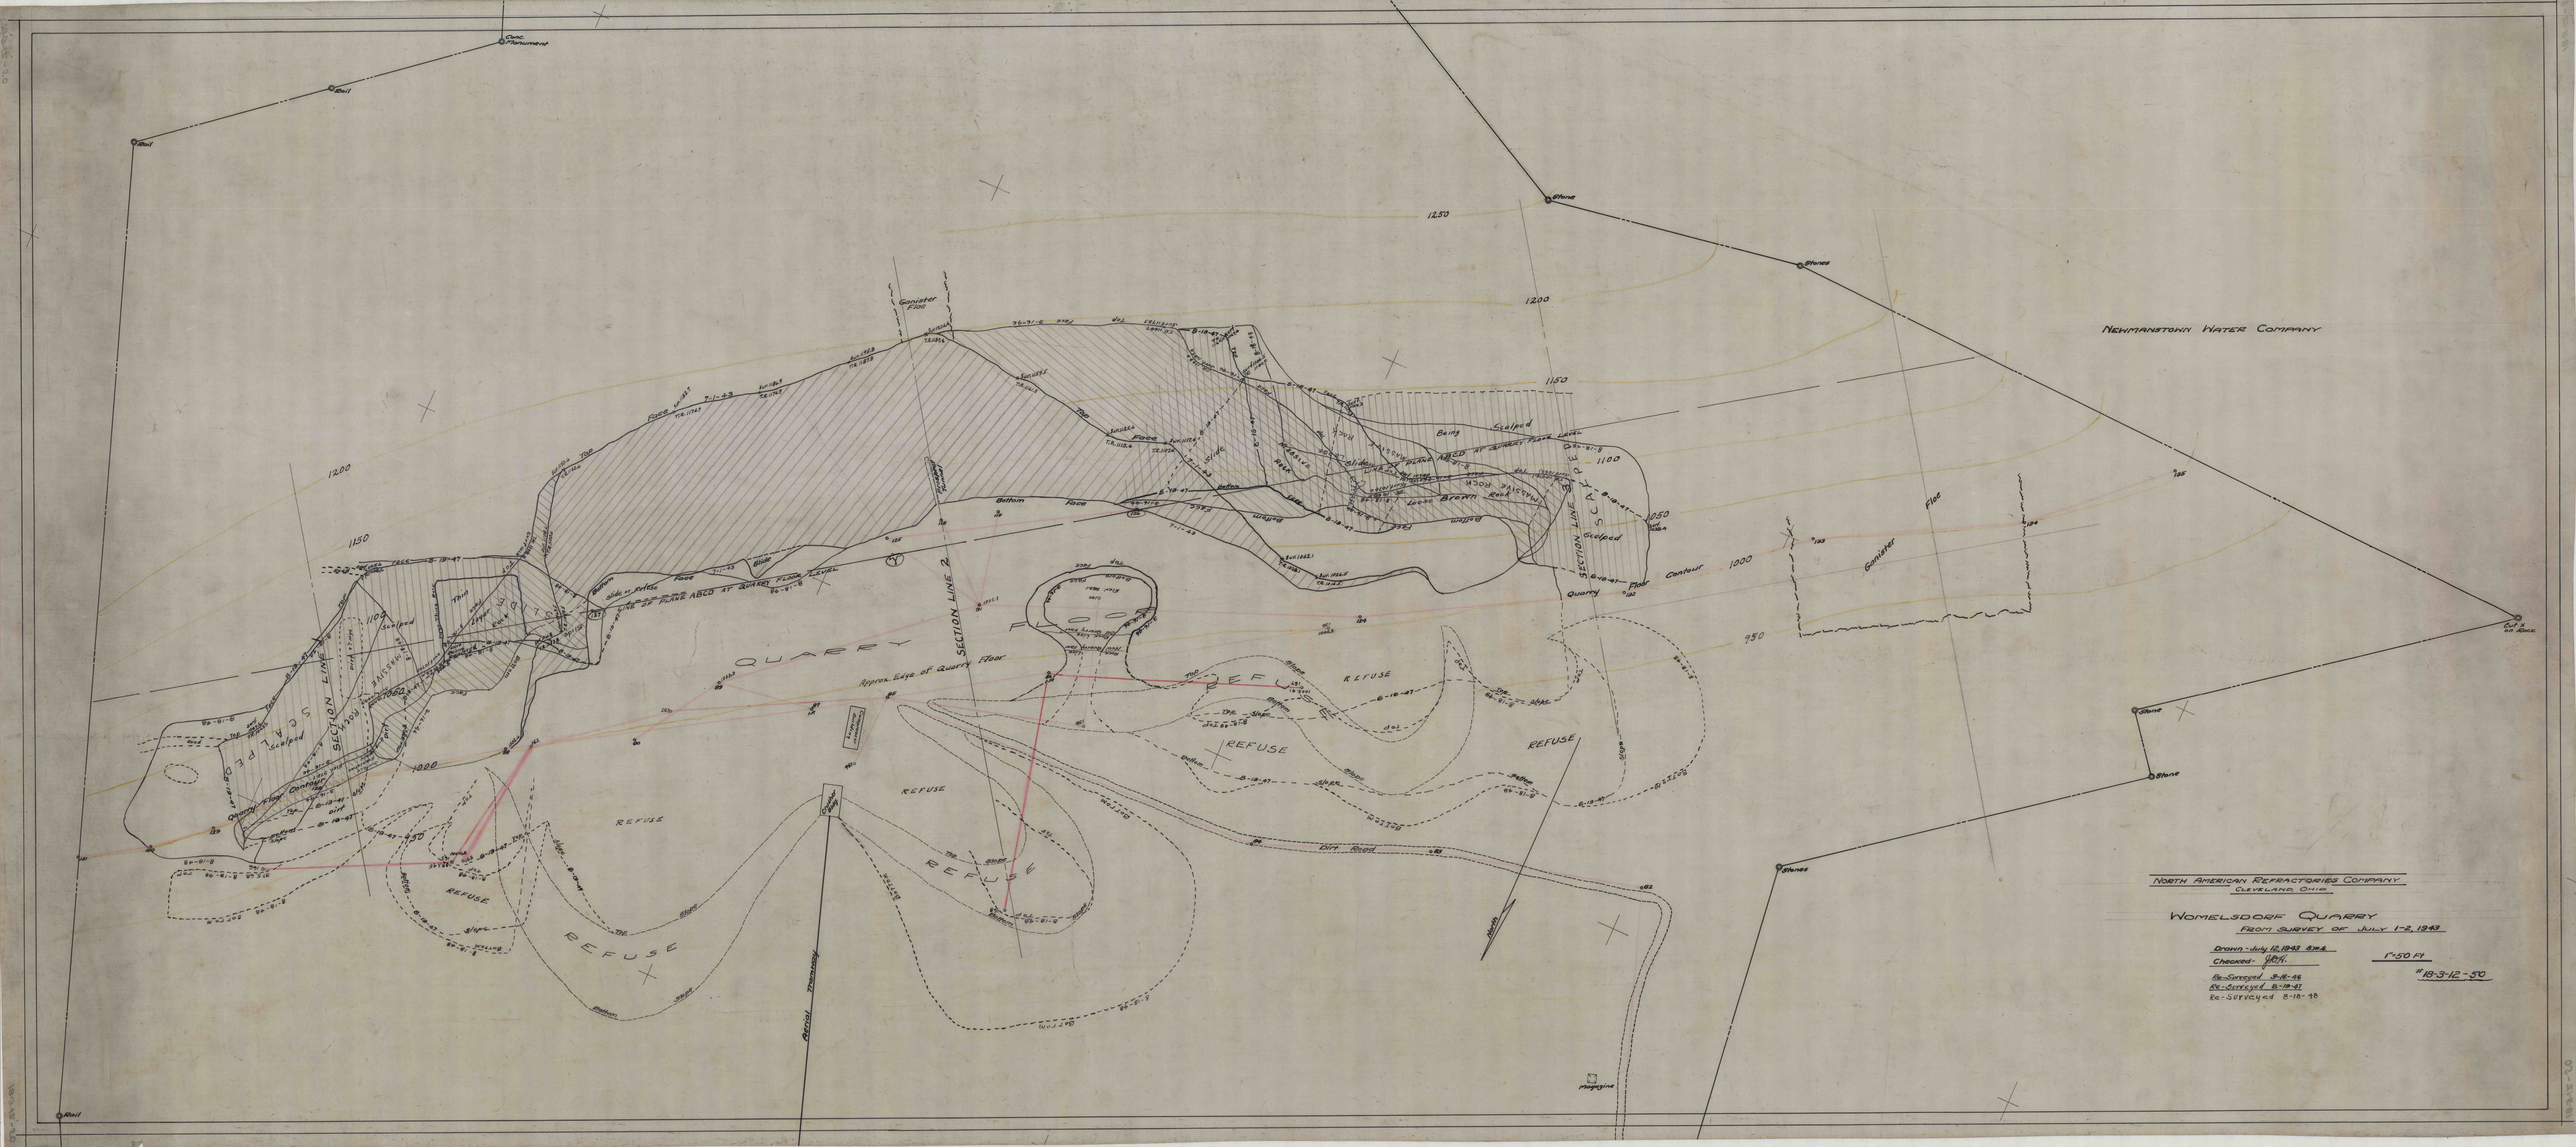

NORTH AMERICAN REFRACTORIES COMPANY
CLEVELAND, OHIO

WOMELSDORF QUARRY

FROM SURVEY OF JULY 1-2, 1943

Drawn - July 12, 1943 B.M.A.
Checked - J.B.M.
Re-Surveyed 8-16-46
Re-Surveyed 8-19-47
Re-Surveyed 8-18-48

1"=50 Ft.

#18-3-12-50