

BICKFORD FIRE BRICK COMPANY

CURWENVILLE, CLEARFIELD COUNTY, PA.
ENGINEERING DEPARTMENT

No. 2 STRIPPING - HARD CLAY
IRVIN & MURRAY TRACT


ENV. No. L1

SHEET No. 66

50-3-204

SCALE 1" = 60 Ft.

DATE 5-2-1916.

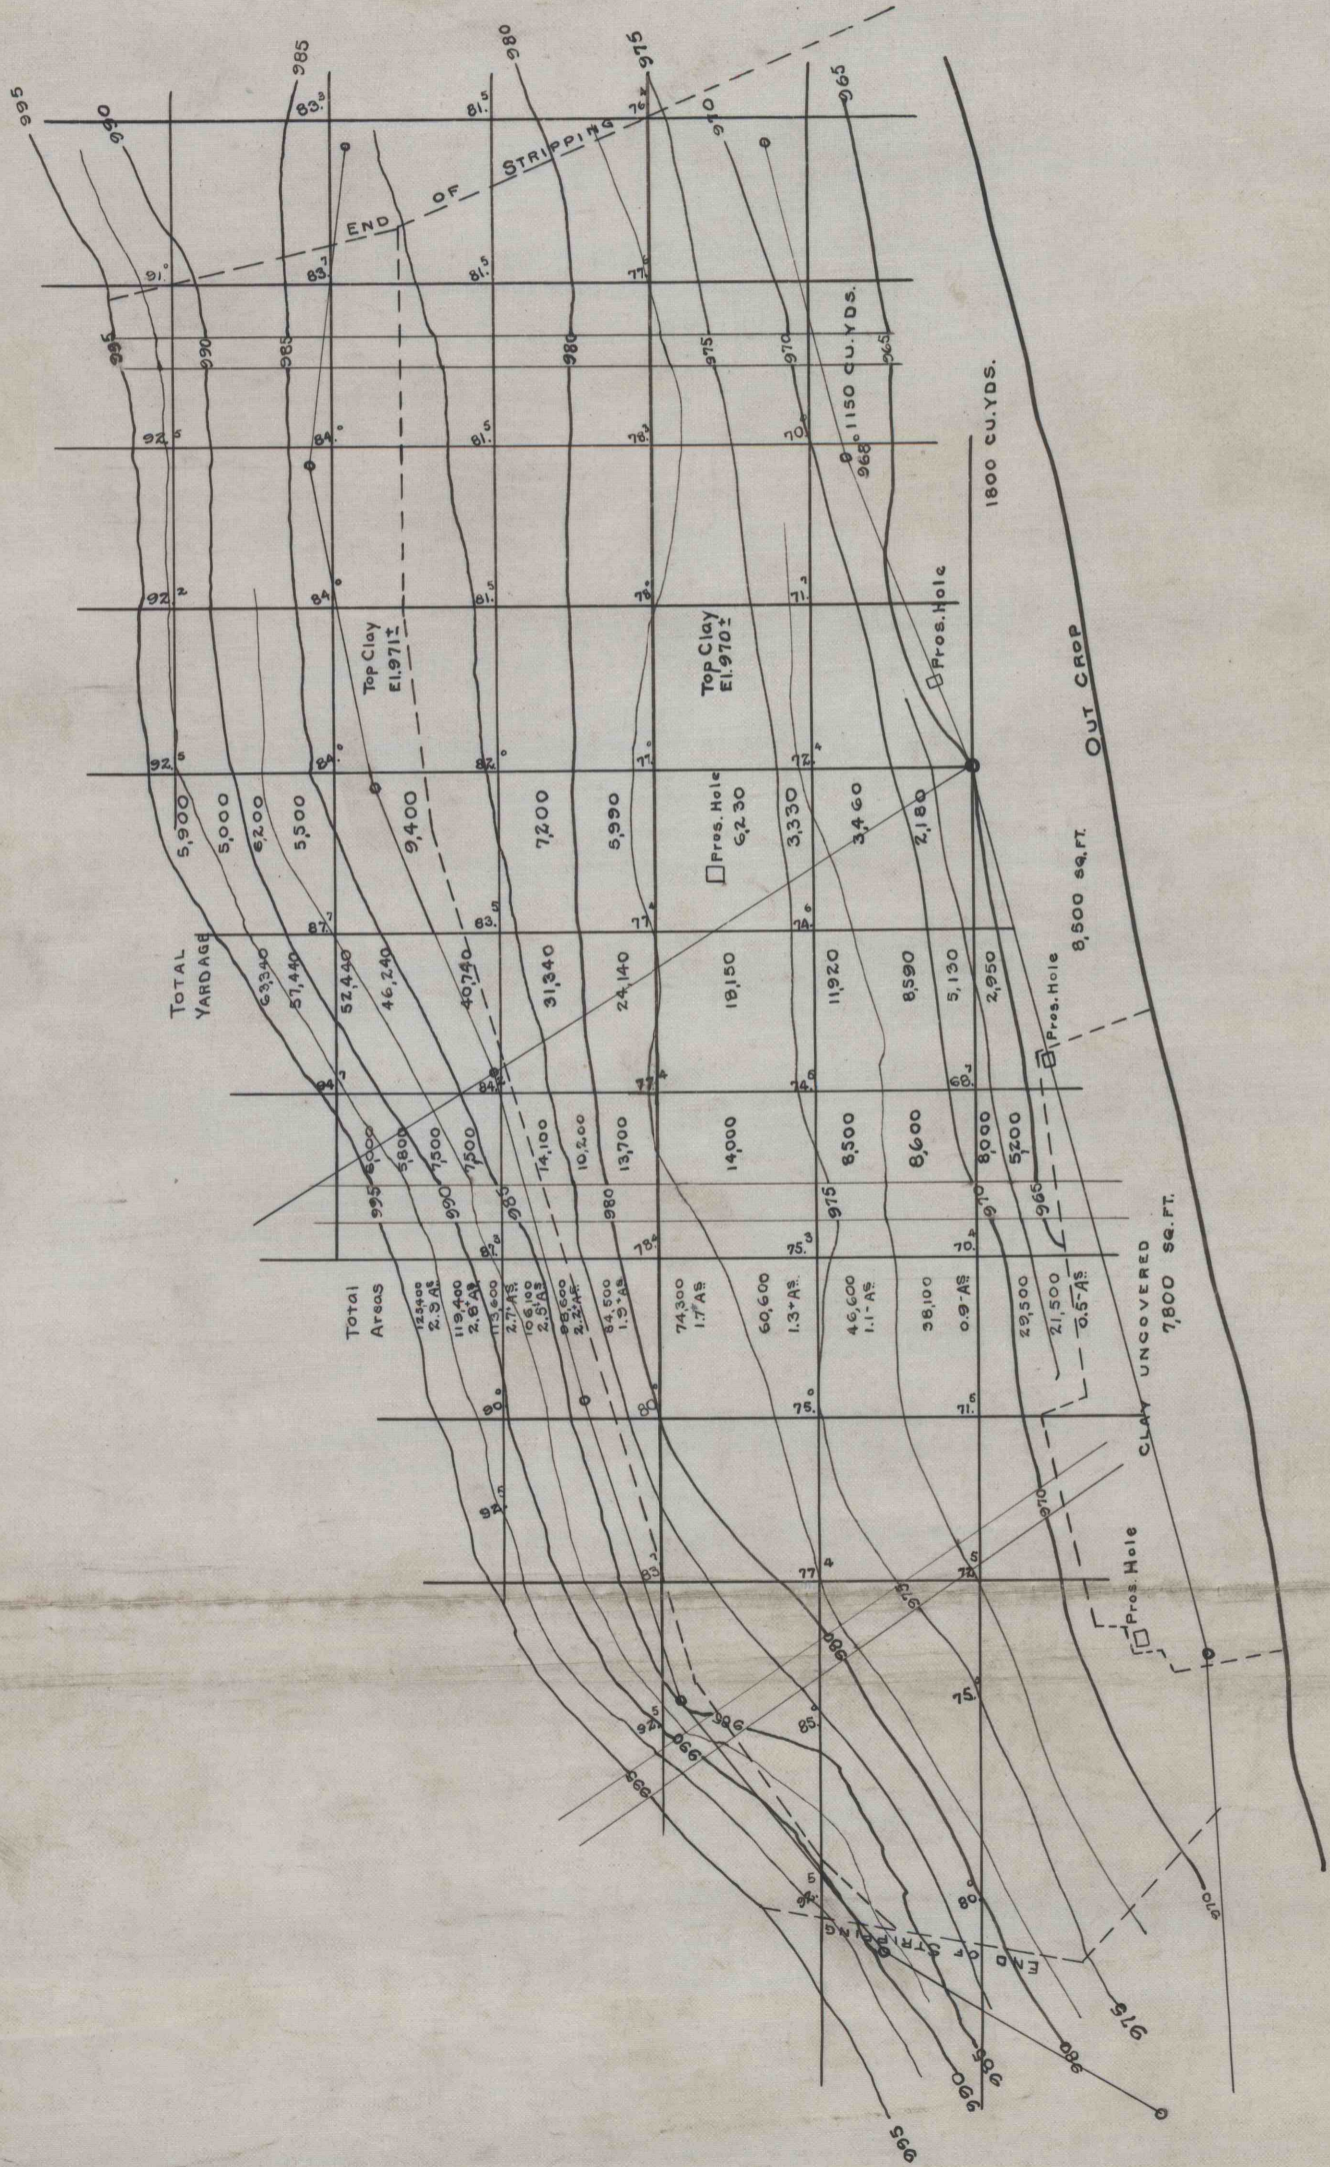

WORKED FROM - HESS - 4-28-1916.

DRAWN BY L.H.F.

CHECKED BY