


E. C. F. A.
B. S. 2000

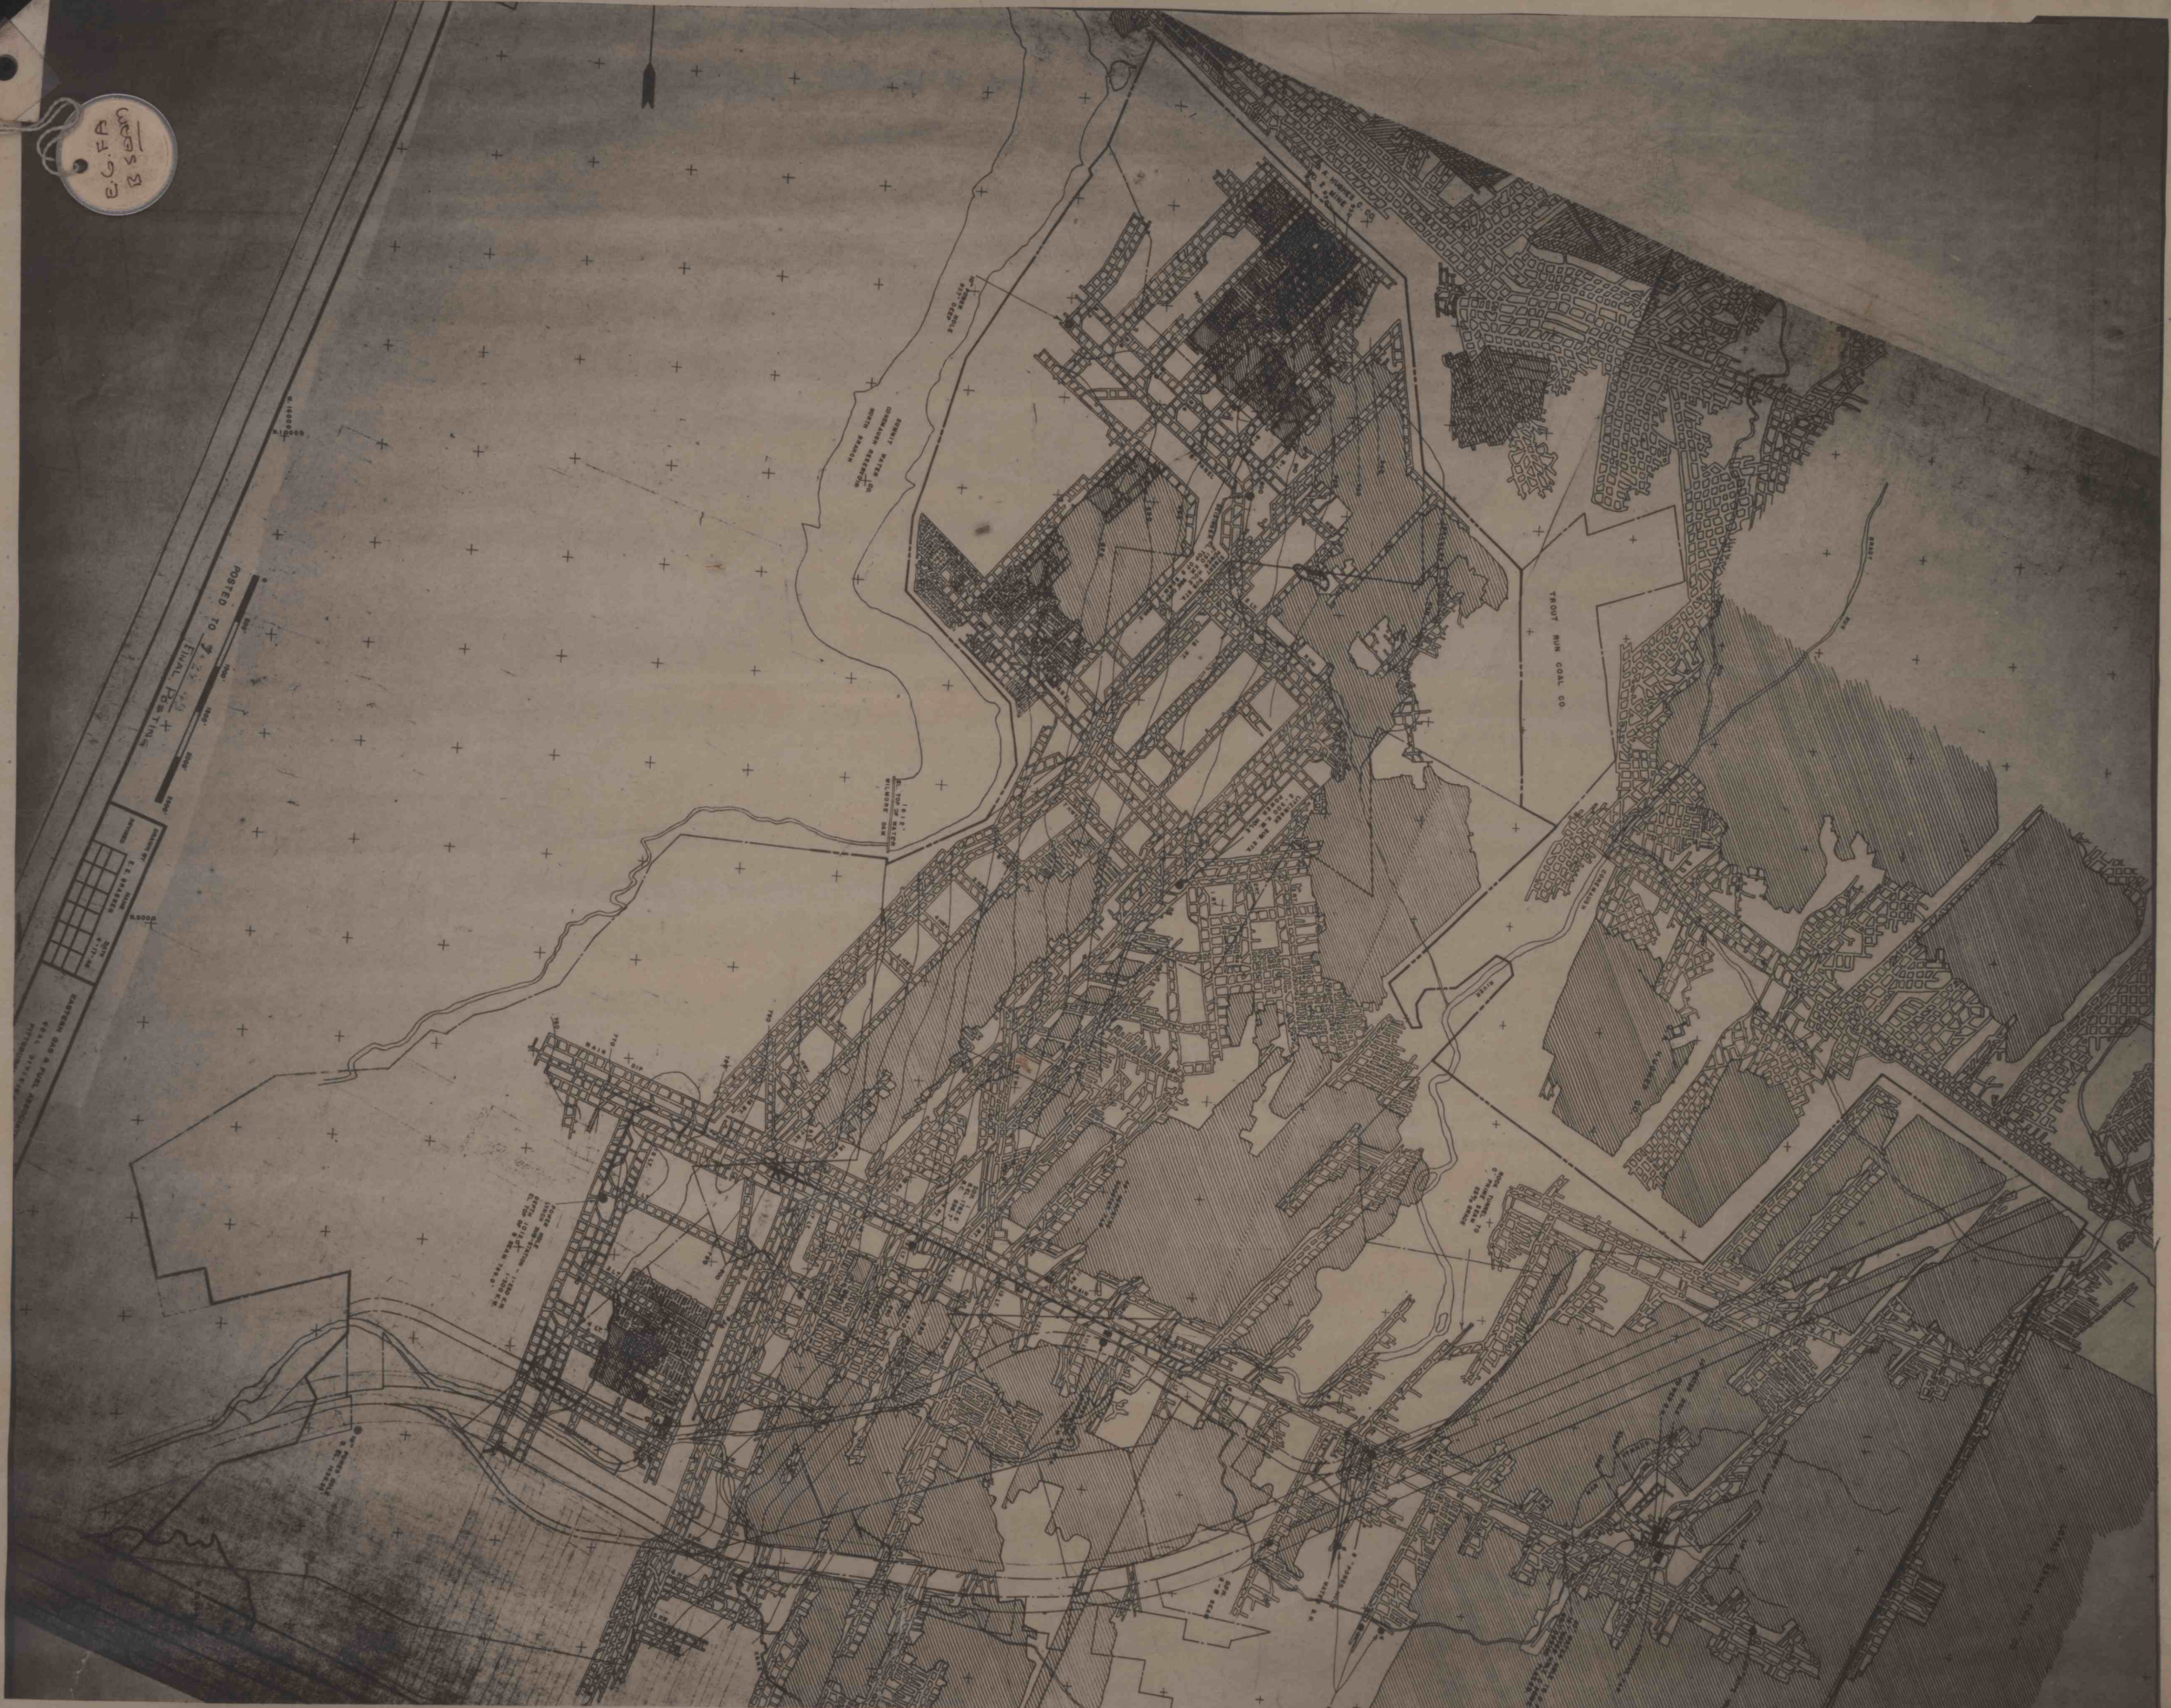

POSTED TO
FINAL POSITIONS

MINING
CONVEYANCE
RESERVE


LOT OF
STREET

LOT OF
STREET