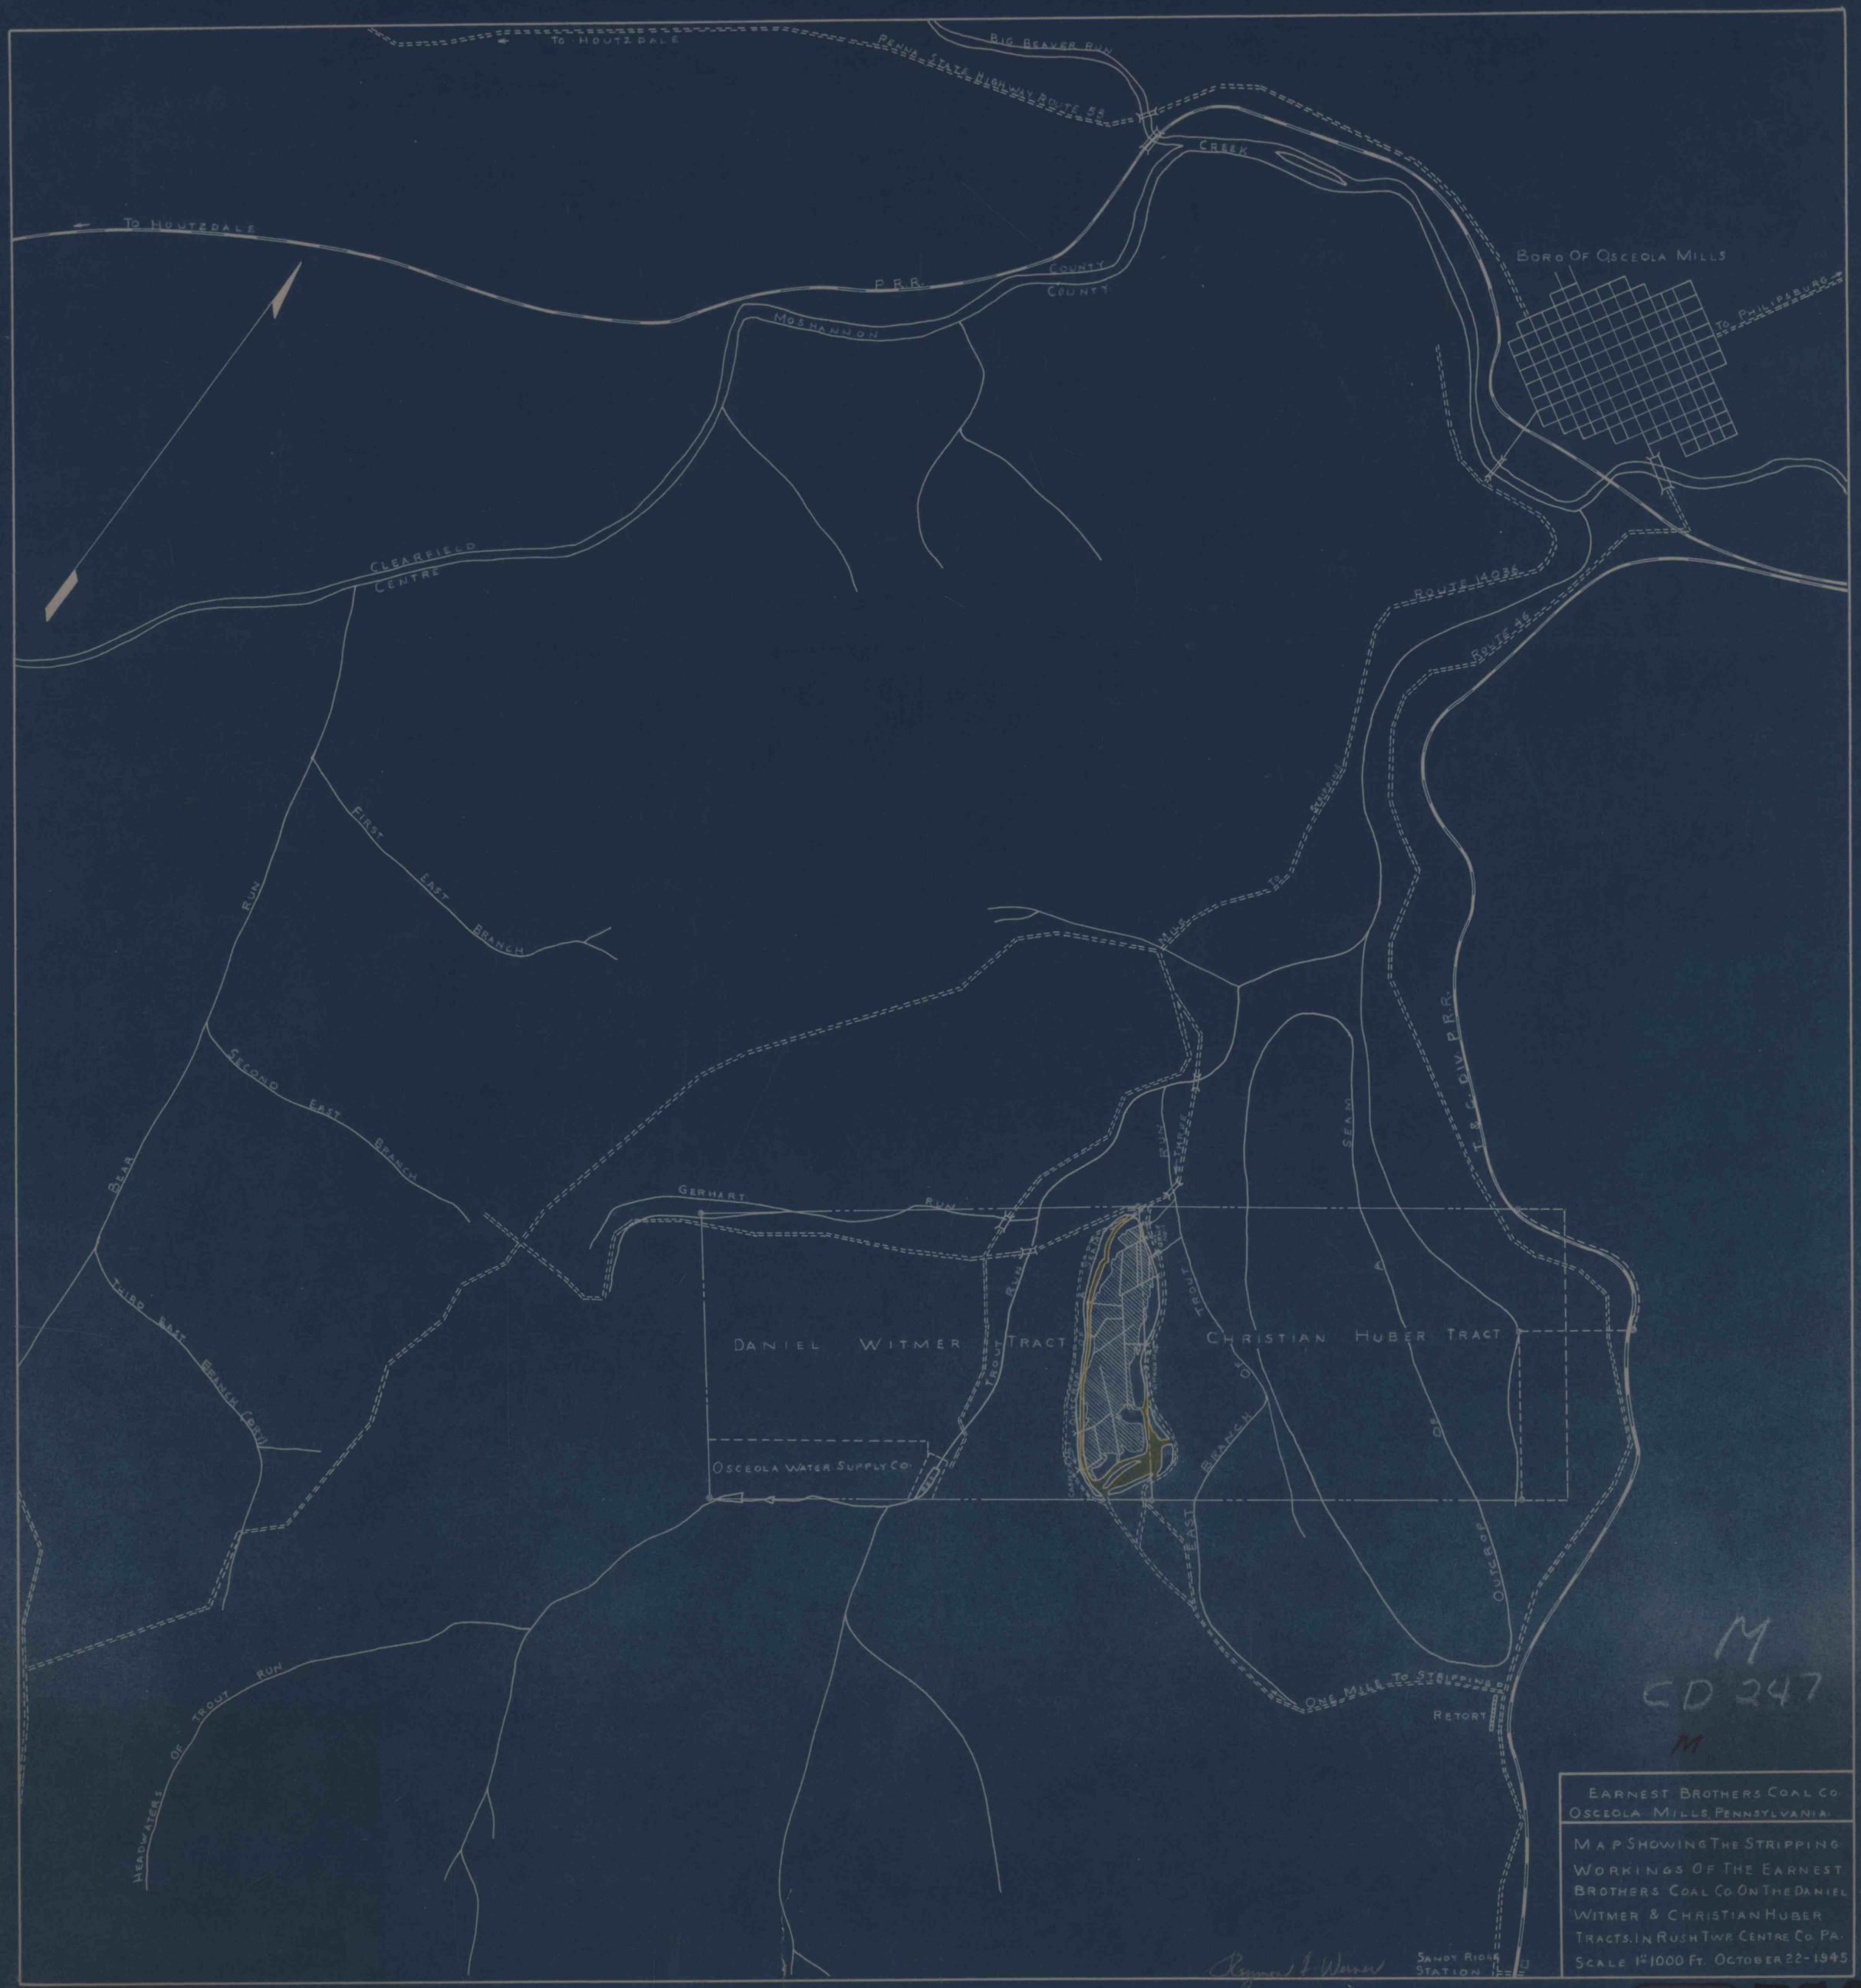

Earnest Brothers Coal Co.
Osceola Mills, Pennsylvania.

Map Showing The Stripping Workings Of The Earnest Brothers Coal Co On The Daniel Witmer & Christian Huber Tracts. In Rush Twp. Centre Co. Pa.
Scale 1" = 1000 Ft. October 22 - 1945

Reynard J. Werner

M
CD 247
M

C.D. 247 3551