


5461

MAP OF COAL LANDS
BAER ESTATE.
 SITUATE IN
 SOMERSET TWP., SOMERSET CO., PA.
 Scale 1"=1000' A.B. CRIGHTON June 1920
 Mining Engineer
 Johnstown Pa.

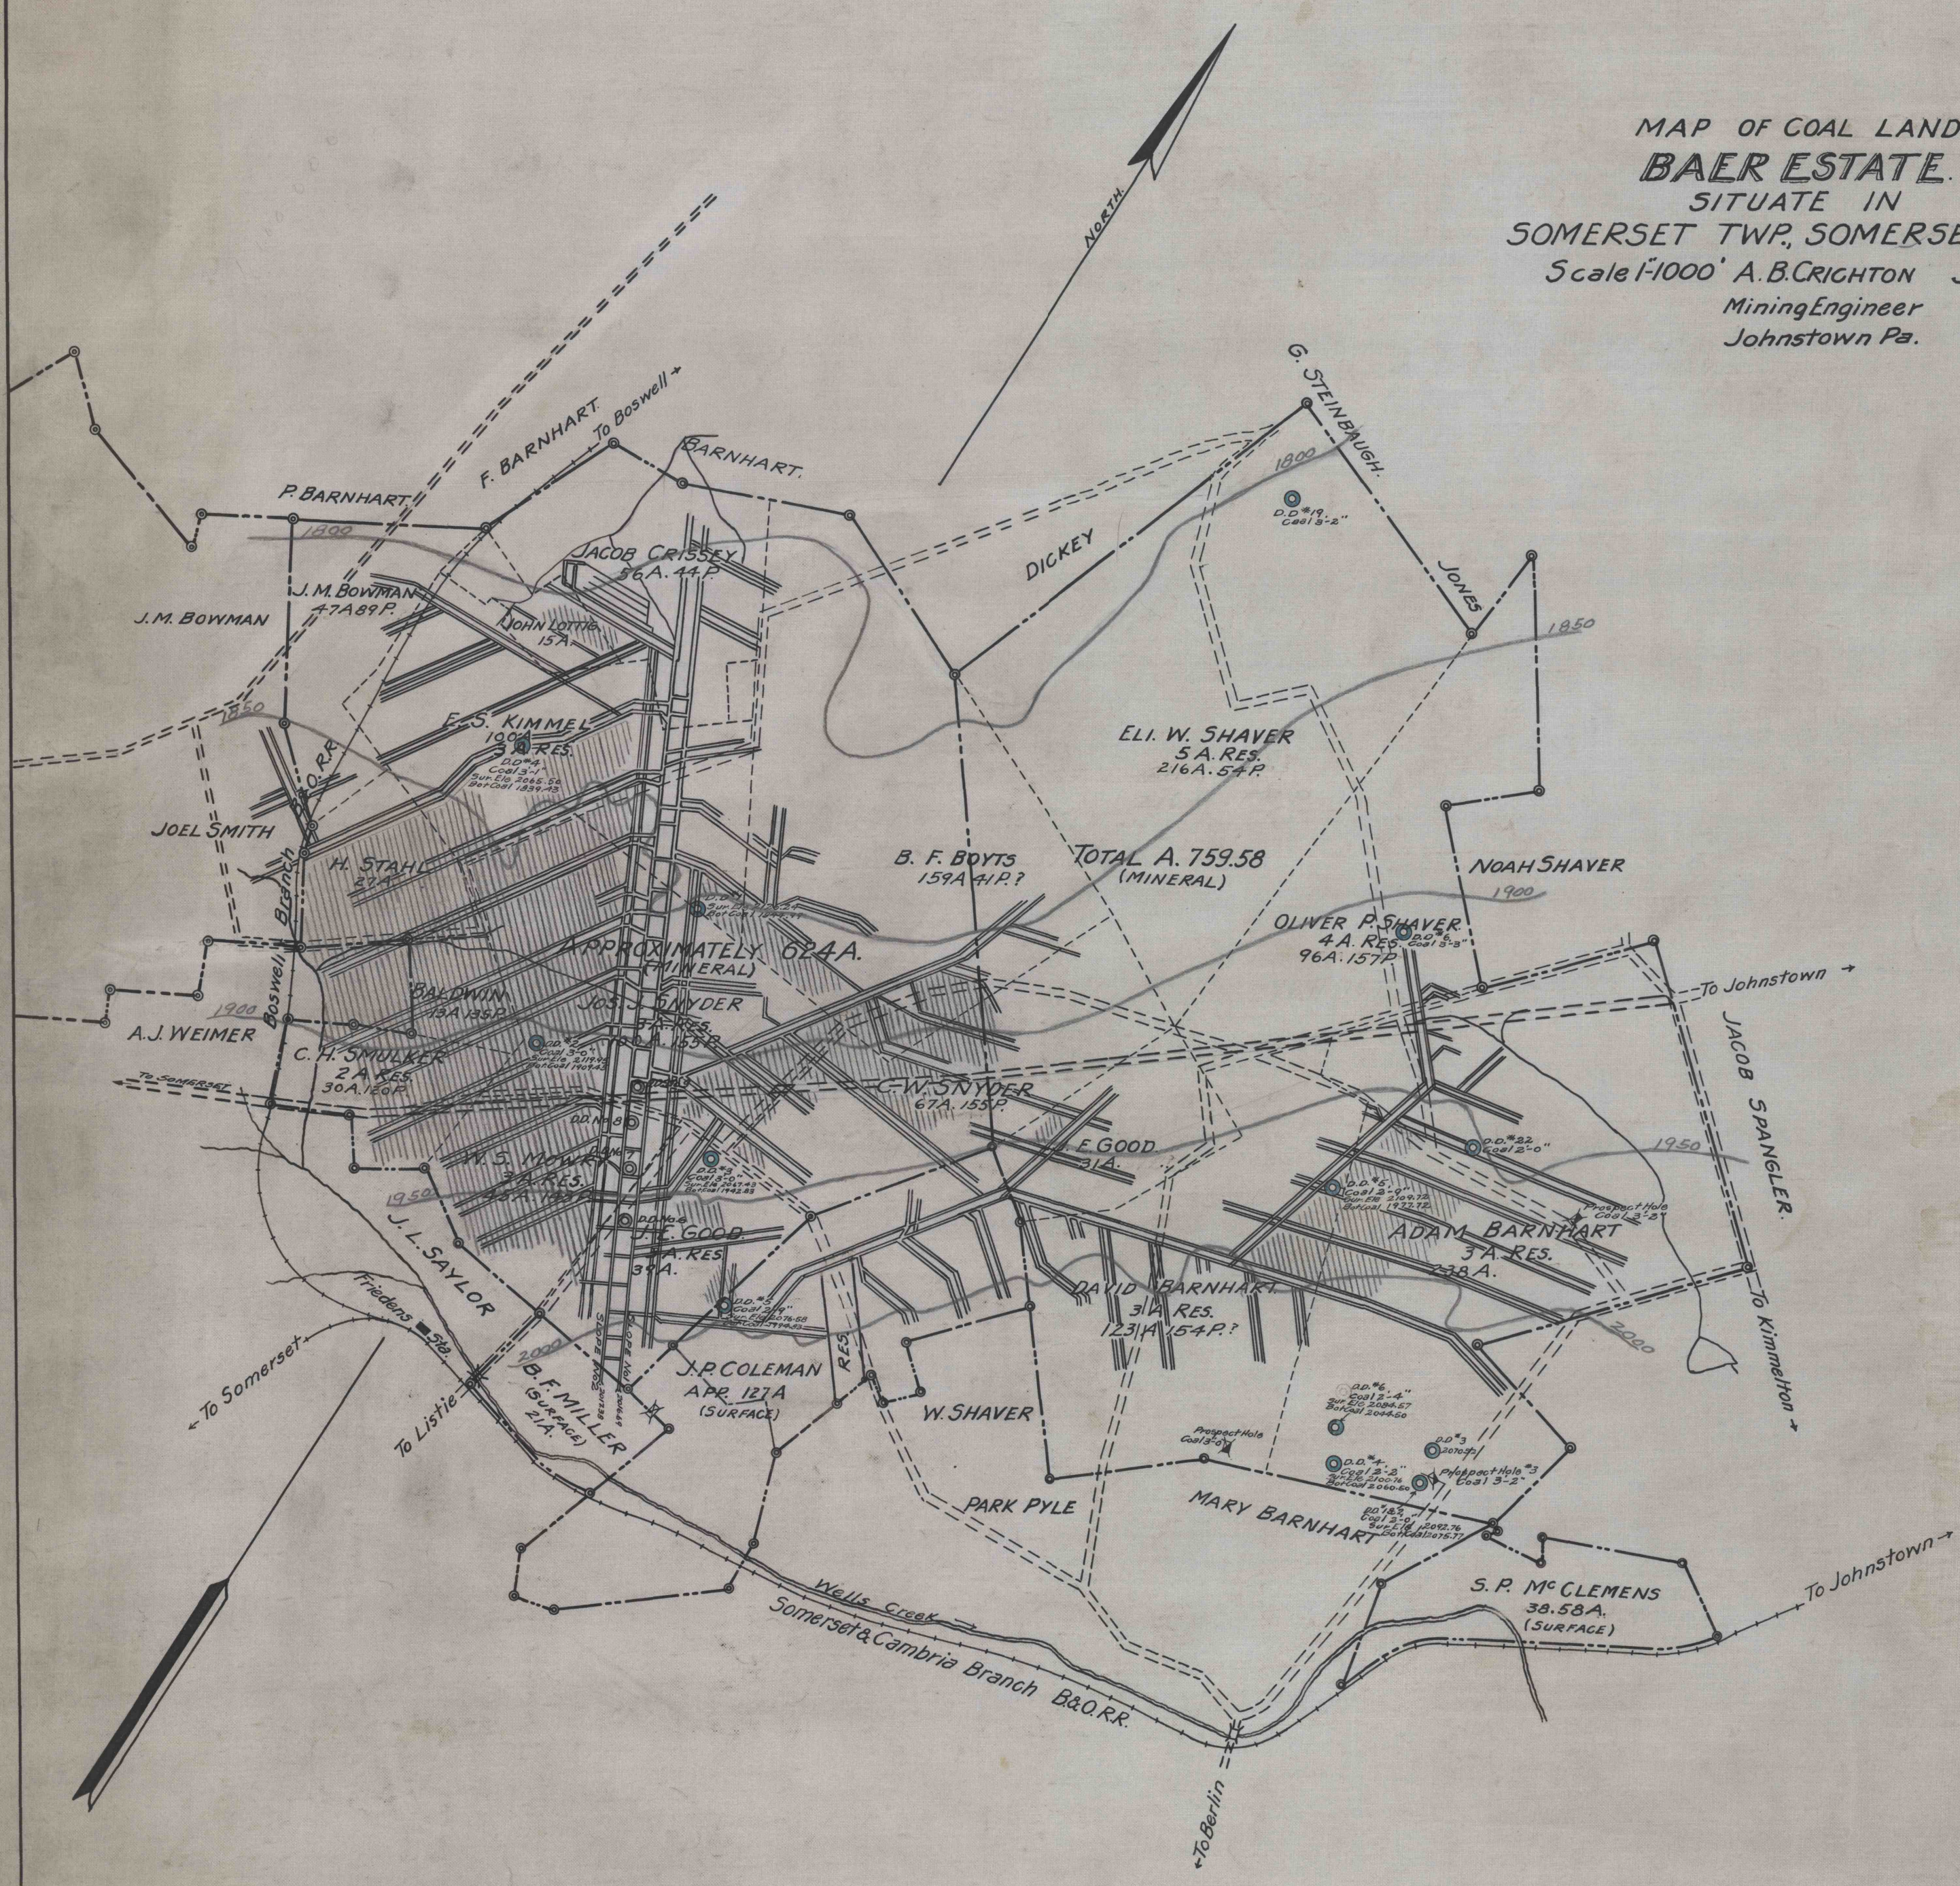

1842