CAMBRIA MINING & MANUFACTURING COMPANY

CAMBRIA MINING & MANUFACTURING COMPANY

~~LOGAN COAL CO.~~

~~FAUXHALL COAL CO.~~

PROPERTY MAP

OF LANDS IN

CROYLE-ADAMS & SUMMERHILL TWPS.

CAMBRIA COUNTY, PA.

Scale 1"=1000'

Andrew B. Crichton
Mining Engineer
Johnstown, Pa.
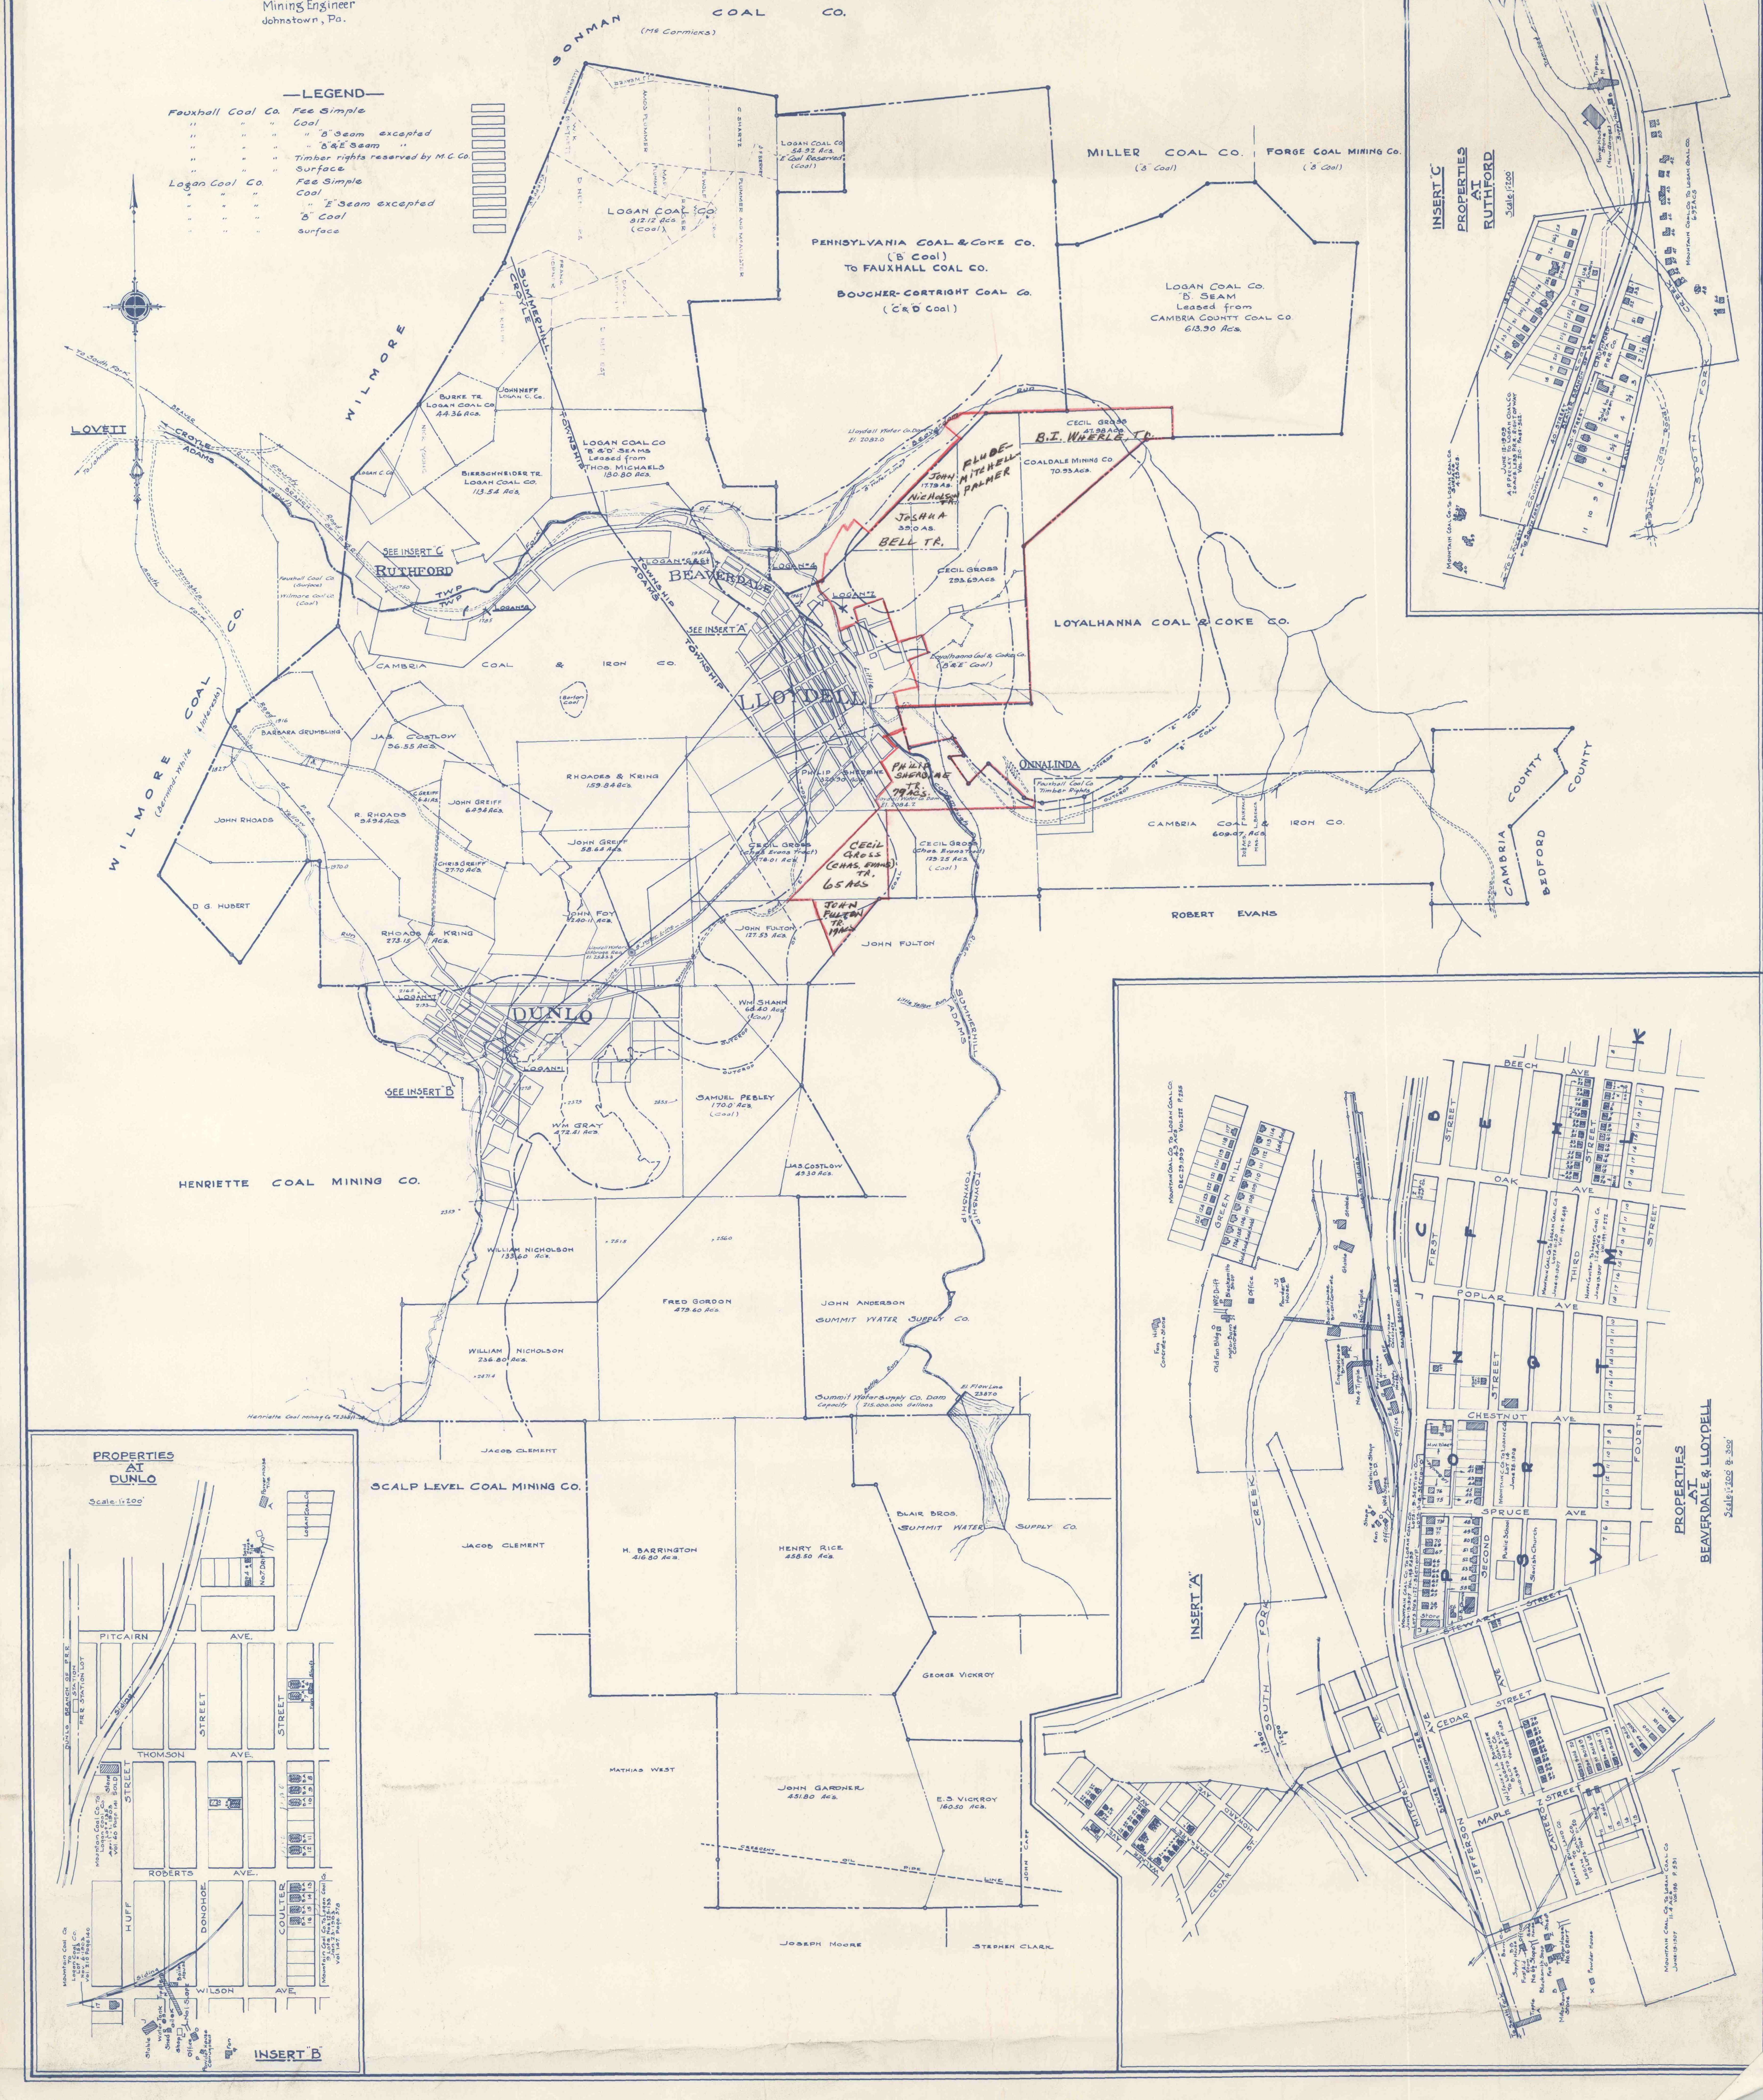
Combined Area Coal and Surface 9850.0 acres