


6884 D
8019

6819
D

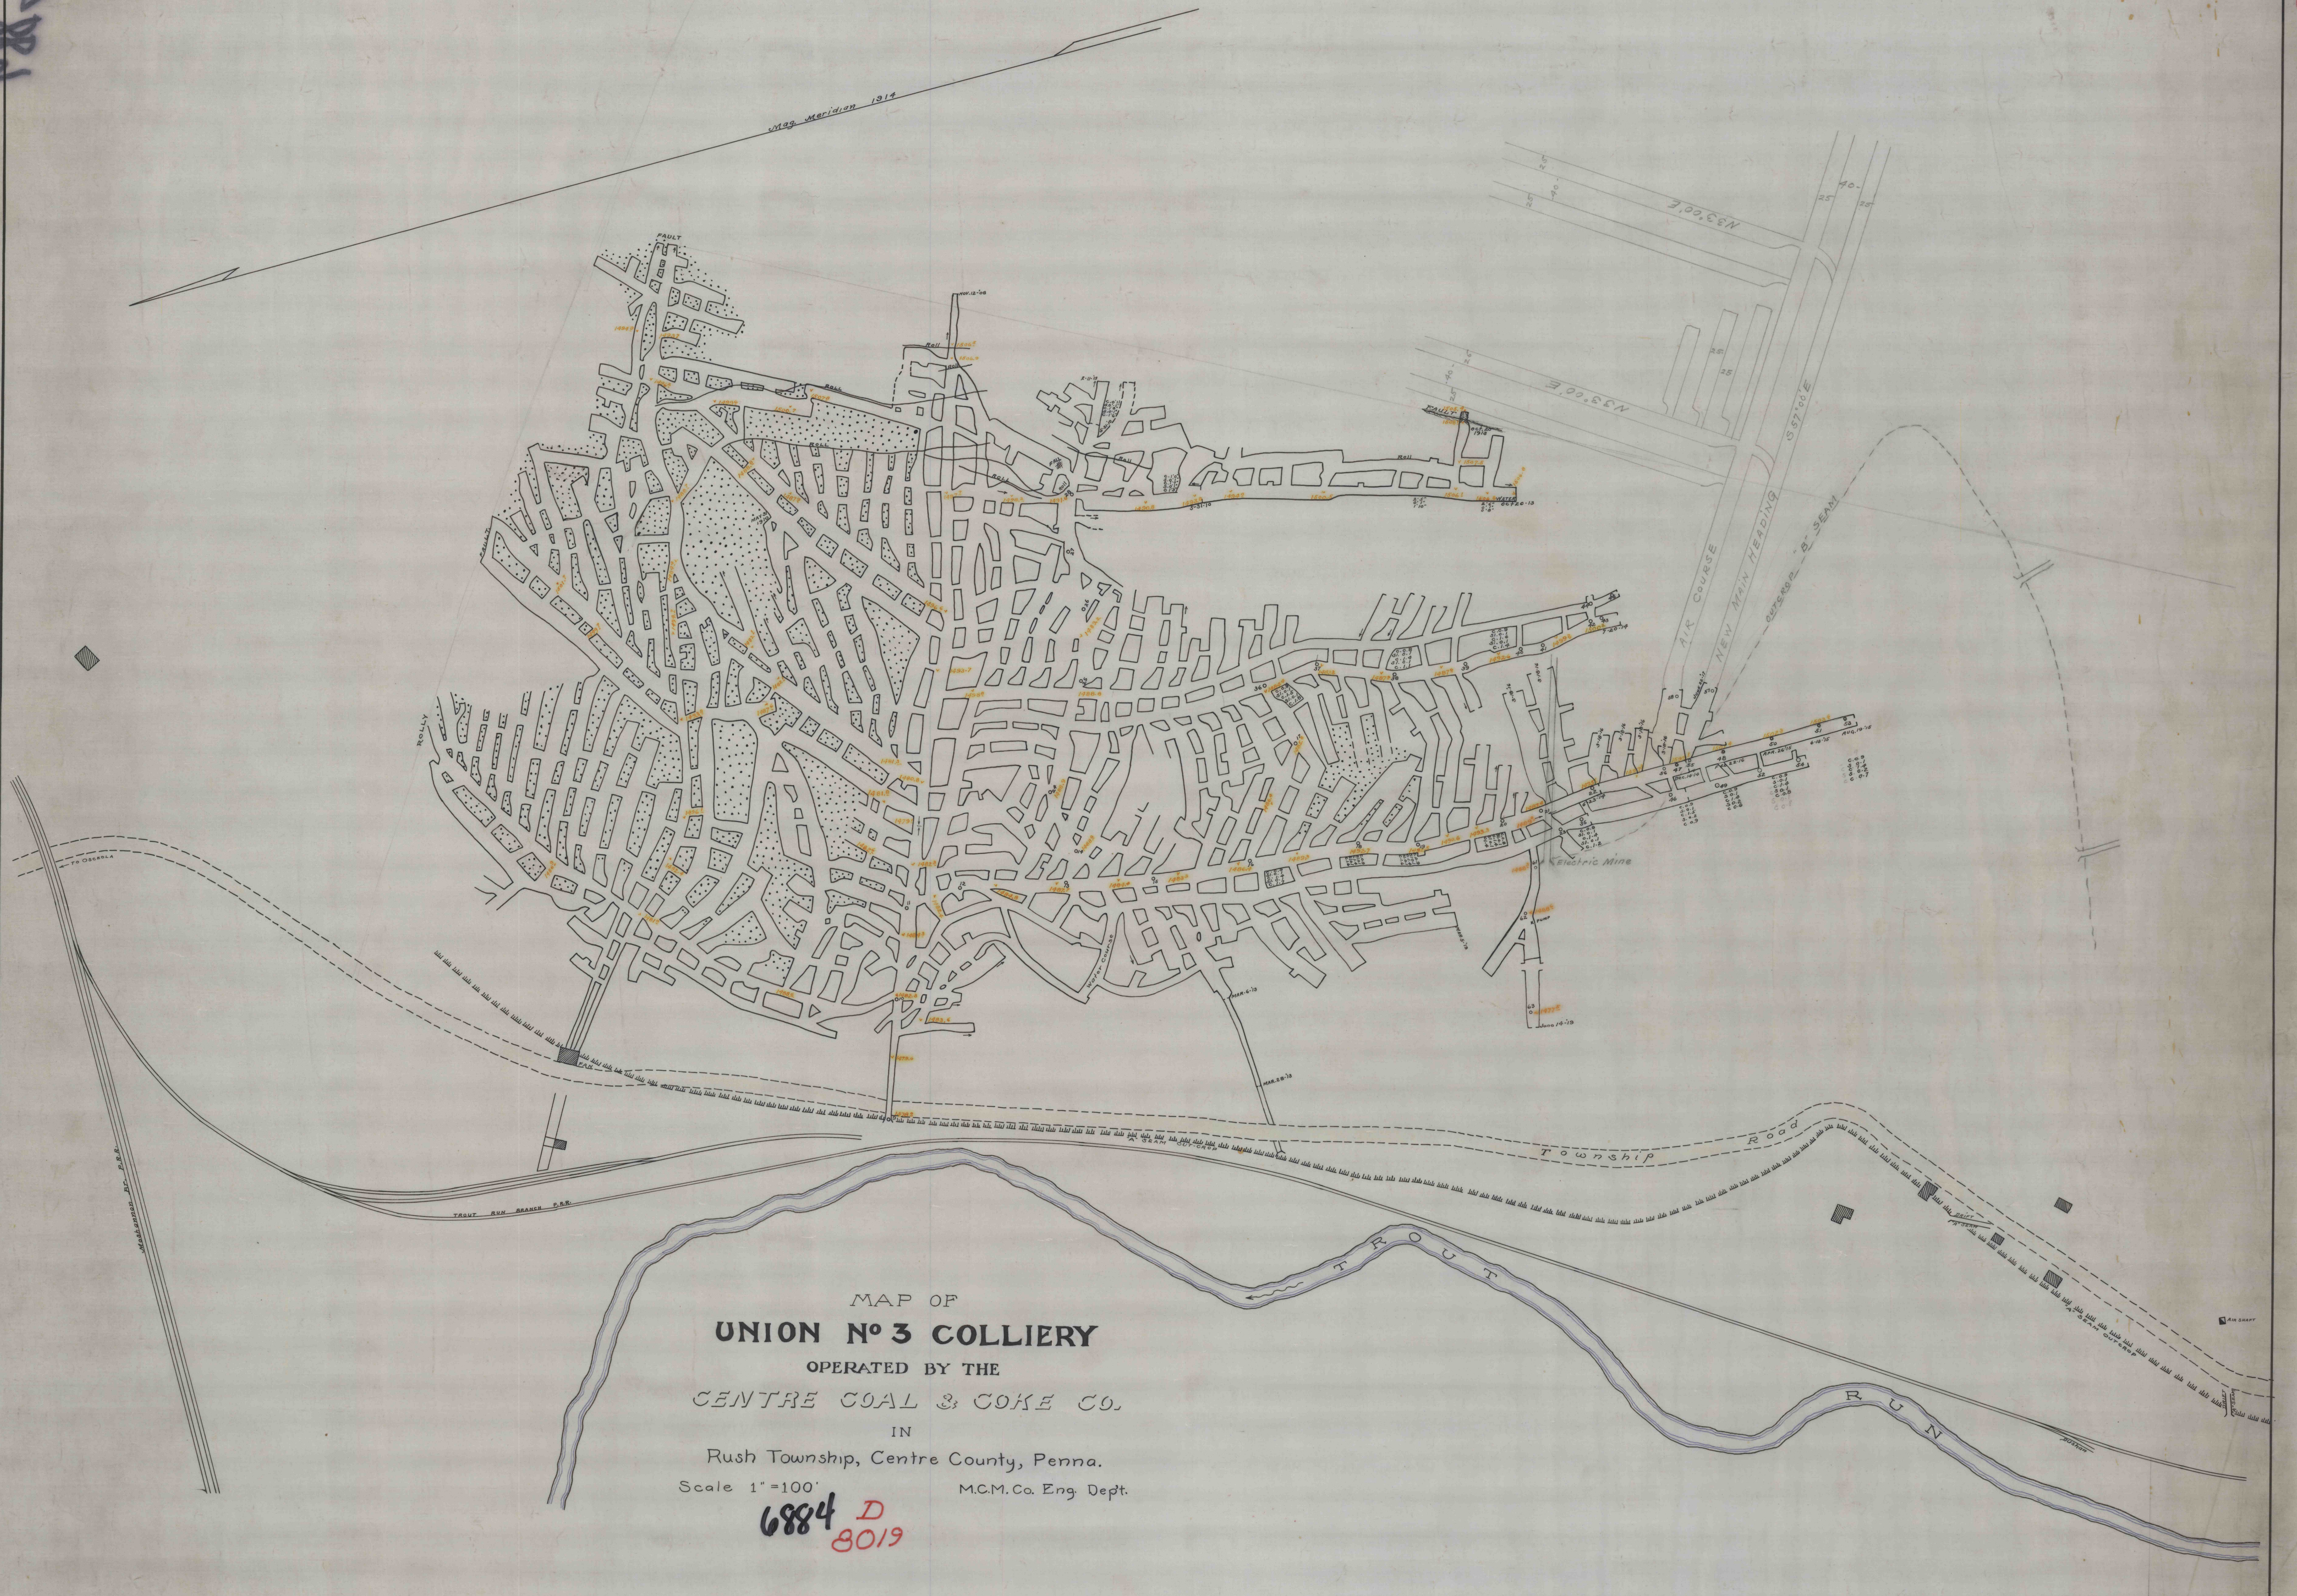

MAP OF
UNION NO 3 COLLIERY
 OPERATED BY THE
CENTRE COAL & COKE CO.
 IN
 Rush Township, Centre County, Penna.
 Scale 1"=100' M.C.M.Co. Eng. Dept.

6884 D
8019