



- ACTIVE OIL WELL
- ◆ ABANDONED OIL WELL
- * ACTIVE GAS WELL
- ✱ ABANDONED GAS WELL
- NO RECORD
- ▲ ACTIVE OIL & GAS WELL
- ✱ ABANDONED OIL & GAS WELL
- ◇ DRY HOLE
- NO RECORD
- COUNTY LINES
- - - TOWNSHIP LINES
- - - BOROUGHS LINES
- 980 of COAL CONTOURS
- 980 of CROP LINES - SEAMS BEING MINED
- 980 of CROP LINES - SEAMS NOT BEING MINED

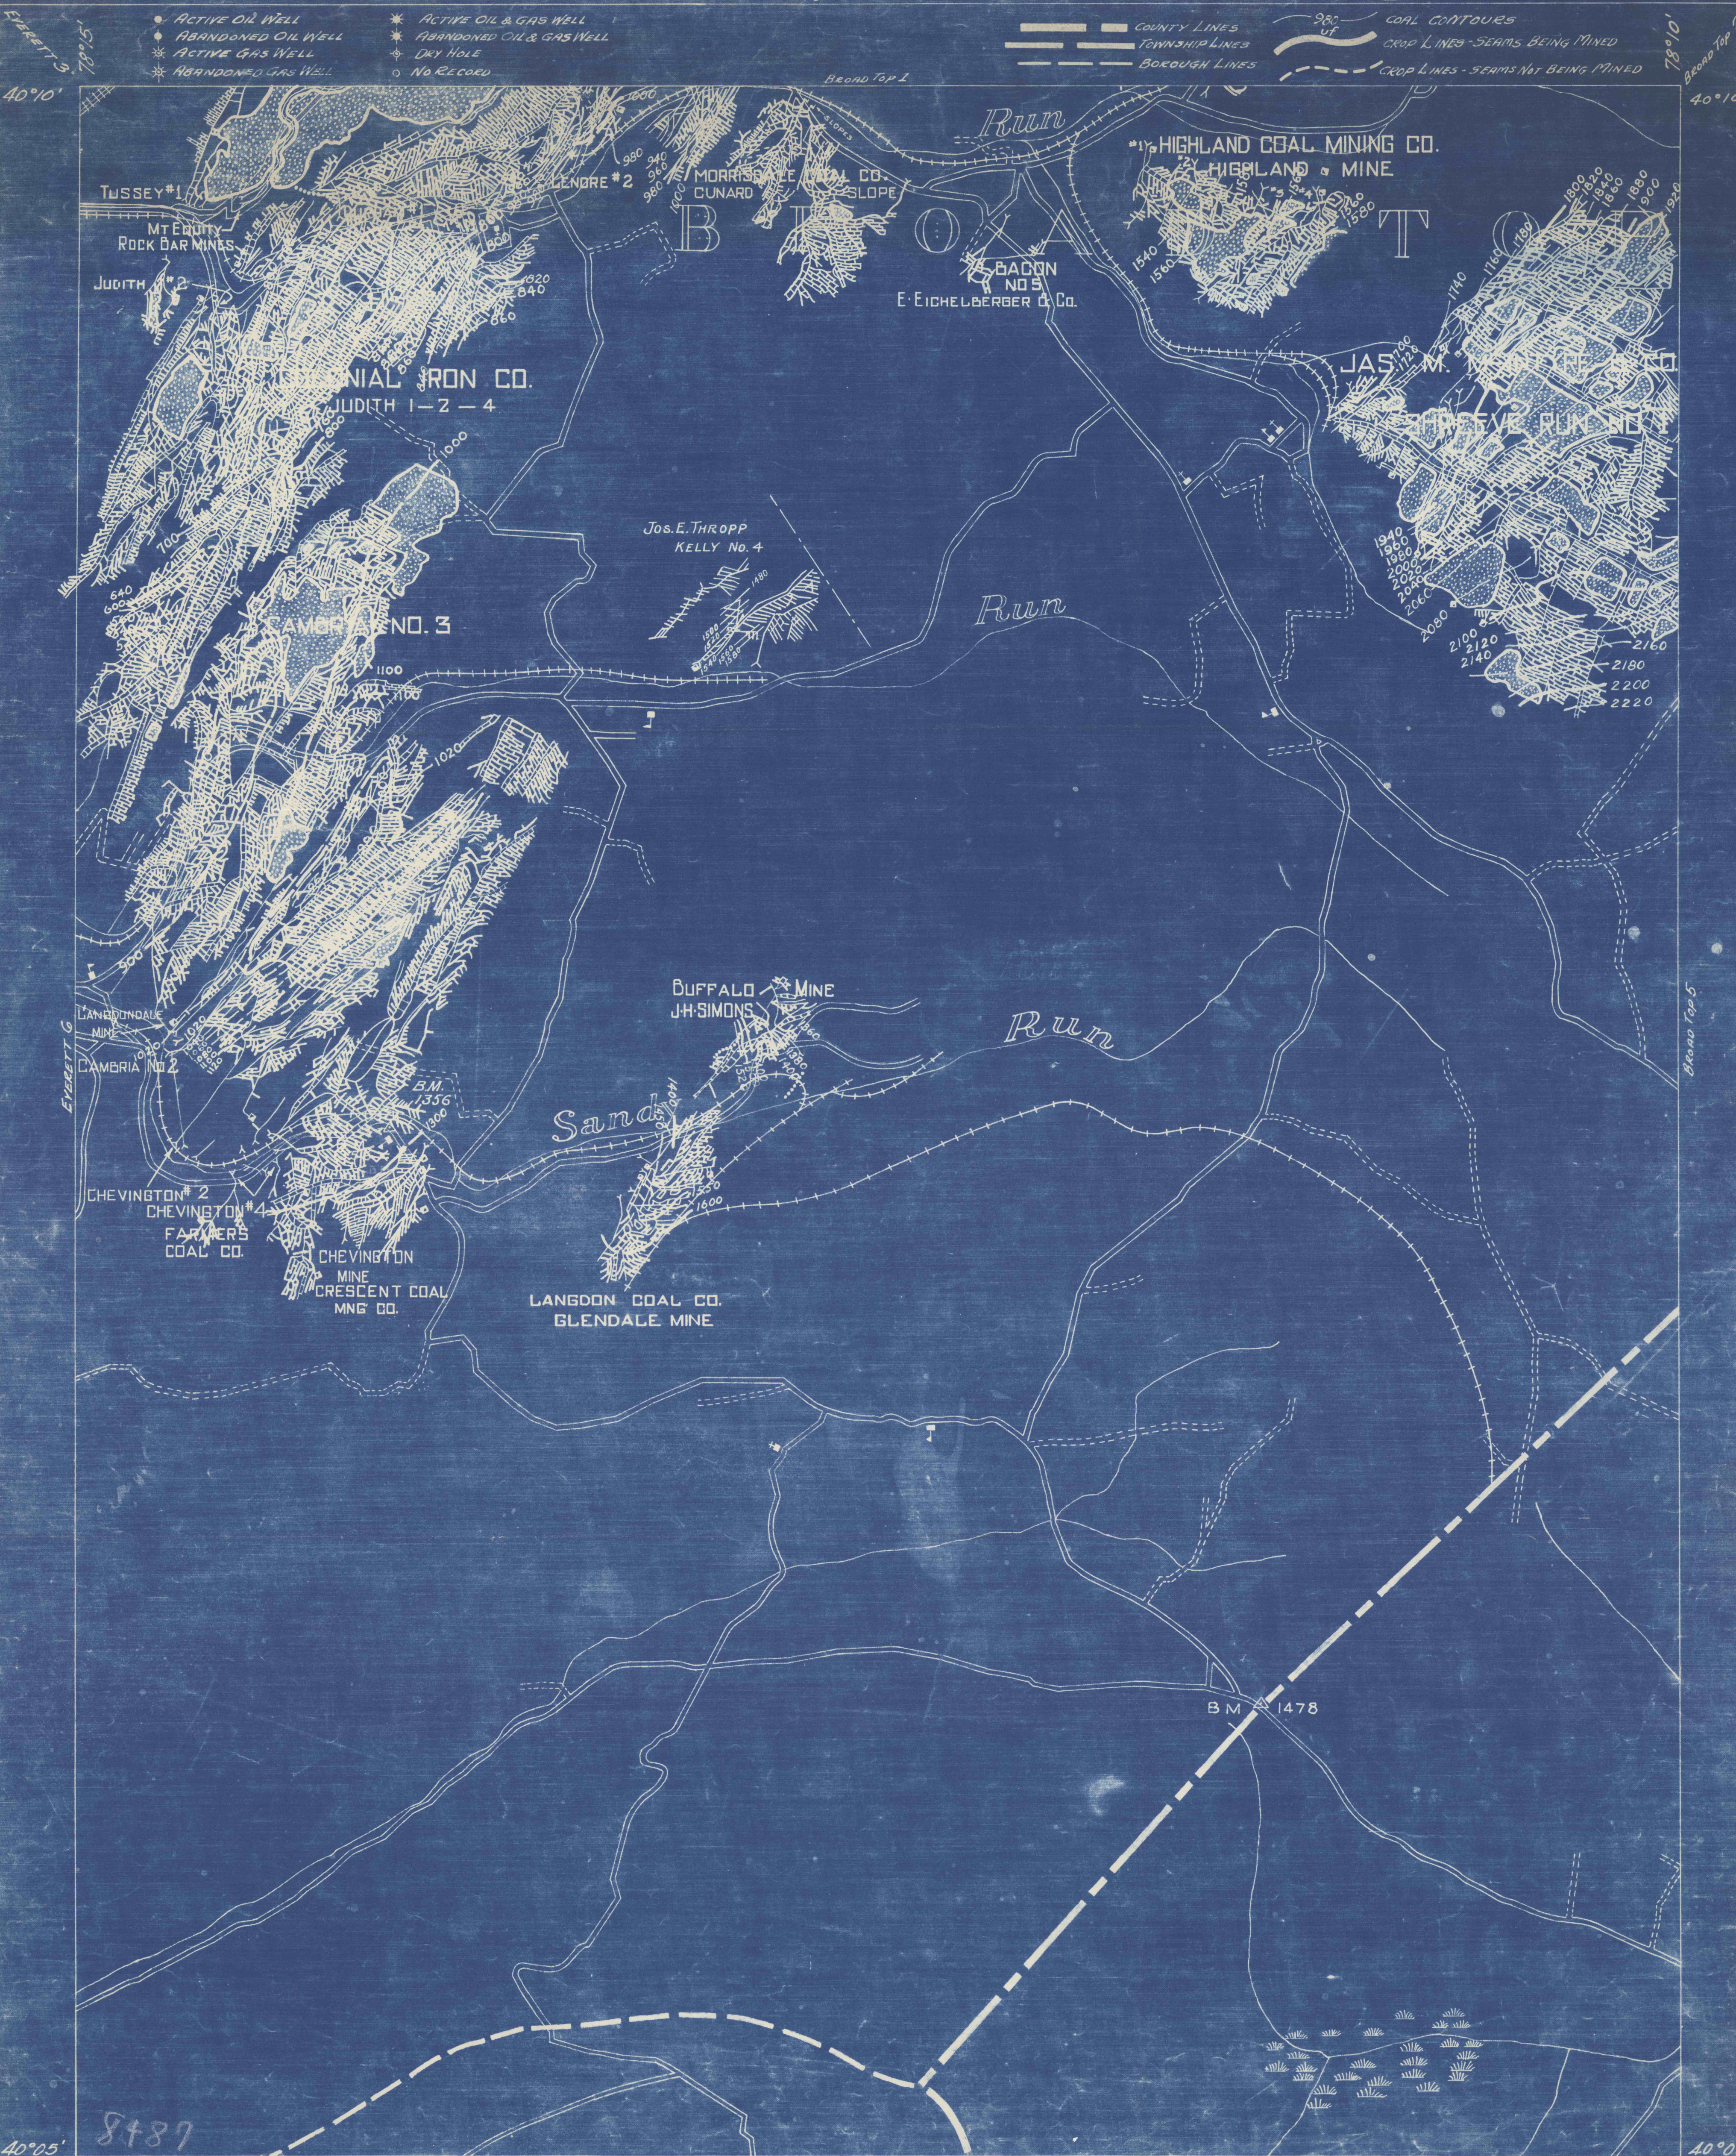

- DRIFT OPENING
- SLOPE OPENING
- SHAFTS
- ▨ BARRIER PILLAR



W.P.A. PROJECT NO 4483

BROAD TOP SHEET No. 4
Kelly Seam (Upper Freeport uf.)

B.T.-4