


SHAWMUT MINING CO  
 LANDS OF SHAWMUT MINING CO.  
 - II -  
 Horton Twp. ~ Elk Co. Pa.  
 1" = 1000'  
 Numbers of Tracts are Part of Jones Pocket Numbers  
 Revised July 1908

SHAWMUT  
 Lands of Shawmut Mining Company  
 Horton Twp. ~ Elk Co. Pa.  
 1" = 1000'  
 Numbers of Tracts are Part of Jones Pocket Numbers  
 Revised July 1908

Number, Date, Scale, Traced by, Corrected  
 2-405-1  
 1908  
 2-11-1  
 W. J. ...

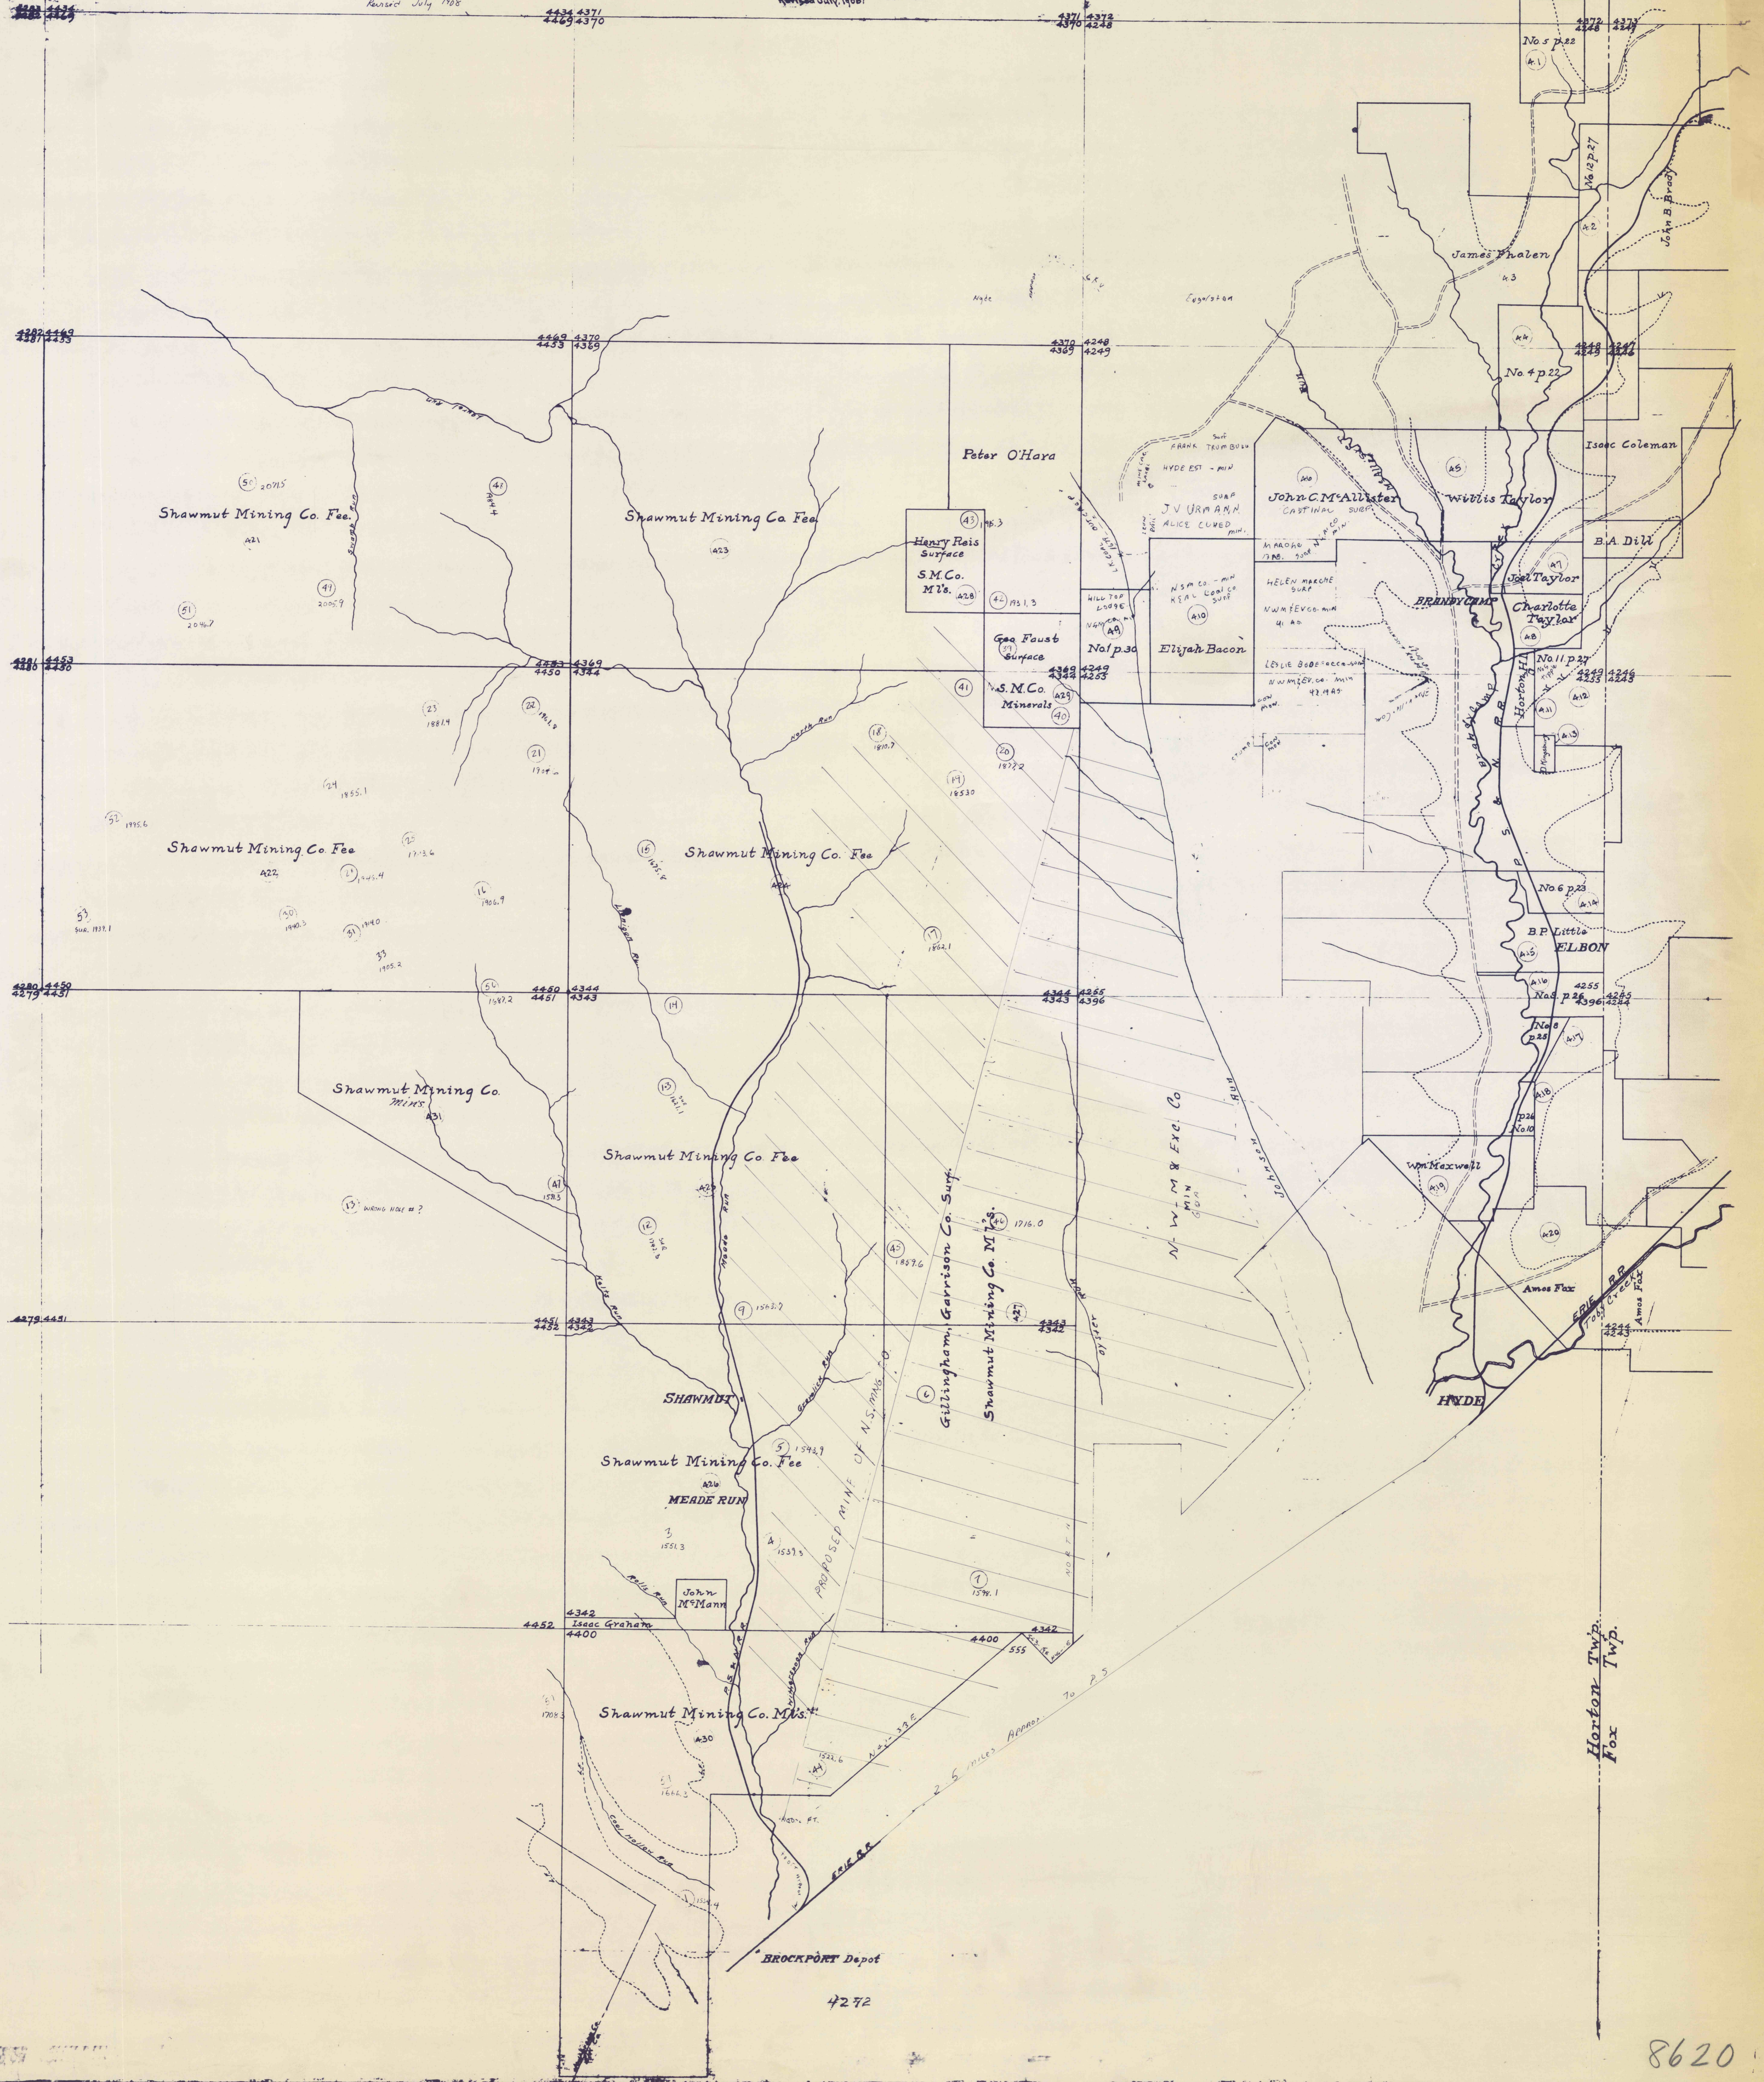

Horton Twp.  
 Fox