


WILLIAM CRICHTON JR
 AND
 FAUXHALL COAL CO.
 'E' SEAM PROPERTY 1870-1912
 ADAMS-CROYLE-SUMMERHILL TWPS
 SCALE 1"=1000' A.B. CRICHTON DECEMBER 1911
 MINING ENGINEER
 JOHNSTOWN, PA.

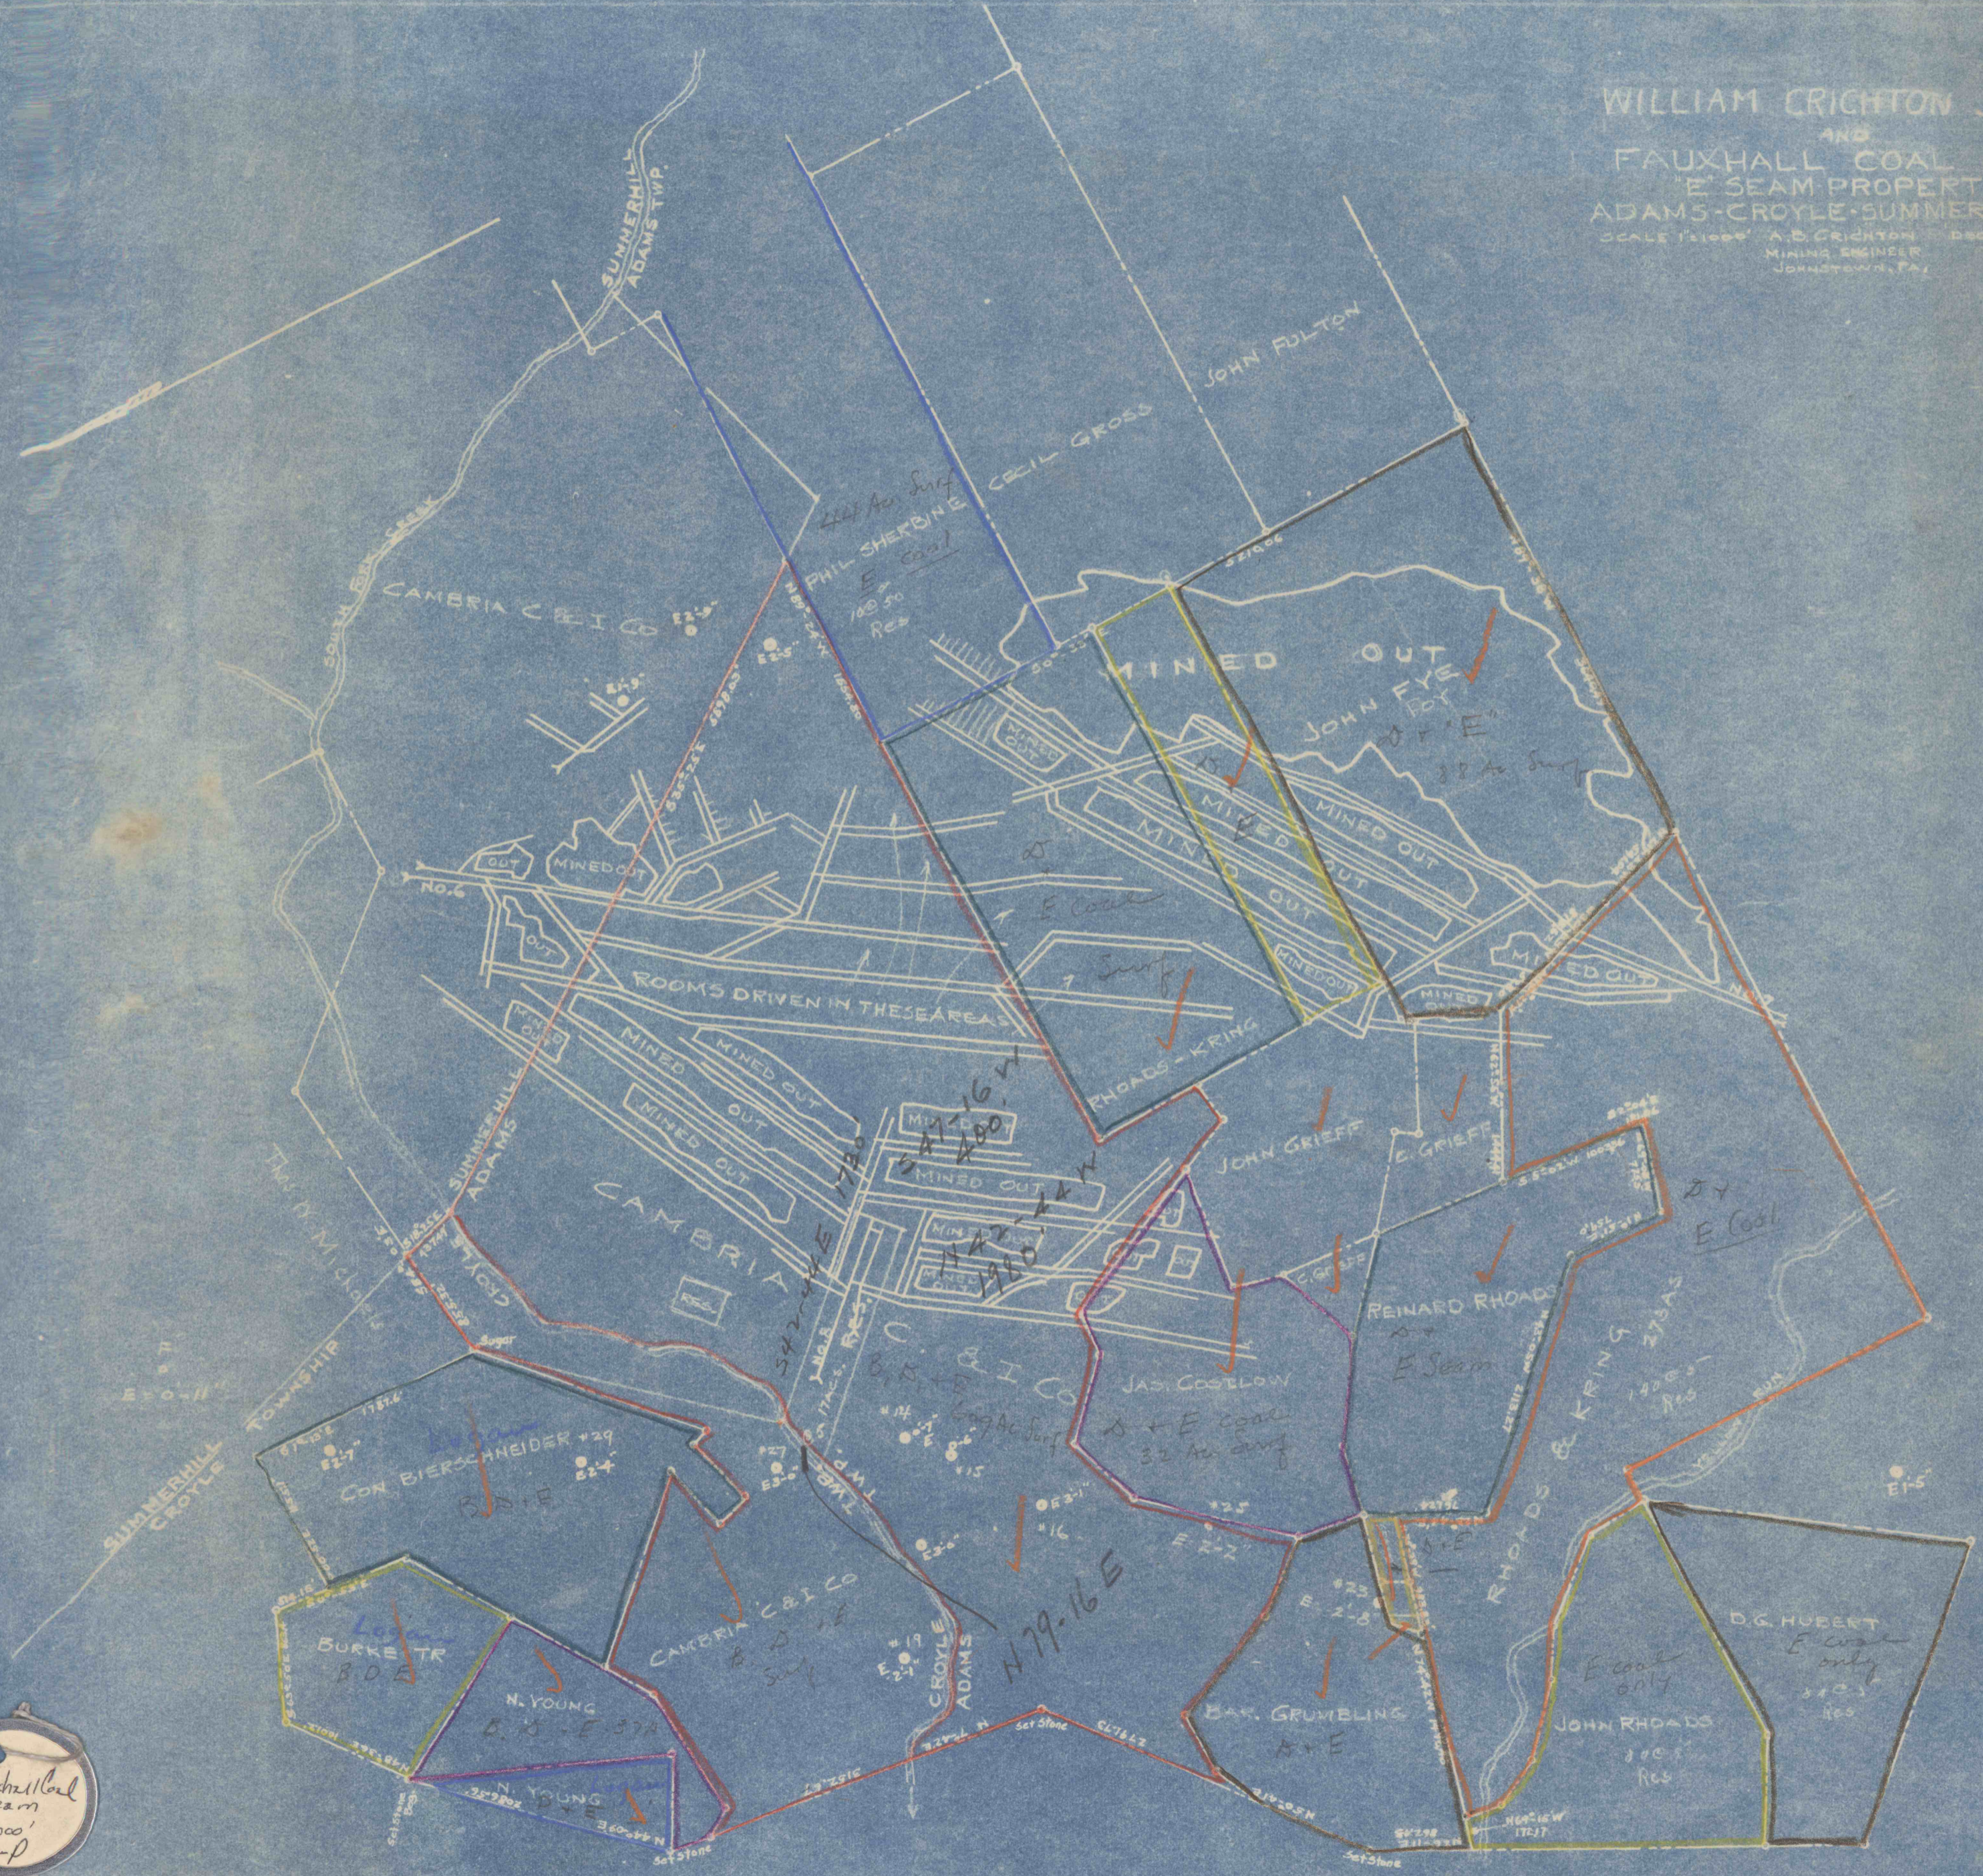

Fauxhall Coal
 'E' Seam
 1"=1000'
 M-P